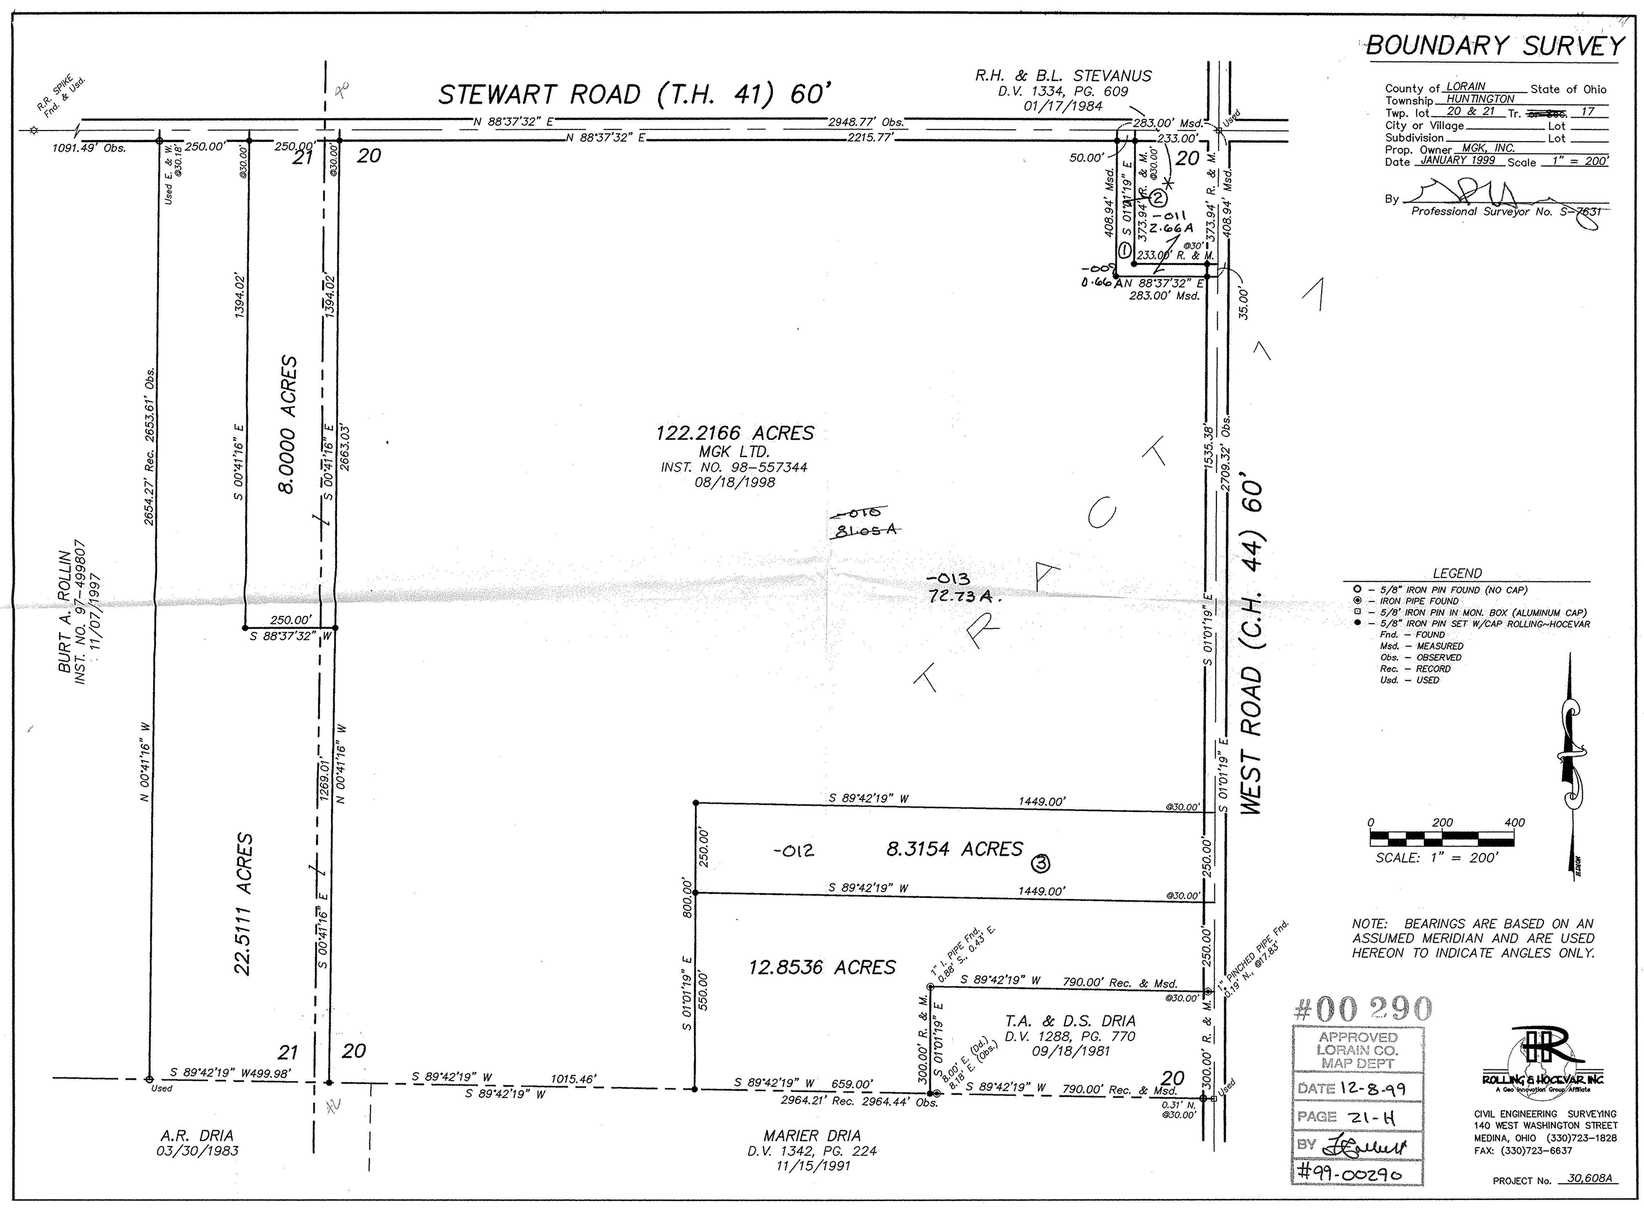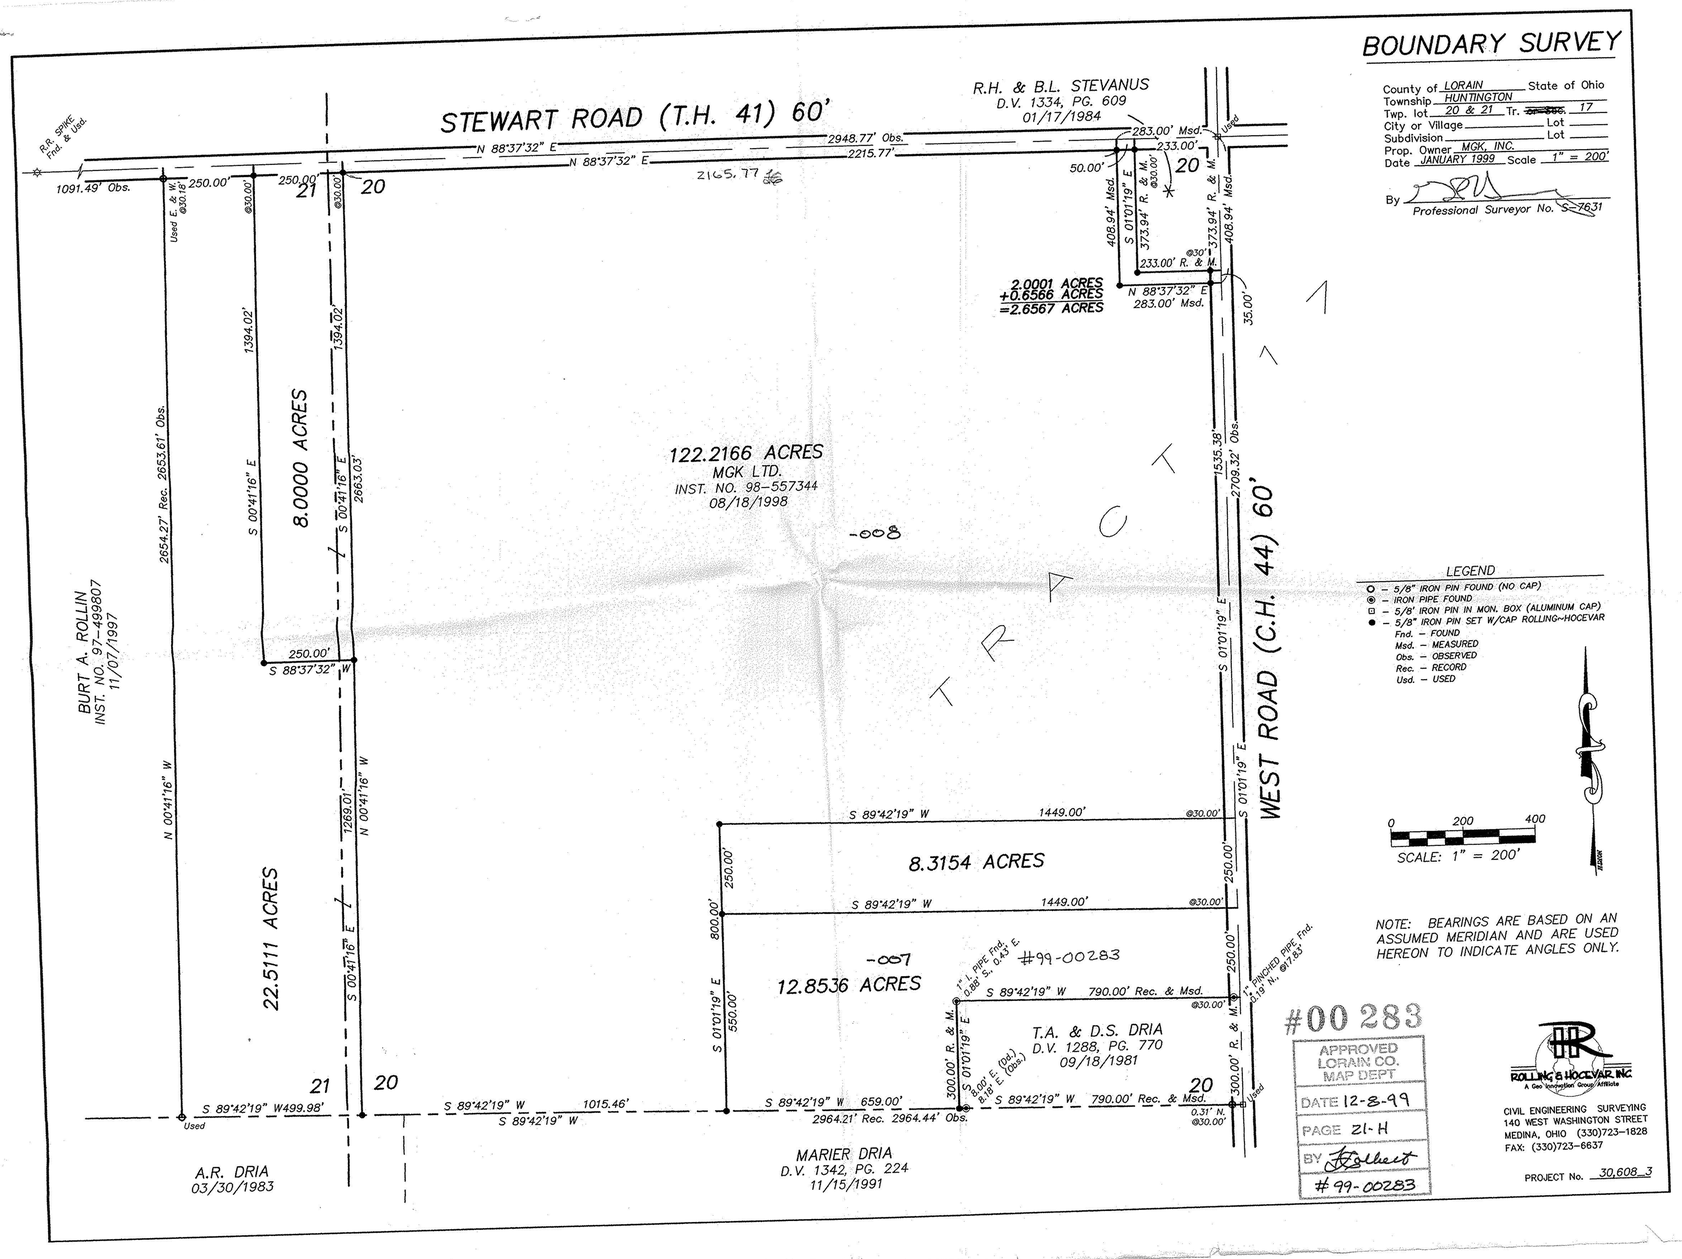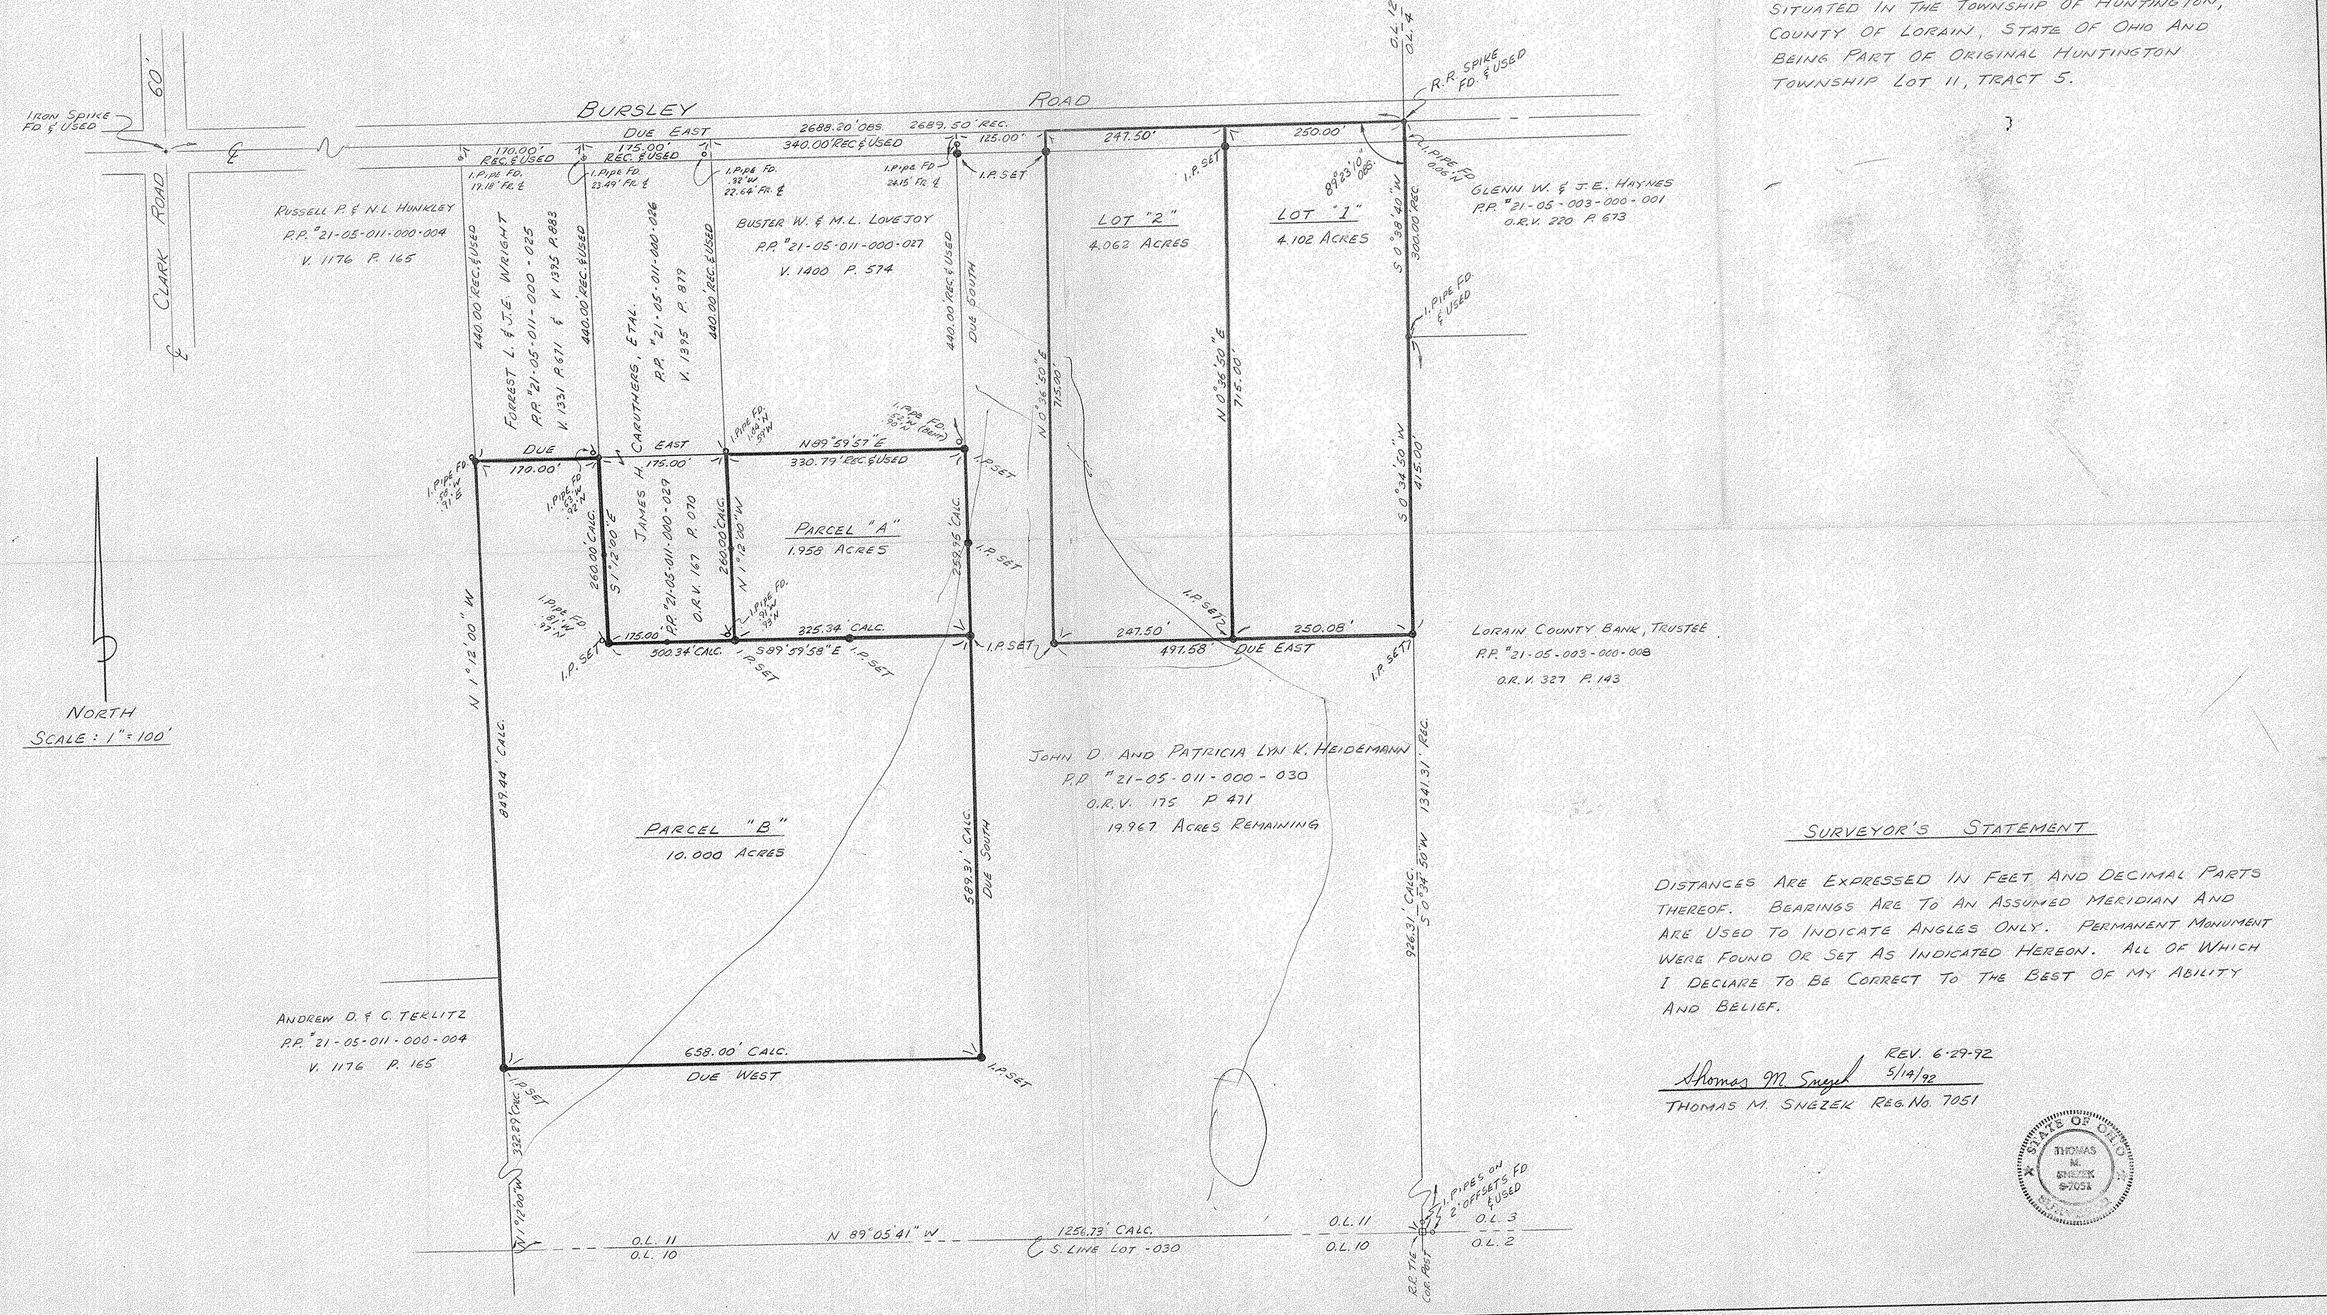P.P. NO.	
21-17-020-000-007 ~~[illegible]~~ + 008	
SPLIT #	DATE OF SURVEY
99-00283	JANUARY 1999
MAP PAGE	
21-H.	
SURVEYOR	
GUY P. HANEY