MAP OF SURVEY, LOT SPLIT AND ASSEMBLY

PREPARED FOR

ALAN J. AND JANET HAWLEY WACKER

SITUATED IN THE TOWNSHIP OF HUNTINGTON, COUNTY OF LORAIN, STATE OF OHIO
AND BEING KNOWN AS PART OF ORIGINAL HUNTINGTON TOWNSHIP TRACT 15

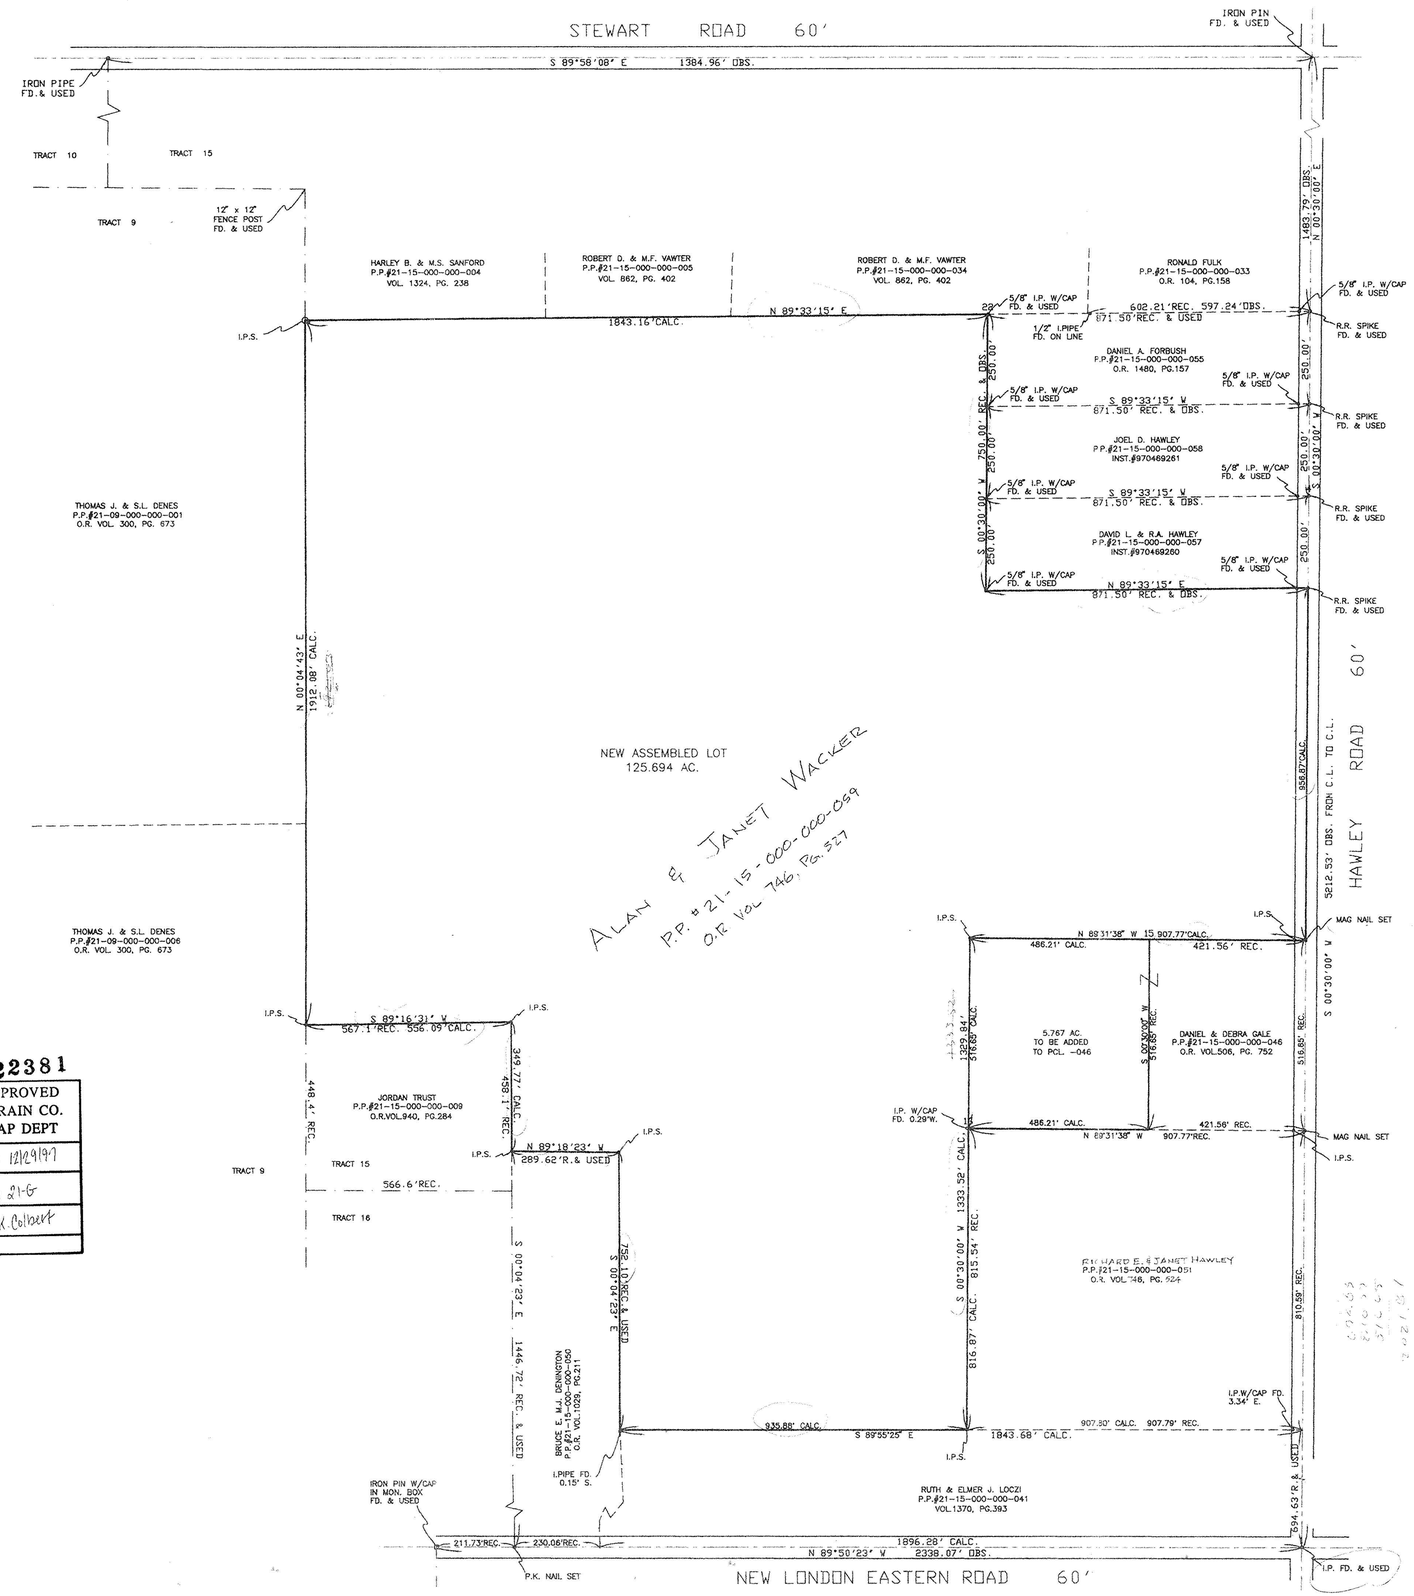

#22381

APPROVED LORAIN CO. MAP DEPT
DATE 12/29/97
PAGE 21-G
BY K.Colbert

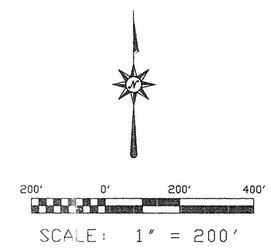

SURVEYOR'S STATEMENT

DISTANCES ARE EXPRESSED IN FEET AND DECIMAL PARTS THEREOF. BEARINGS ARE TO AN ASSUMED MERIDIAN AND ARE USED TO INDICATE ANGLES ONLY. PERMANENT MONUMENTS WERE FOUND OR SET AS INDICATED HEREON. POINTS MARKED —o— I.P.S. INDICATE 5/8" DIAMETER IRON PIN WITH CAP SET. ALL OF WHICH I DECLARE TO BE CORRECT TO THE BEST OF MY ABILITIES AND BELIEF.

THOMAS M. SNEZEK, P.S. #7051 — DATE

STATE OF OHIO — THOMAS M. SNEZEK #7051 — SURVEYOR

9715 - 9-20-97