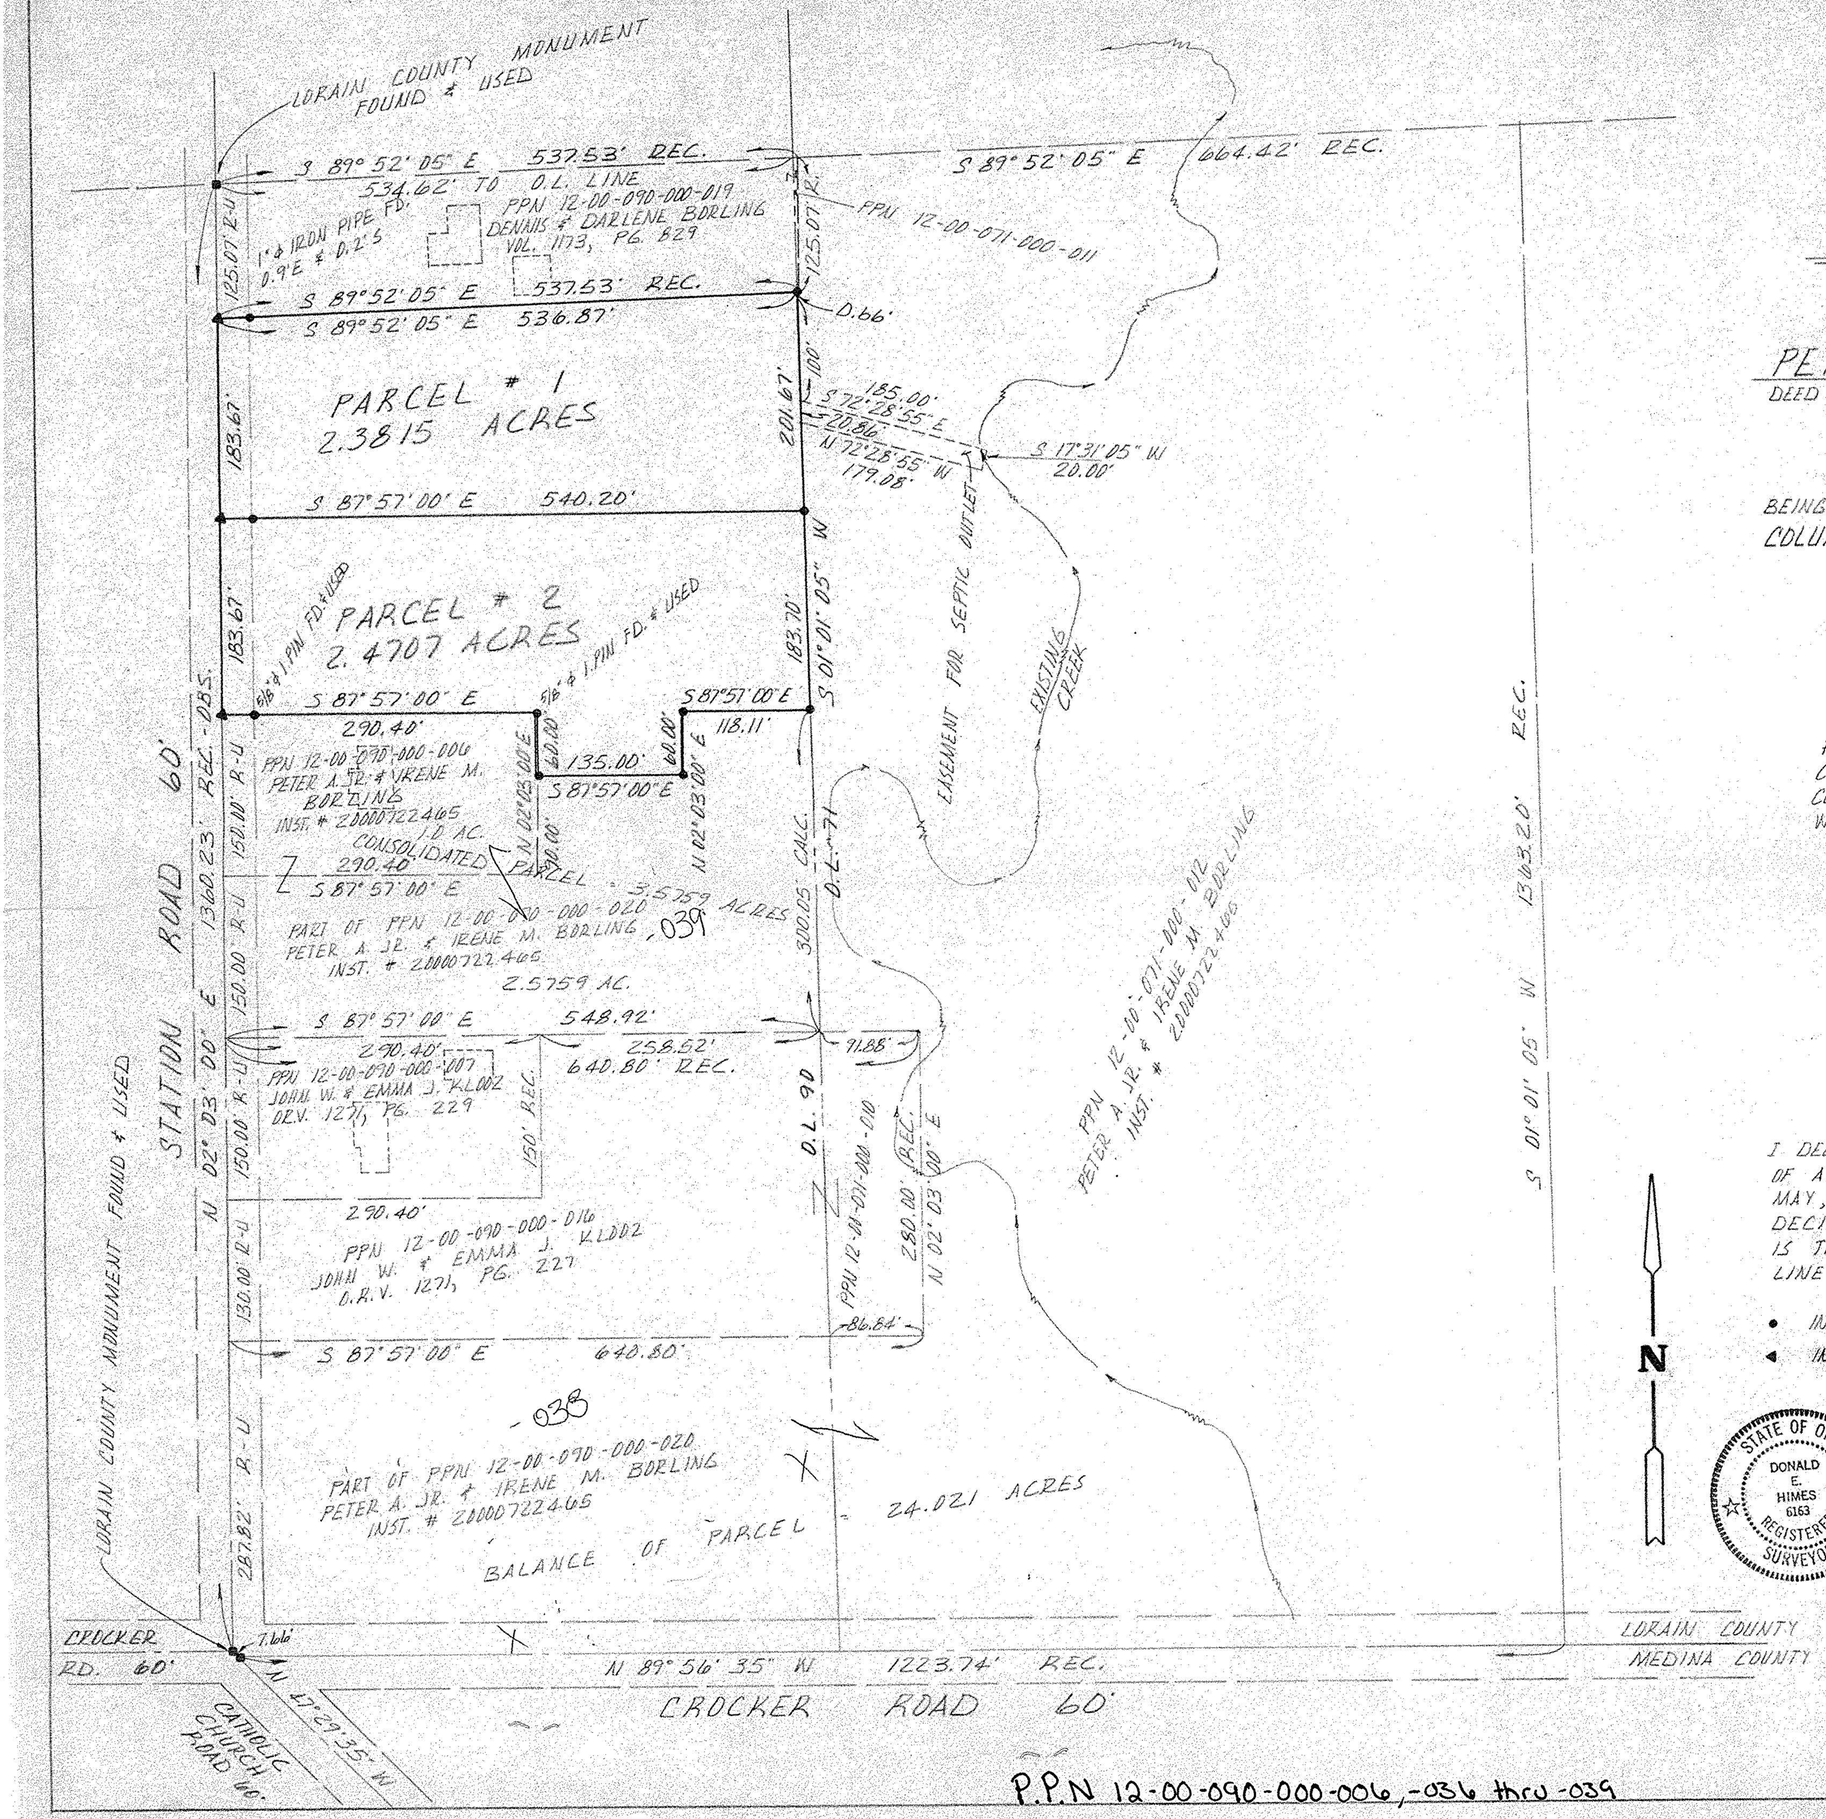

PLAT OF SURVEY

MADE FOR

PETER A. JR. & IRENE M. BORLING

DEED RECORDED IN INSTRUMENT Nº 20000722465

BEING PART OF ORIGINAL COLUMBIA TOWNSHIP LOT 90
COLUMBIA TOWNSHIP, LORAIN COUNTY, OHIO

REVISED MAY 28, 2002 PER LORAIN COUNTY PLANNING COMMISSION TO CONSOLIDATE PPN 12-00-090-000-006 WITH A PART OF PPN 12-00-090-000-020

No 01114

APPROVED
LORAIN CO.
MAP DEPT
DATE 6-18-02
PAGE 12-E
BY J Hatfield
02-01114

I DECLARE THIS PLAT TO BE A TRUE REPRESENTATION OF AN ACTUAL FIELD SURVEY MADE BY ME IN MAY, 2002. DISTANCES ARE GIVEN IN FEET AND DECIMAL PARTS THEREOF. NORTH DATUM USED IS THE BEARING OF RECORD FOR THE CENTER-LINE OF STATION ROAD.

- INDICATES 5/8" ϕ IRON PIN. 30" LONG. WITH "ZWICK" CAP. SET
- INDICATES "MAG" NAIL SET

STATE OF OHIO
DONALD E. HIMES
6163
REGISTERED SURVEYOR

5/20/02
5/20/02

DONALD E. HIMES, P.S. # 6163

ZWICK ASSOCIATES, INC.
ENGINEERS - SURVEYORS - PLANNERS
8750 STEARNS ROAD, OLMSTED TOWNSHIP, OHIO 44138
TEL.: 440-235-2729 FAX.: 440-235-0604

0' 50' 100' 150' 200' 300' 400'

SCALE: 1" = 100'

P.P.N 12-00-090-000-006, -036 thru -039