MEDINA COUNTY SURVEY REFERENCES N-92, I-91

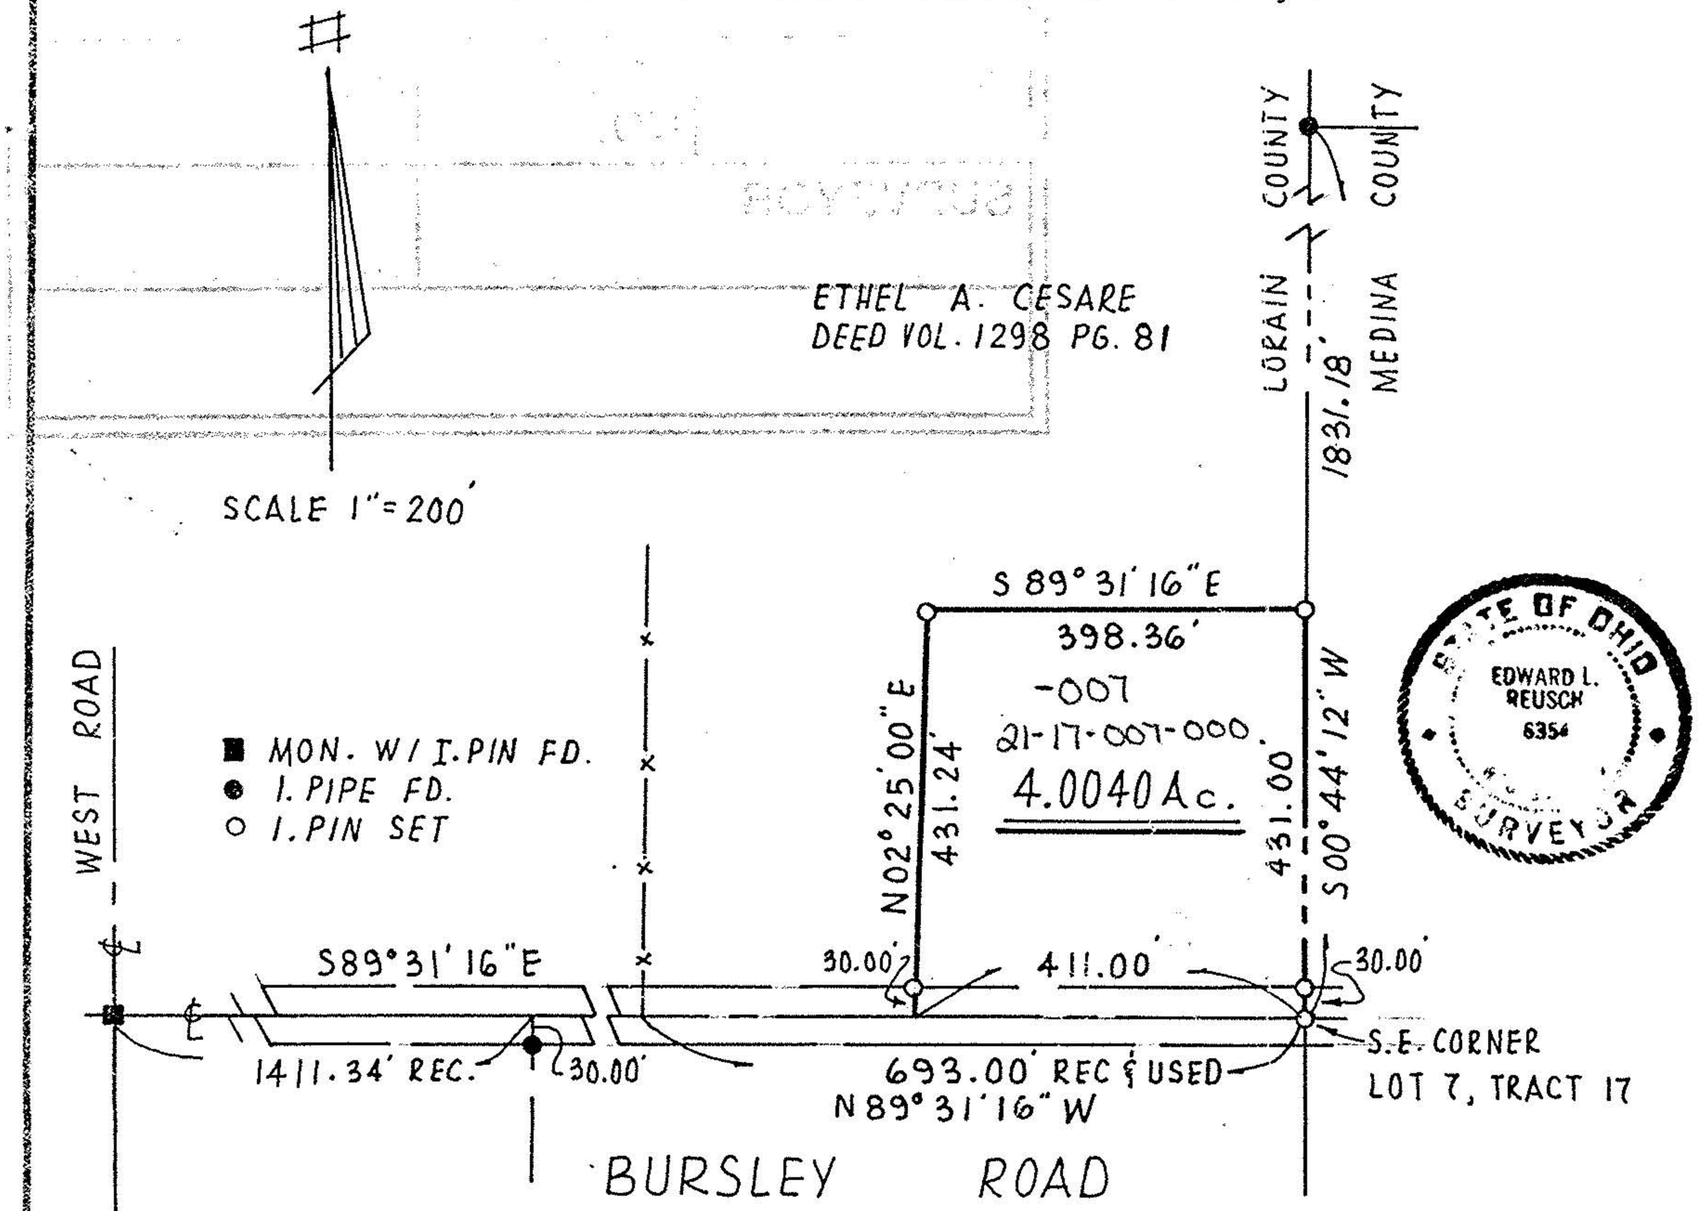

STATE OF OHIO
EDWARD L. REUSCH
6354
SURVEYOR

#15717
APPROVED
LORAIN CO.
MAP DEPT.
DATE 7-27-84
PAGE 21-D
BY T. McClain
VOID

LOT NO.: 7	Tr. or ~~Sec.~~: 17
TOWNSHIP: HUNTINGTON	
COUNTY: LORAIN	STATE: OHIO
OWNER: CESARE	
DATE: JULY, 20, 1984	SCALE: 1"=200'

REUSCH SURVEYING
1025 MEDINA ROAD, MEDINA, OHIO, 44256
Telephone: 216-239-2500

PROJECT NO. 84

Edward J. Reusch
REUSCH REG. SURVEYOR #6354

21-D