

TOTAL R/R 52.6899 AC,
 4.7897 AC,
 TOTAL ACRES REMAINING 47.9002 AC.

LEGEND
 ▲ RAILROAD SPIKE SET
 ● IRON PIN SET

(MARION J. CRILE)

(MESKAL, MICHAEL D.)

#14969

APPROVED
LORAIN CO.
MAP DEPT.

DATE 2-8-83


PAGE 21-6

BY C. Francis

VOID AFTER

GRINDLE AND BENDER
 ARCHITECTURE, ENGINEERING, SURVEYING
 P.O. BOX 660
 ASHLAND, OHIO 44805

PLAT OF SURVEY
 FOR
 DAVID WEYER
 OF LANDS BELONGING TO:
 MARION J. CRILE
 TRACT 14, HUNTINGTON TWP.
 LORAIN COUNTY, OHIO

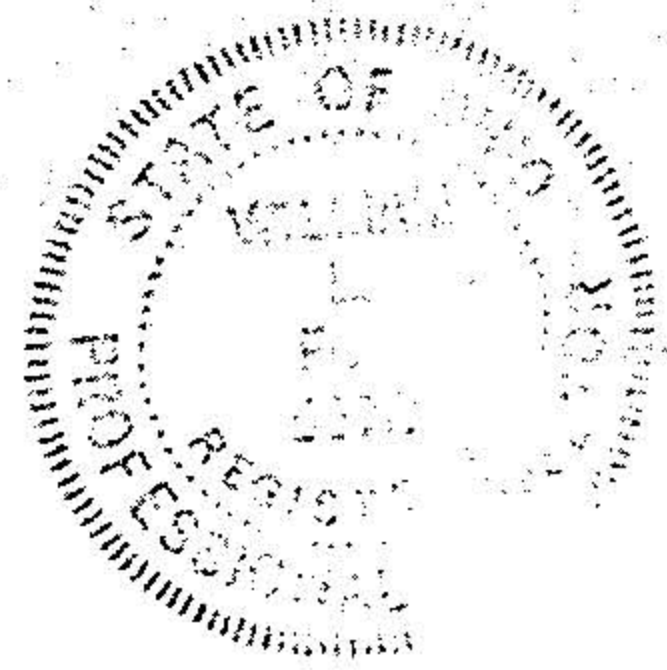

William L. Fox
 William L. Fox
 Registered Surveyor No. 5878

SURVEYOR'S CERTIFICATION

I hereby certify that this description was prepared from the notes of a survey made by the office of Grindle and Bender, Architecture, Engineering, Surveying, and William L. Fox, Registered Surveyor No. 5878. All bearings are assumed and for the determination of angles only, and all distances are