

12-00-074-000-025


LOT SPLIT

SURVEY FOR


JOHN & LYNDA FETCHET

BEING PART OF

ORIGINAL COLUMBIA TWP. LOT No. 74
COUNTY OF LORAIN, STATE OF OHIO

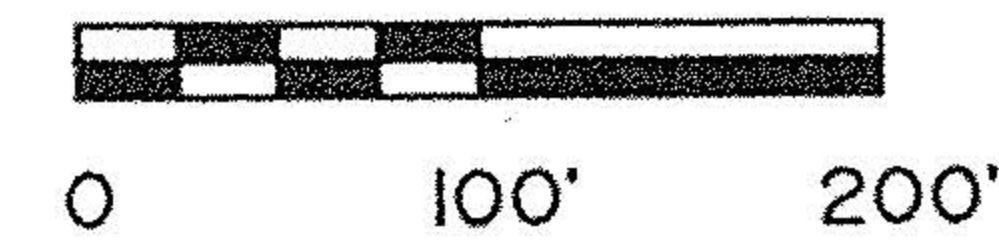

DEC. 9, 1997

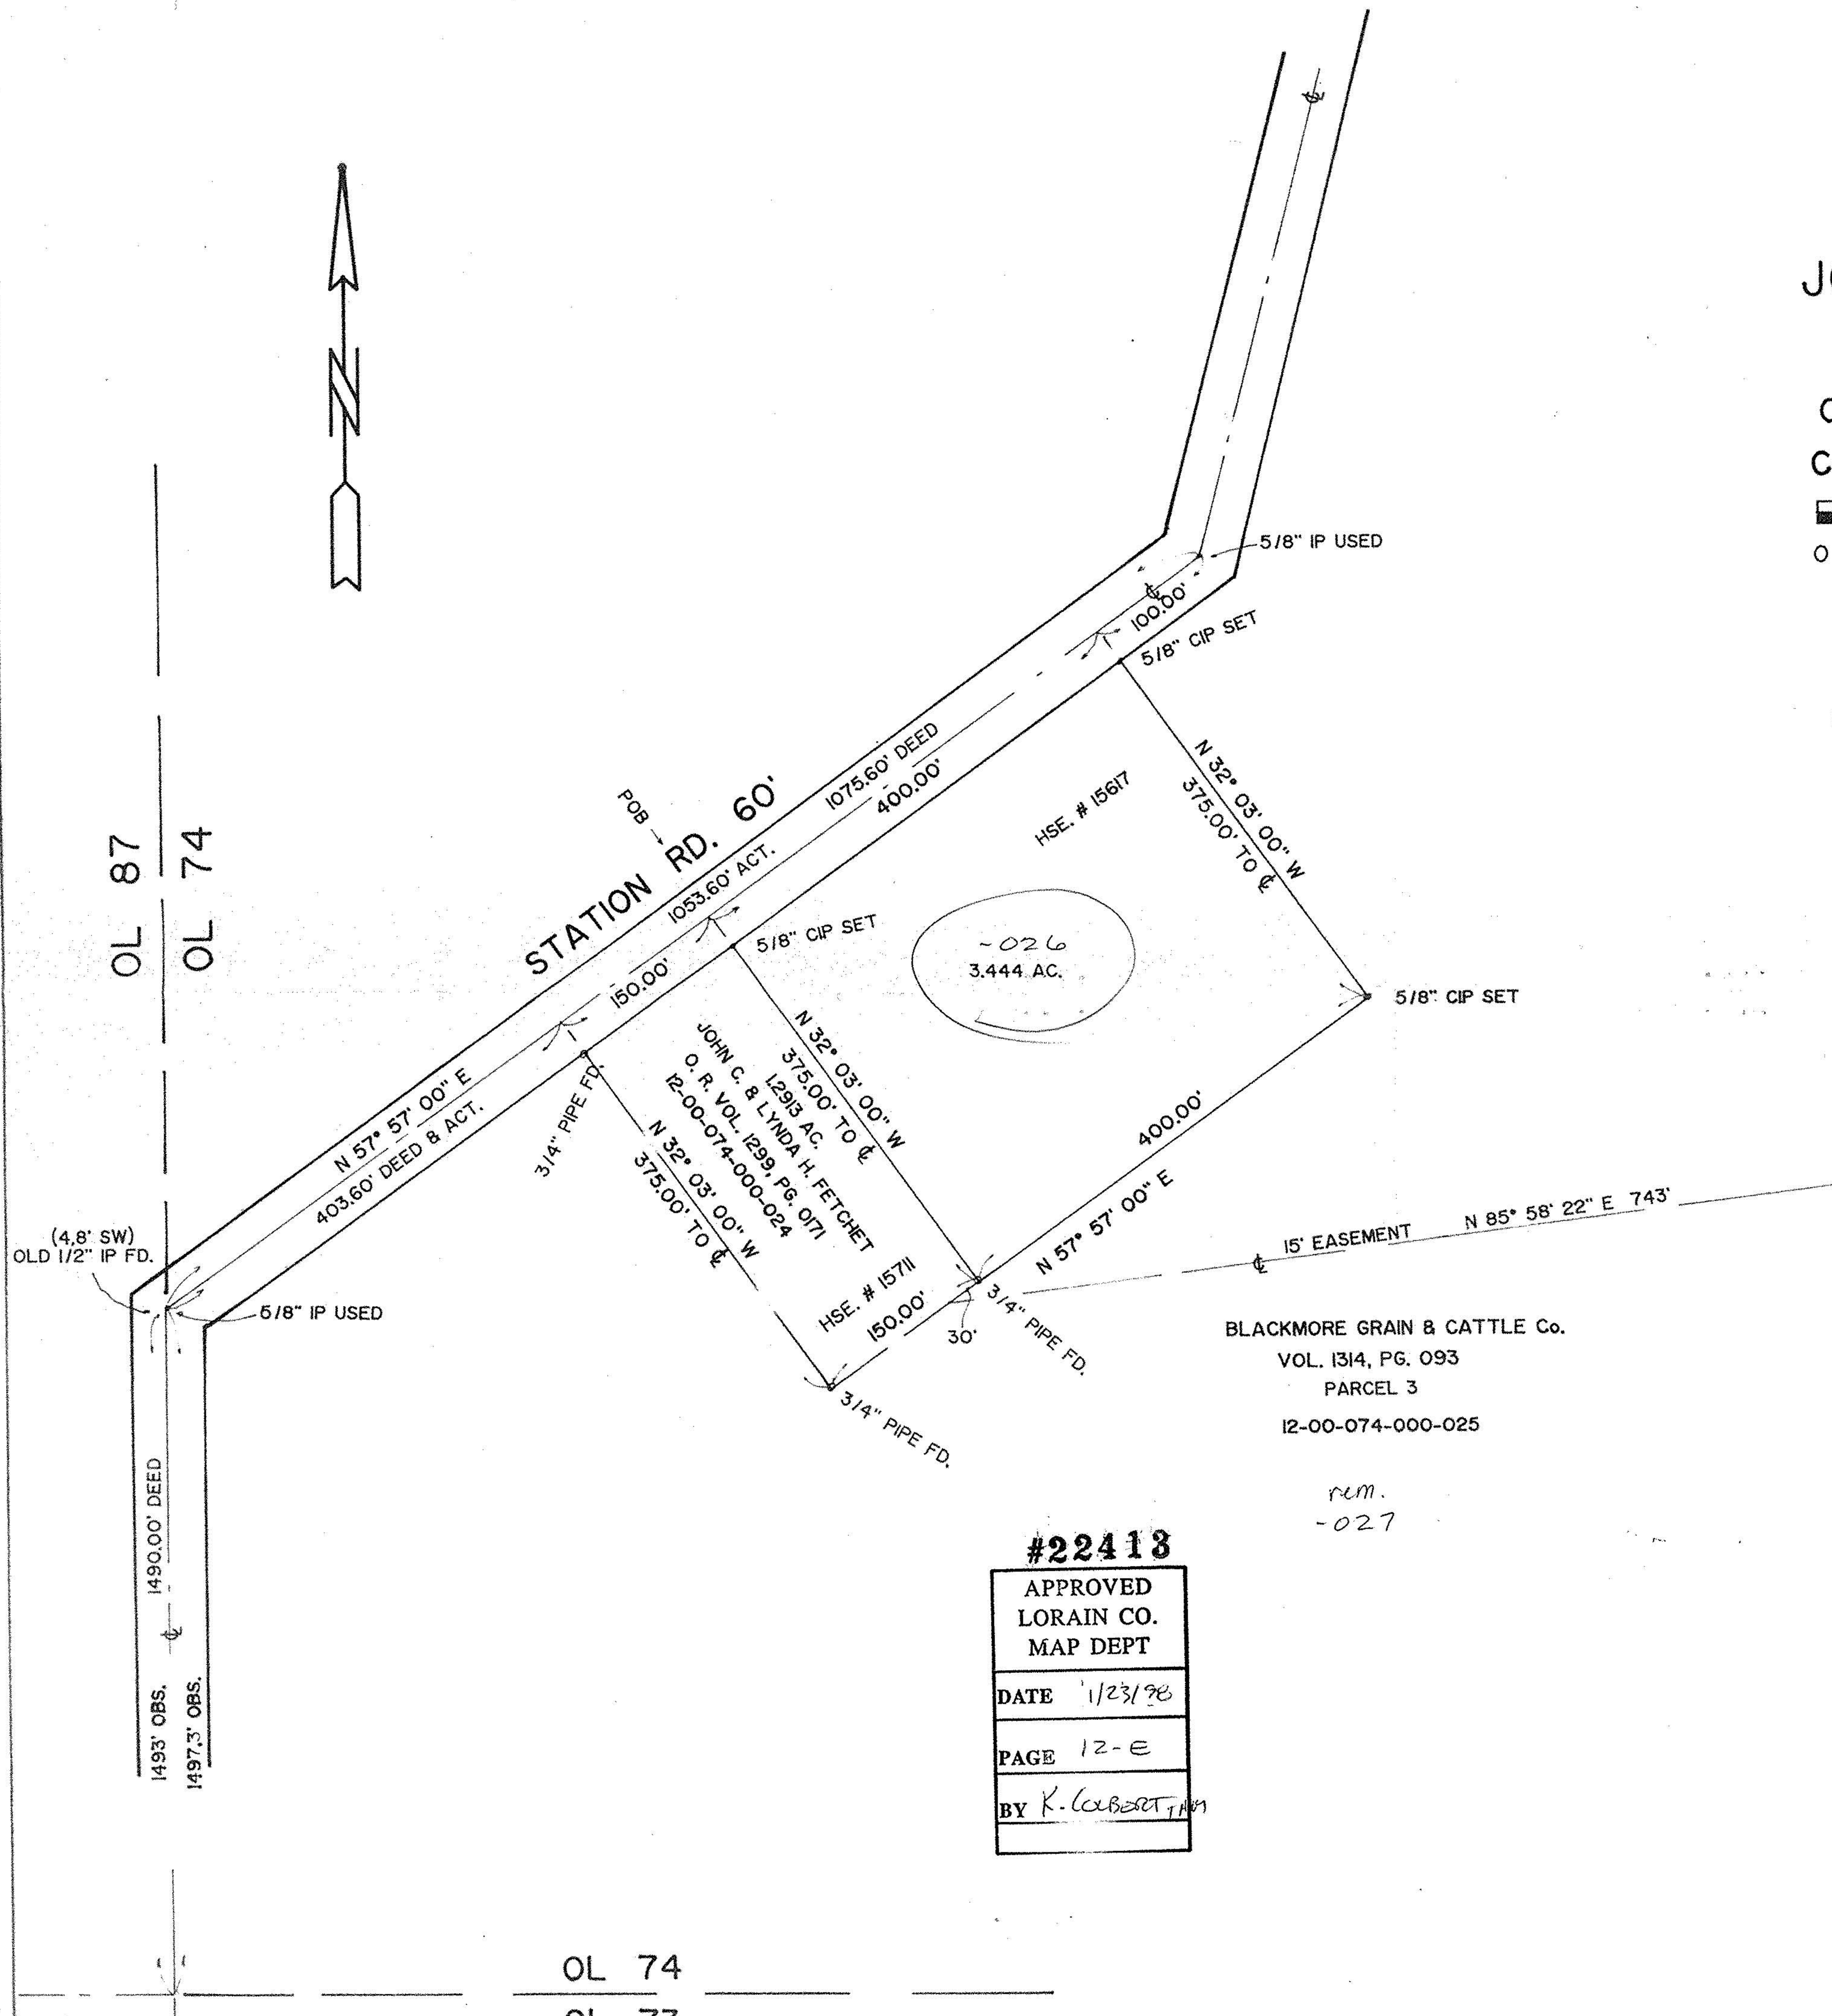

I HEREBY STATE THAT THIS IS A TRUE AND ACCURATE REPRESENTATION OF THE PREMISES SHOWN HEREON AND THAT IT WAS DONE IN ACCORDANCE WITH THE MINIMUM STANDARDS FOR BOUNDARY SURVEYS IN THE STATE OF OHIO AS ADOPTED IN THE ADMINISTRATIVE CODE CHAPTER 4733-37, ALL TO THE BEST OF MY KNOWLEDGE AND PERSONAL BELIEFS.
ALL COURSES ARE GIVEN TO AN ASSUMED MERIDIAN.

BY *James B. Root*

JAMES B. ROOT
REG. SURVEYOR No. 5045
200 ELLEN DR., BEREA, OHIO 44017
440-243-9843



BLACKMORE GRAIN & CATTLE Co.
VOL. 1314, PG. 093
PARCEL 3
12-00-074-000-025

CIP - 5/8" CAPPED IRON PIN SET

rem.
-027

#22413

APPROVED LORAIN CO. MAP DEPT
DATE 1/23/98
PAGE 12-e
BY K. COBERT

OL 74

OL 73