MAP OF PROPERTY SURVEY

IN COLUMBIA TOWNSHIP ORIGINAL LOT NOS. 72 & 89
COUNTY OF LORAIN - STATE OF OHIO

PREPARED BY

KS ASSOCIATES INC.
ENGINEERS & SURVEYORS
ELYRIA, OHIO NOV. 20, 1987

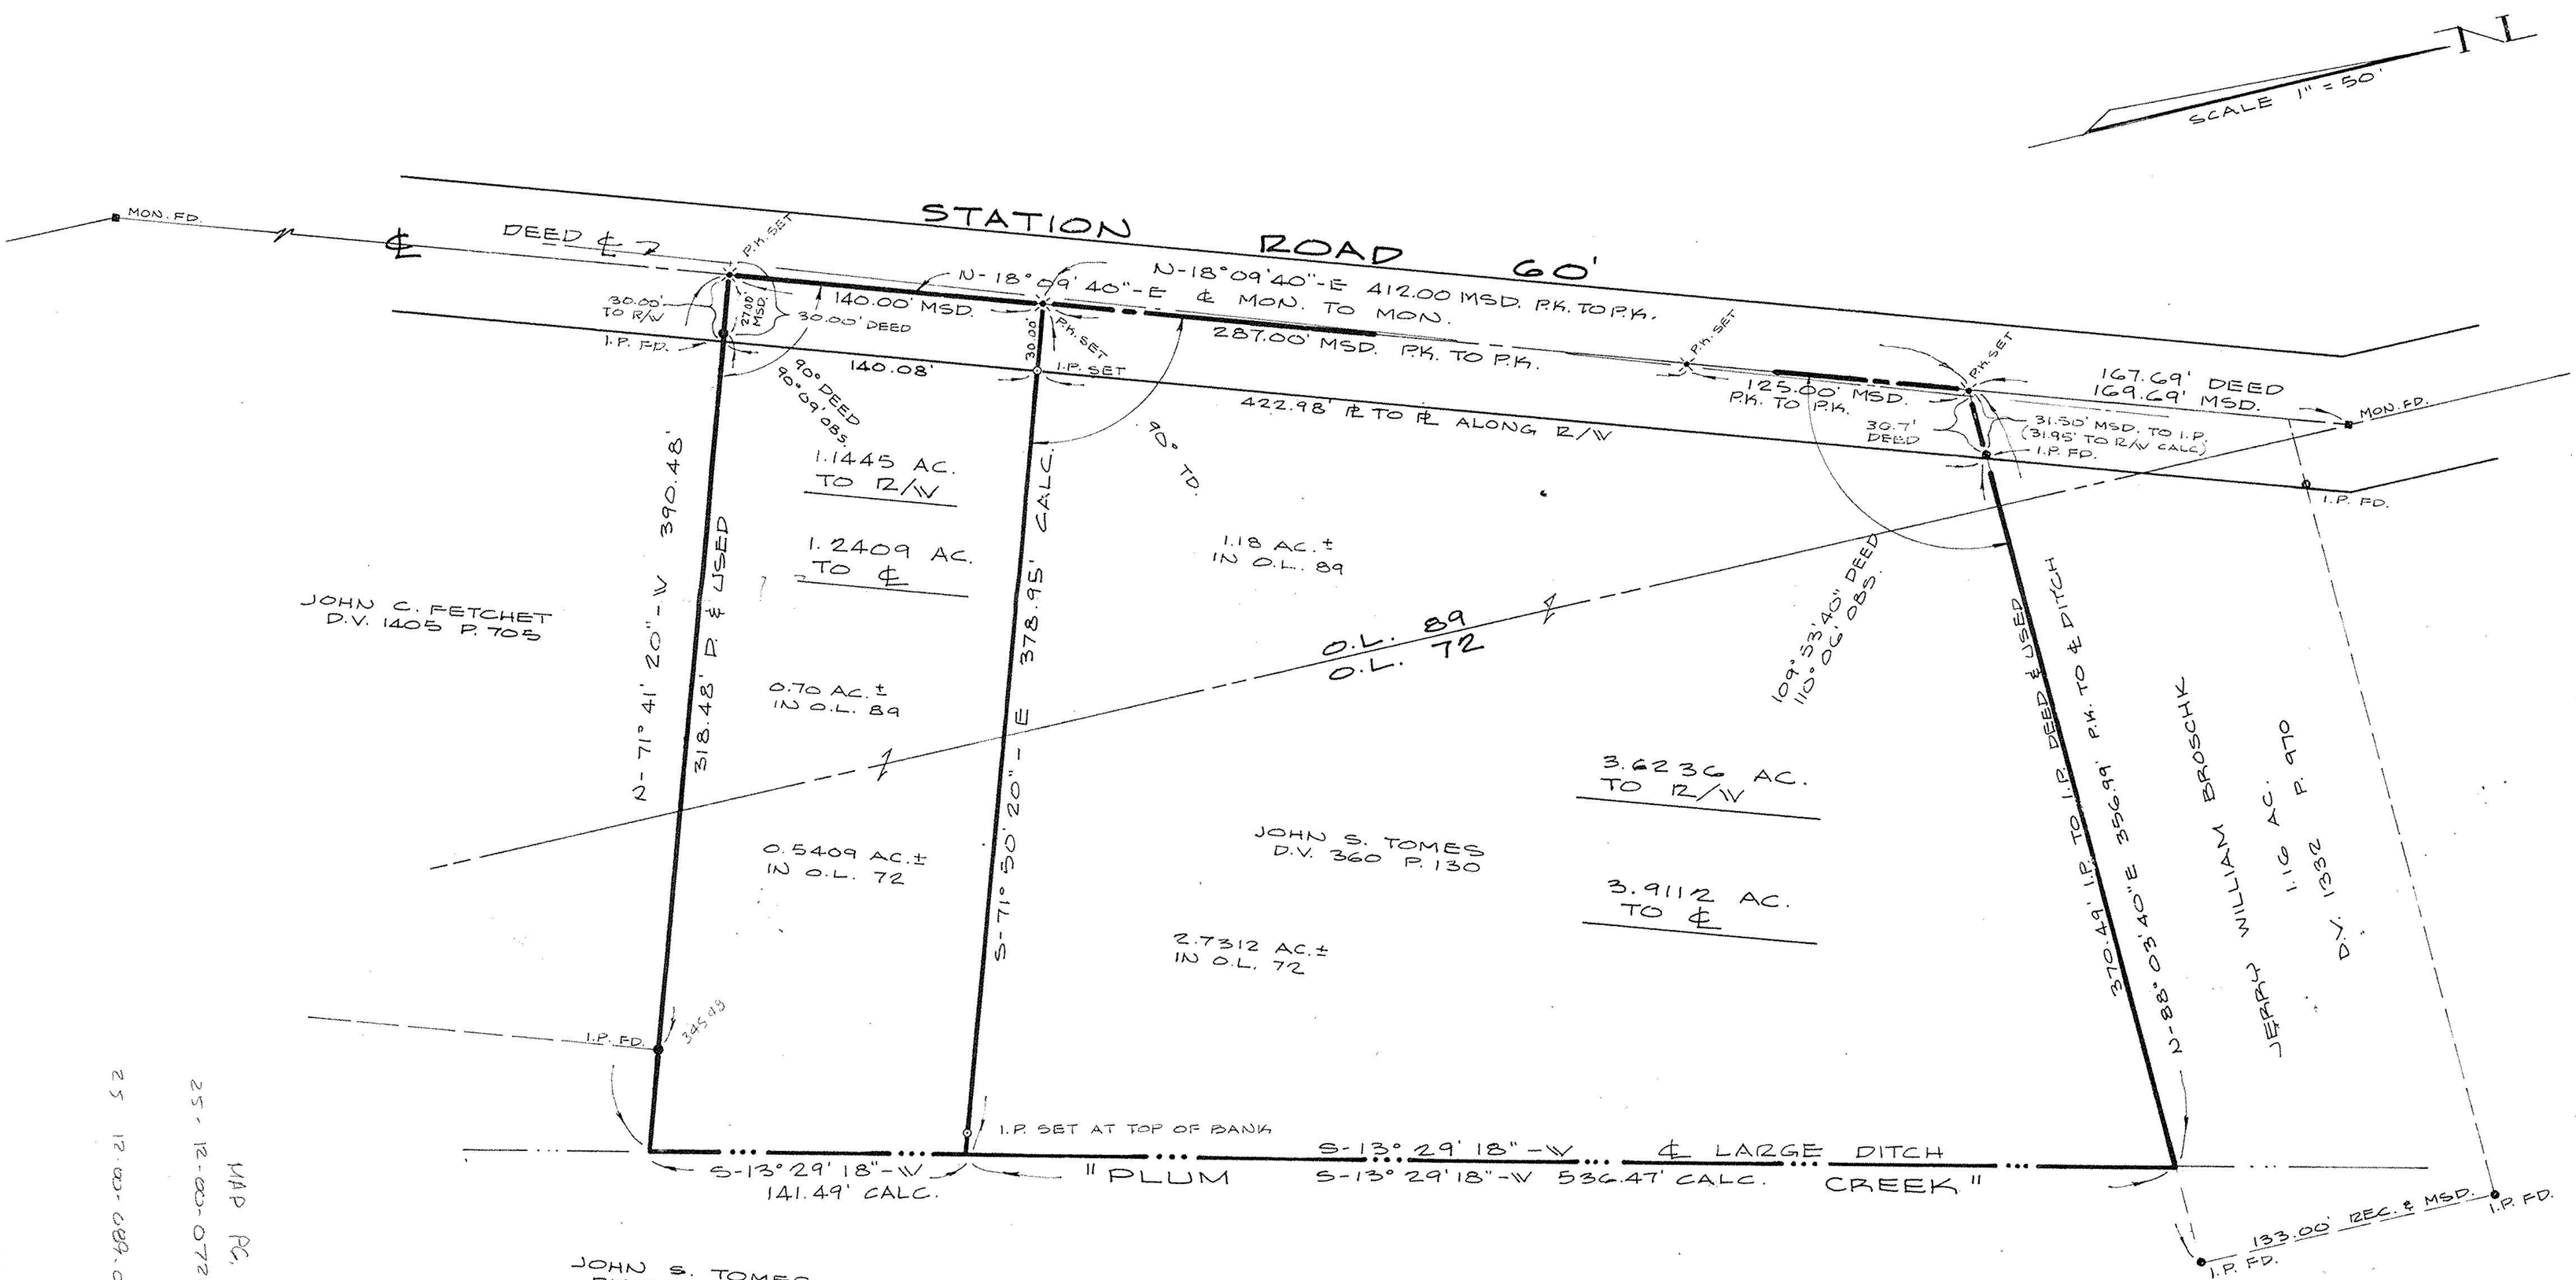

MAP AC. 12-E
25-12-00-072-000-032 13.22
- 035 61.59
25 12.00 688.000-021 1.41 A.

#17808

APPROVED
LORAIN CO.
MAP DEPT.
DATE
PAGE 12-E
BY C. Francis
VOID AFTER

STATE OF OHIO
DAVID L. ELWELL
6938
REGISTERED SURVEYOR

8C-15