



# KLEINOEDER-SCHMIDT

and ASSOCIATES

ENGINEERS — SURVEYORS — CONSULTANTS in LAND PLANNING

ELYRIA - NORWALK - MEDINA

OHIO

# SURVEY

Sublot(s) \_\_\_\_\_

Subd'n \_\_\_\_\_


Township COLUMBIA Tract \_\_\_\_\_

Orig. Lots 89 Sec. \_\_\_\_\_

County of LORAIN State of Ohio

Corporation \_\_\_\_\_

12-00-072-000 023  
-089-000  
#17808  
12-E 014, 72  
59

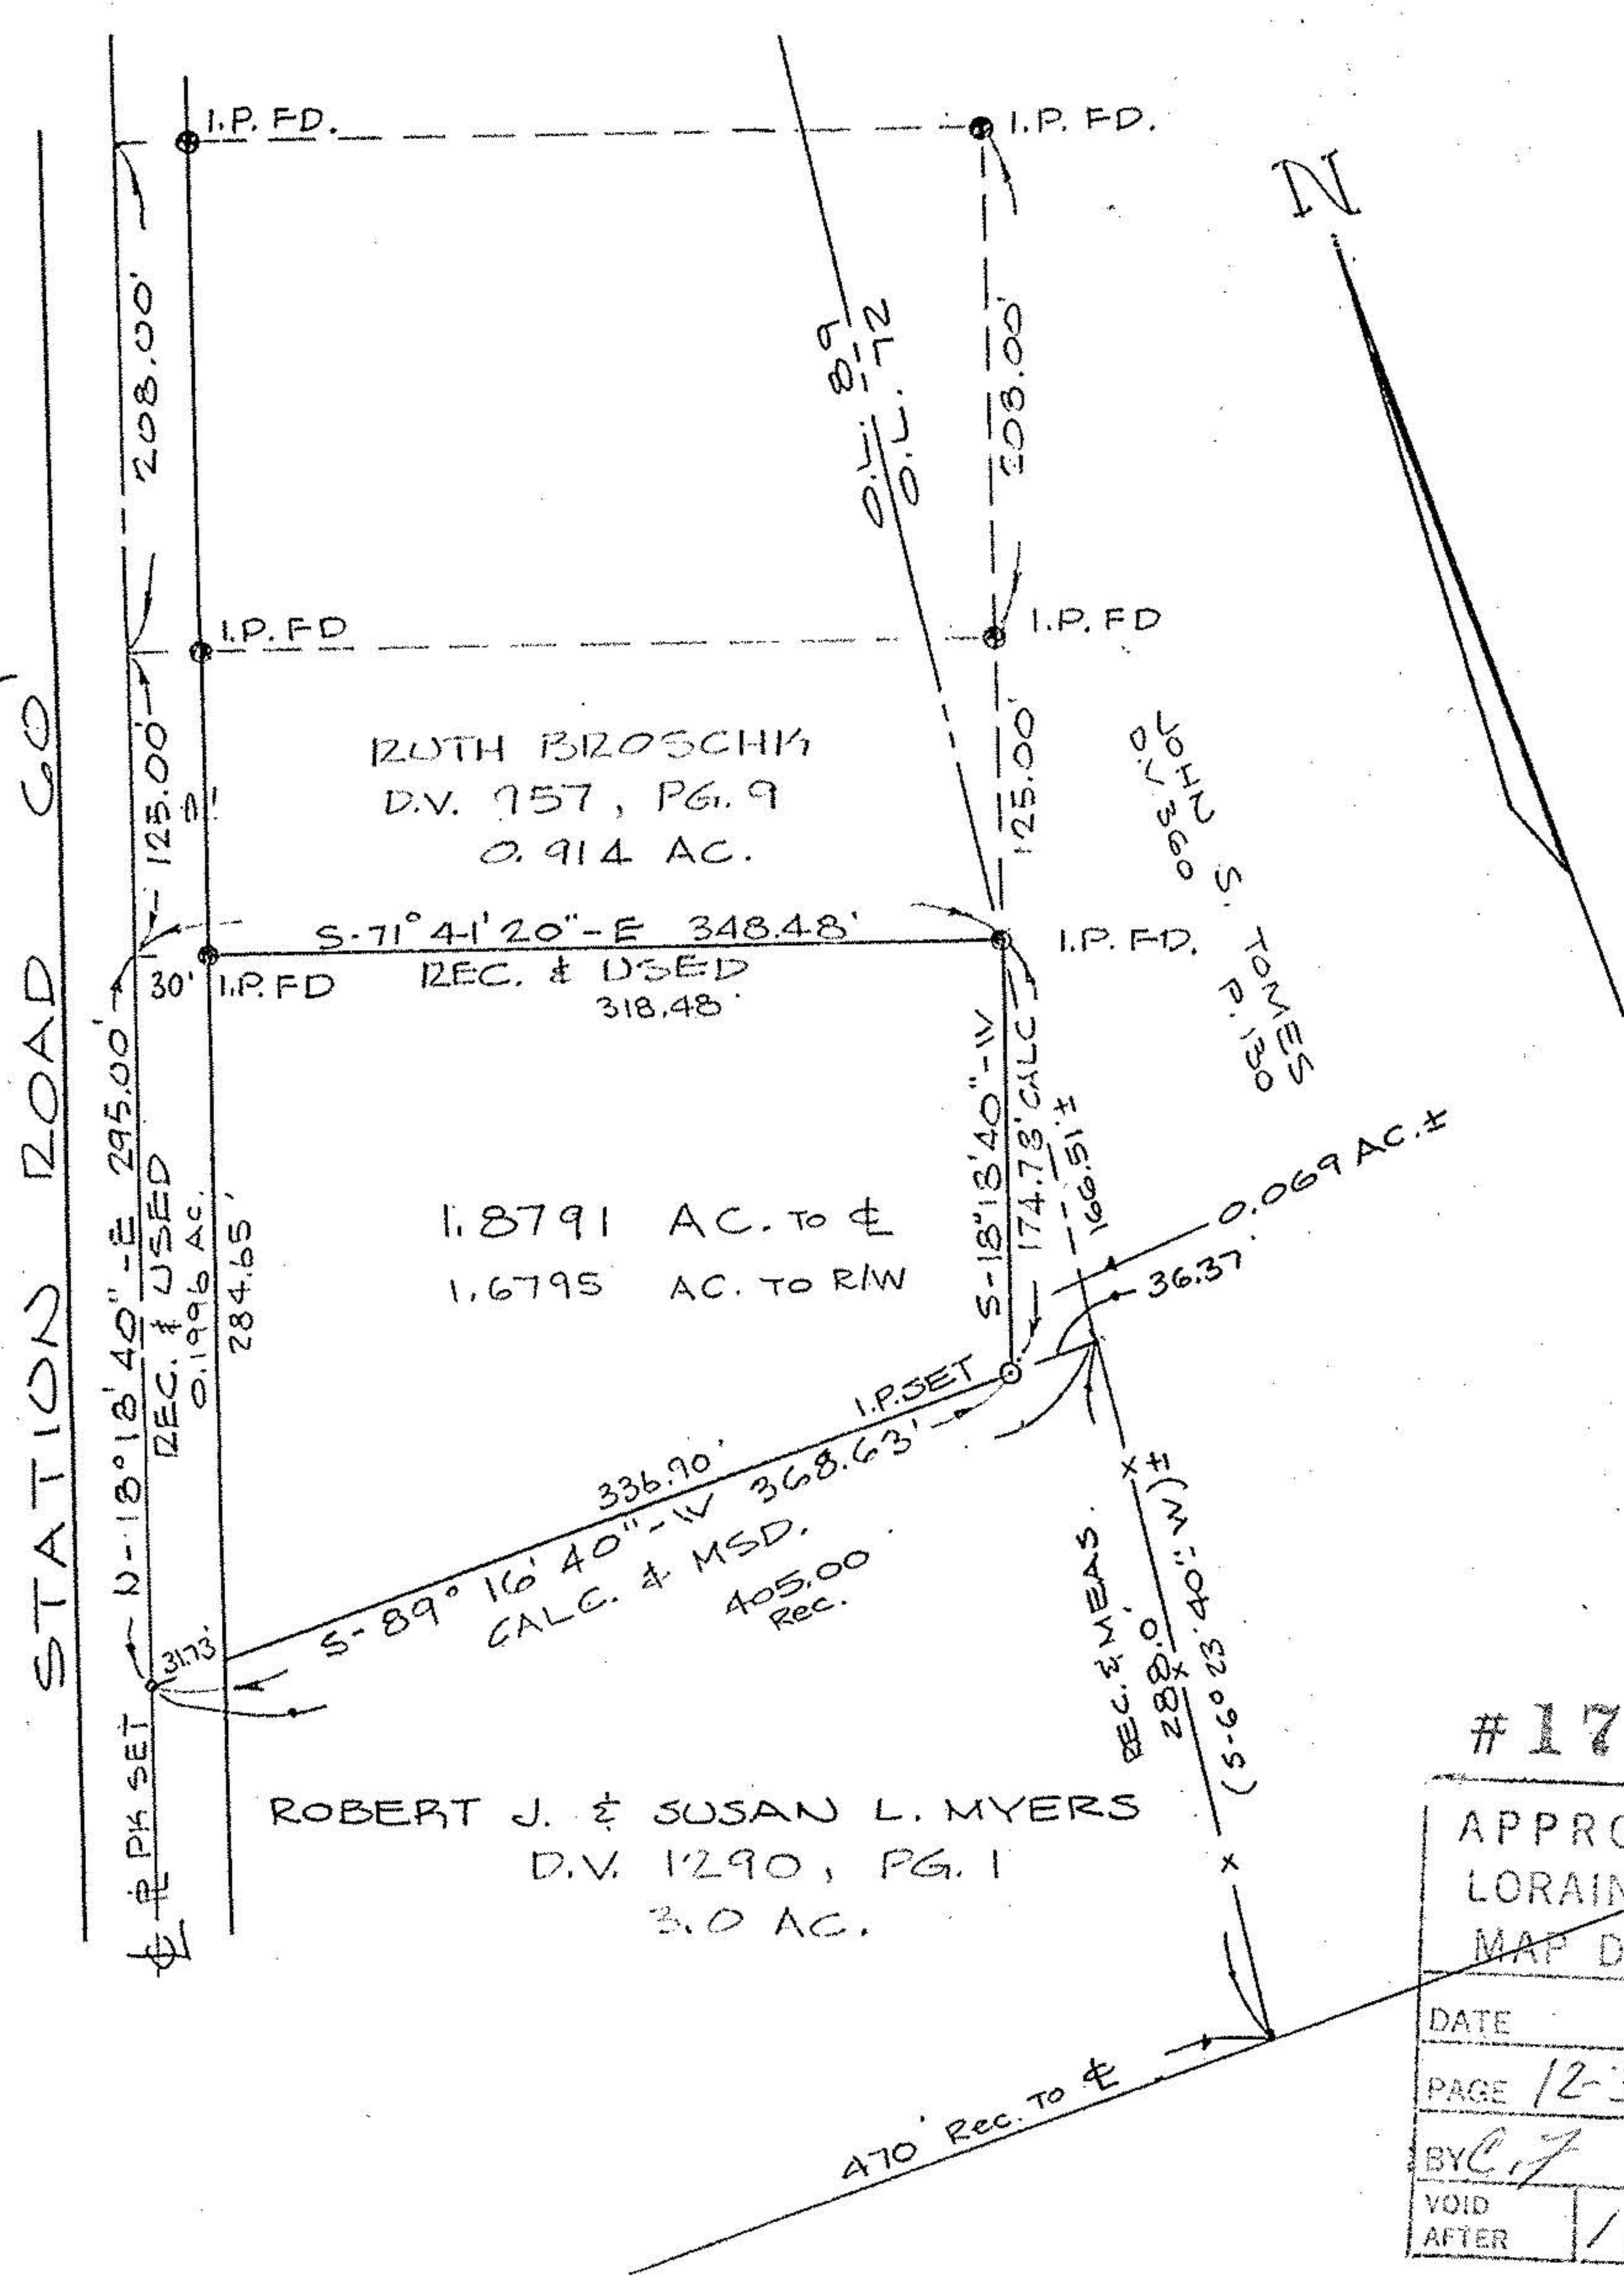

#17808

APPROVED	
LORAIN CO.	
MAP DEPT.	
DATE	
PAGE	12-30-87
BY	C.F.
VOID AFTER	17808

REV. 12-28-87

Prepared for: FRANK FETCHET  
26312 AKINS ROAD  
COLUMBIA STATION, OHIO 44028

Scale: 1" = 100'    Date: 6-30-86    Dr. by: A.B.    Job No: 86-15