


m.e.

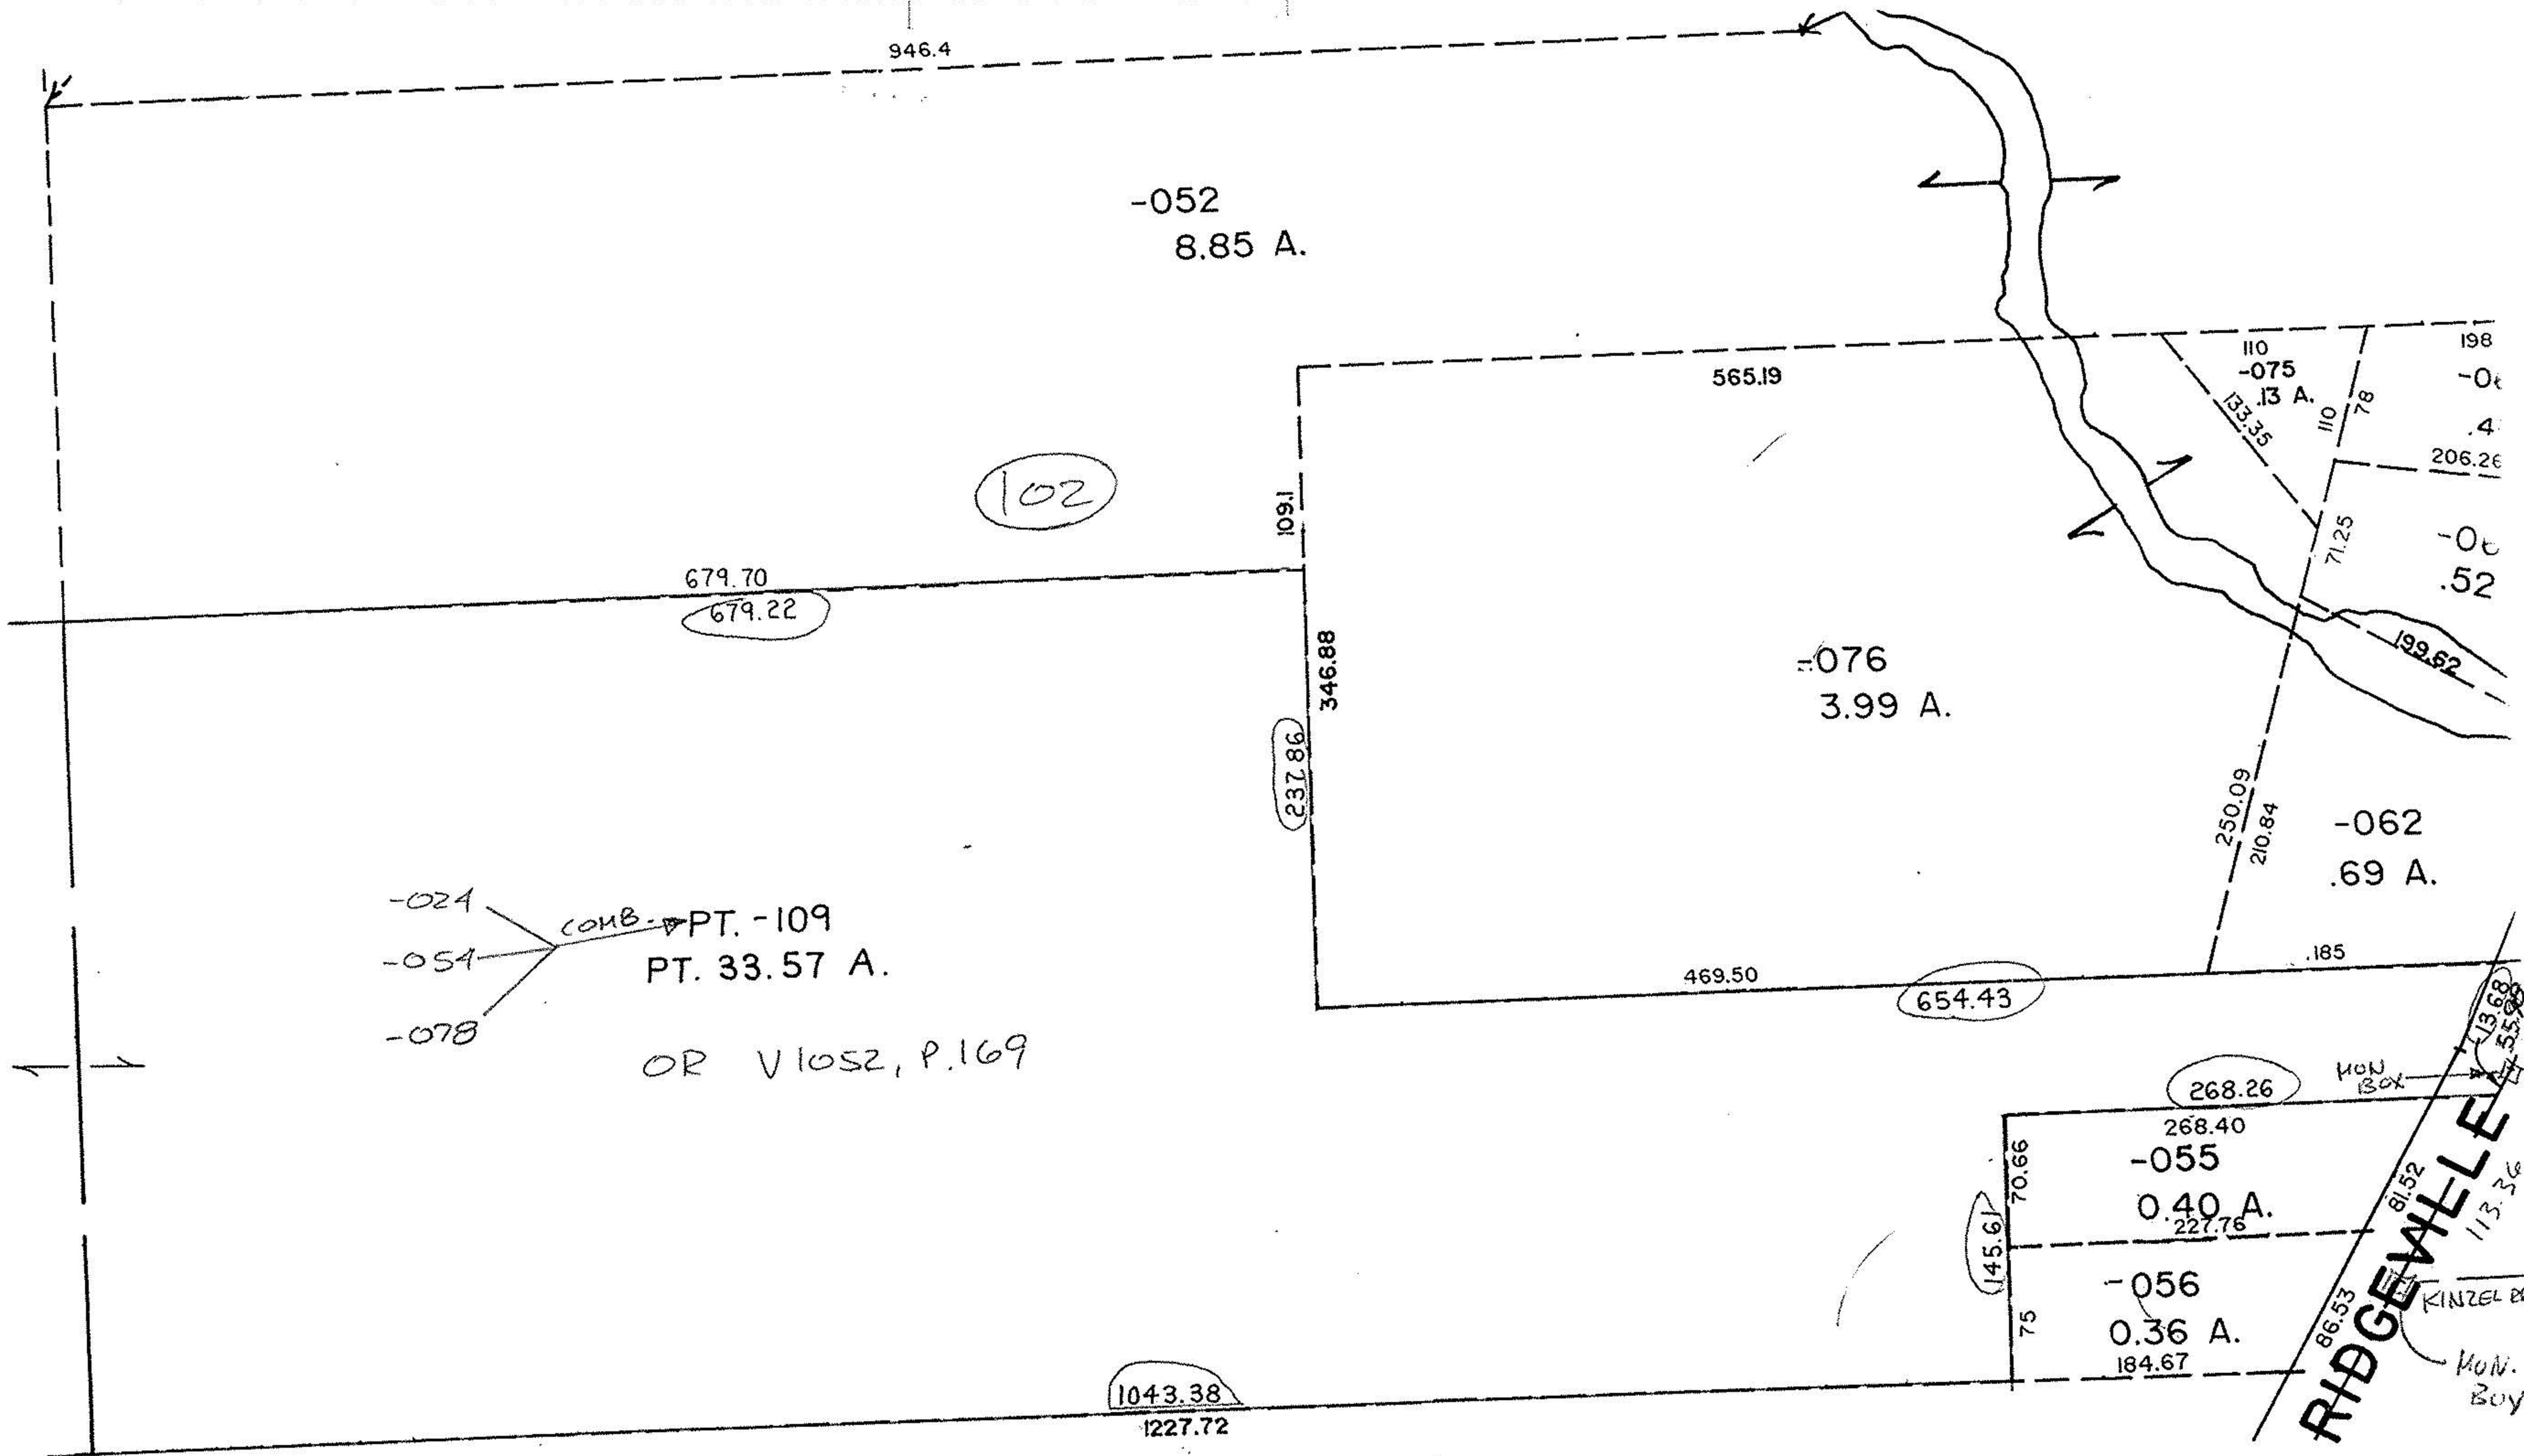

SEE 4-00-011-G

4-00-011-C

RIDGEVILLE
 113.68
 47.55
 113.36