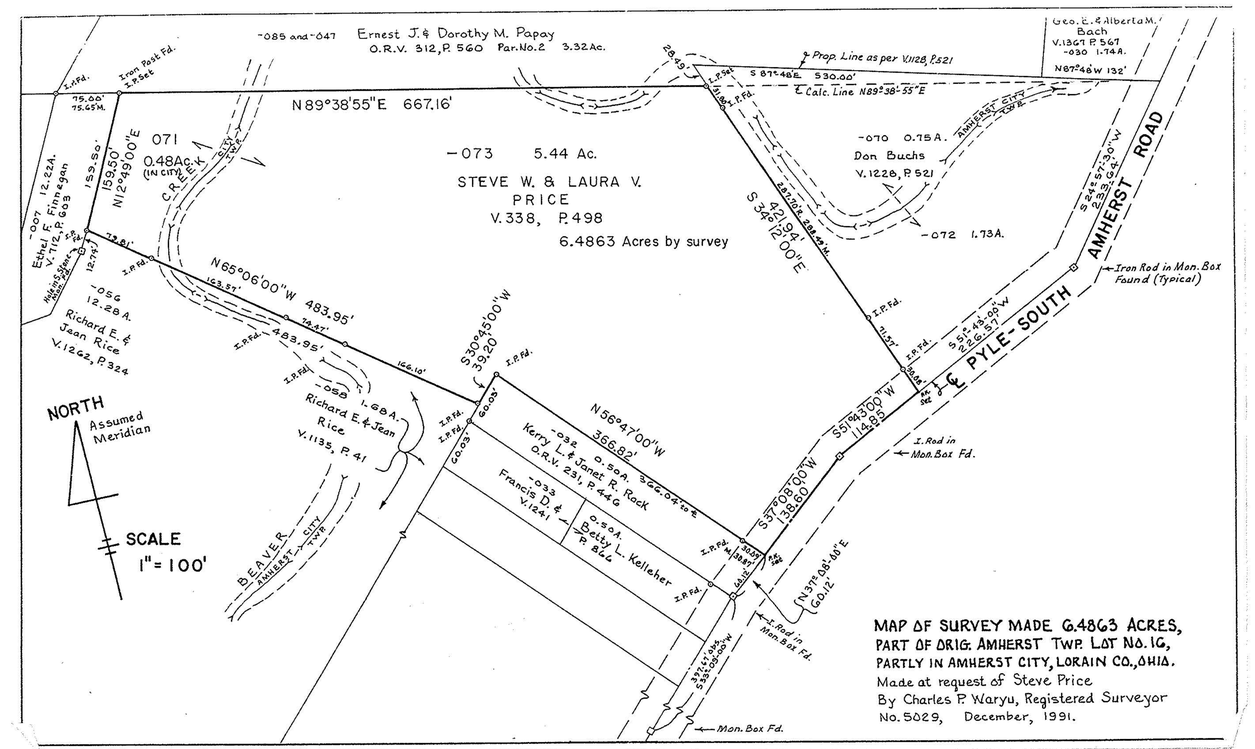

MAP OF SURVEY MADE 6.4863 ACRES,
PART OF ORIG. AMHERST TWP. LOT NO. 16,
PARTLY IN AMHERST CITY, LORAIN CO., OHIO.
Made at request of Steve Price
By Charles P. Waryu, Registered Surveyor
No. 5029, December, 1991.

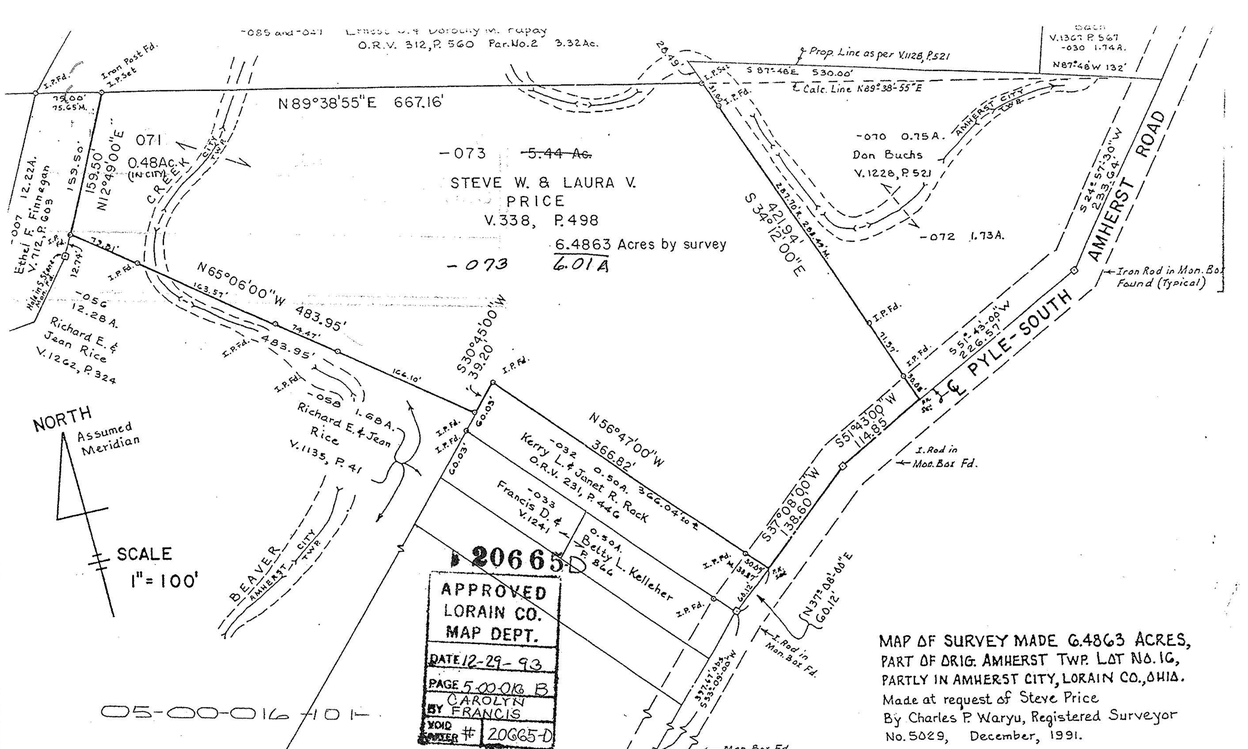

20665-D

APPROVED
LORAIN CO.
MAP DEPT.
DATE 12-29-93
BY CAROLYN FRANCIS
VOID AFFIDAVIT # 20665-D

05-00-016-101

MAP OF SURVEY MADE 6.4863 ACRES,
PART OF ORIG. AMHERST TWP. LOT NO. 16,
PARTLY IN AMHERST CITY, LORAIN CO., OHIO.
Made at request of Steve Price
By Charles P. Waryu, Registered Surveyor
No. 5029, December, 1991.