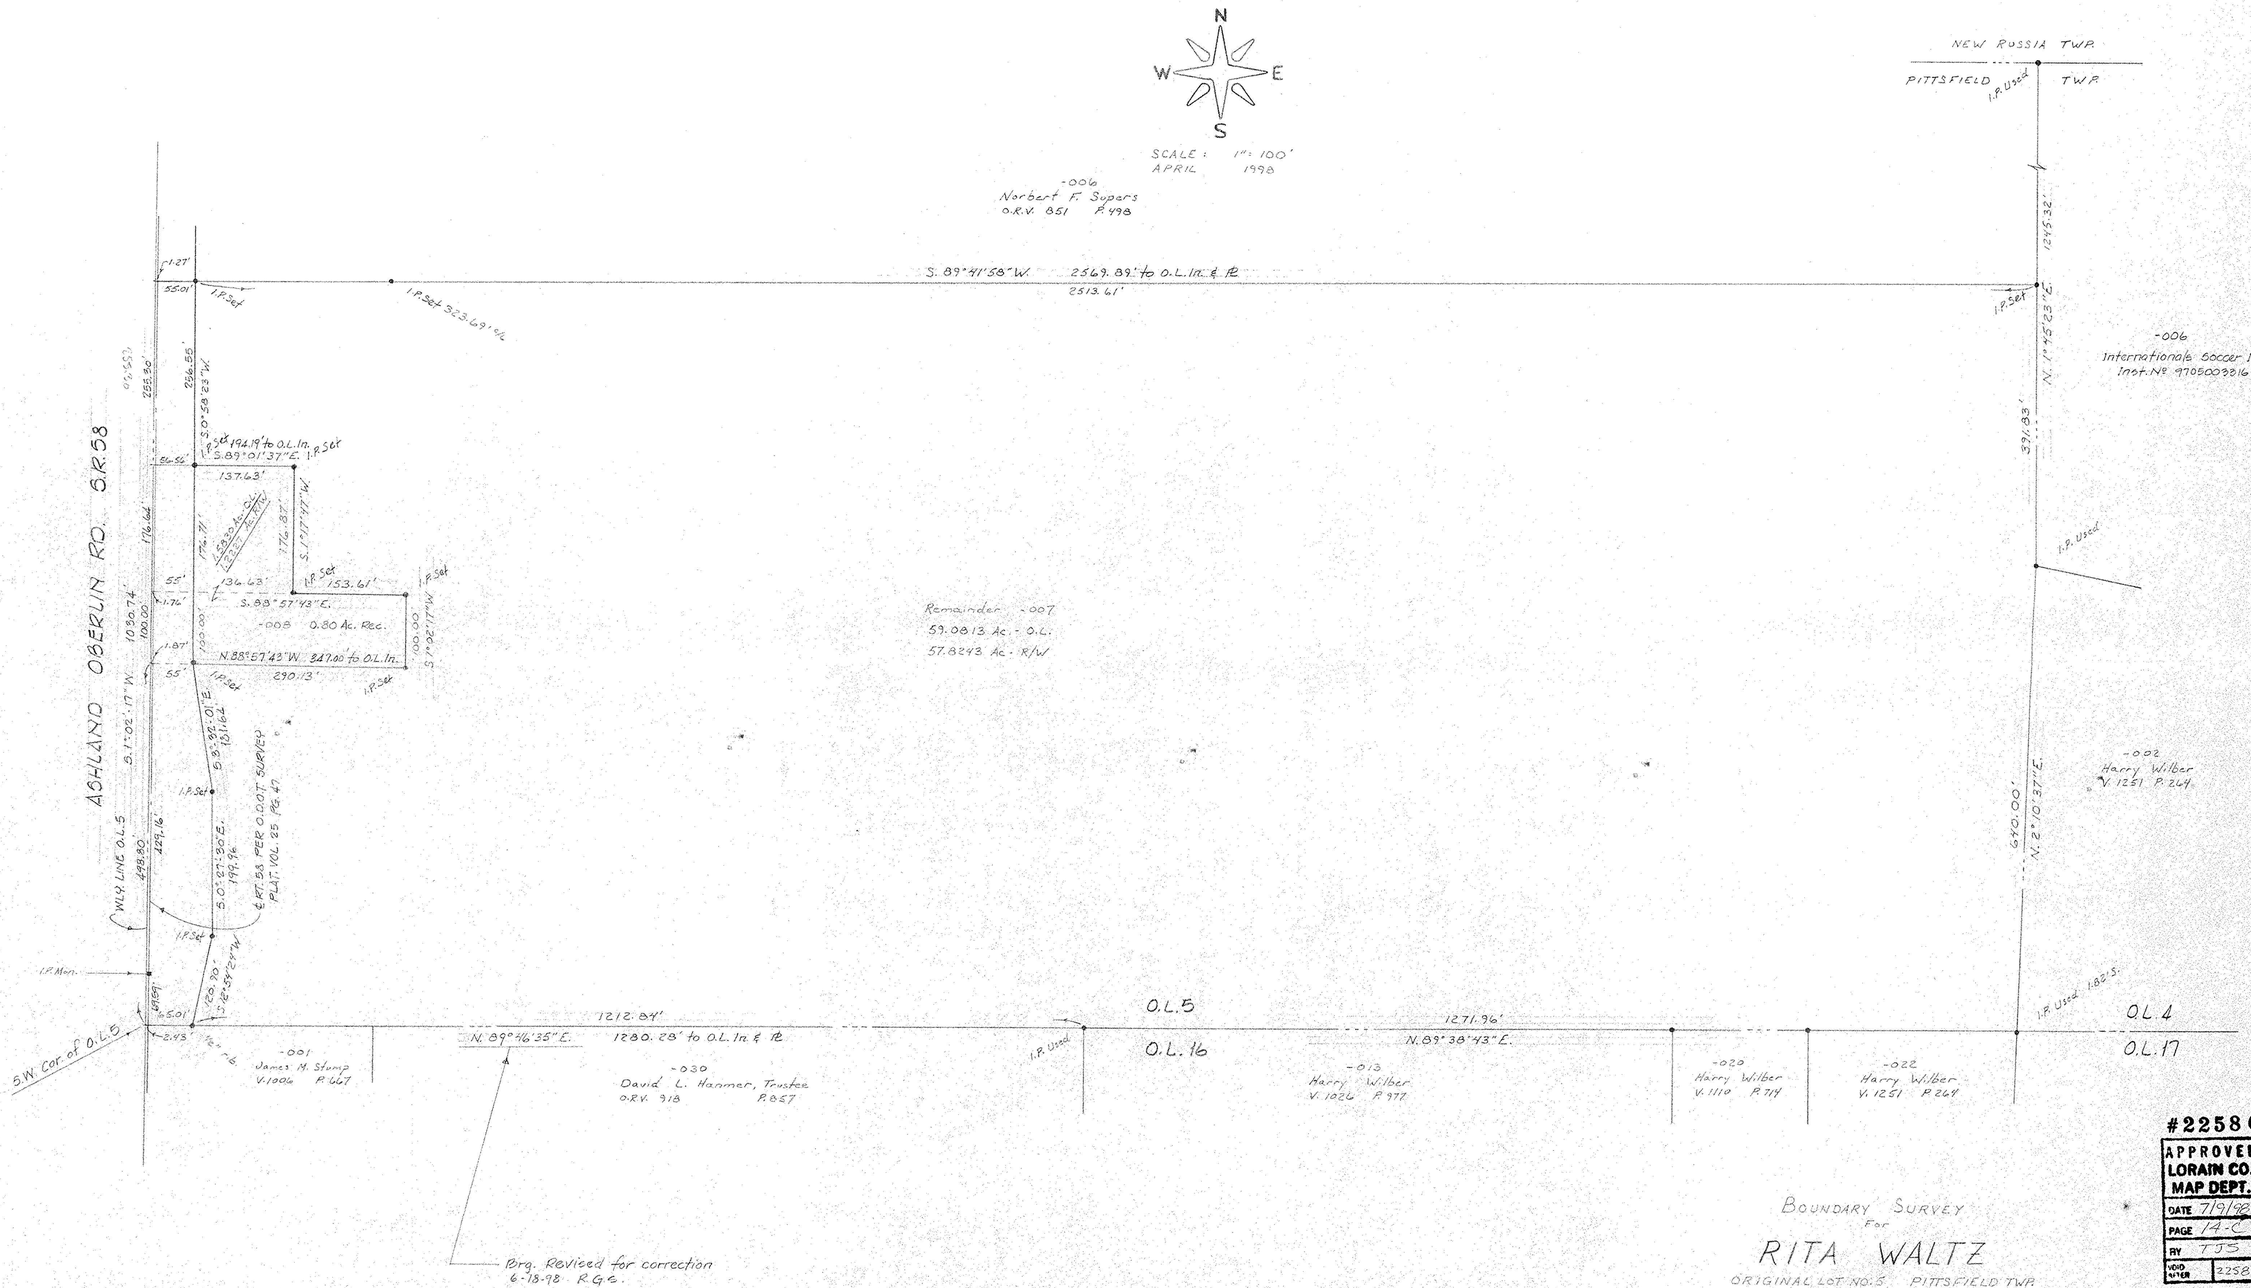

BOUNDARY SURVEY
For
RITA WALTZ

ORIGINAL LOT NO. 5 PITTSFIELD TWP.
COUNTY OF LORAIN STATE OF OHIO

LAUNDON · SIMON · CAHL & ASSOCIATES
PROFESSIONAL LAND SURVEYORS
110 MIDDLE AVE. ELYRIA, OHIO
440-322-7625
JOB NO. 98-3034
FB-244 P. 8

#22580
APPROVED
LORAIN CO.
MAP DEPT.
DATE 7/9/98
PAGE 14-C
BY TJS
VOID AFTER 22580

STATE OF OHIO
ROBERT G. SIMON
5101
REGISTERED
SURVEYOR