FILE # 4673

PLAT OF SURVEY FOR

GILL PROPERTIES L.L.C

OF PART OF ORIGINAL COLUMBIA TOWNSHIP LOTS NOS. 24 & 37
NOW IN COLUMBIA TOWNSHIP, LORAIN COUNTY, OHIO.

APRIL 2001 SCALE 1" = 150'

ERIC J. NELSON P.S.

GILES NELSON & ASSOC. INC.
CIVIL ENGINEERING & SURVEYING
27201 S. R. 82 - SUITE #2
COLUMBIA TYP., OHIO 44028
PH 440 236 8267 F 236 6270
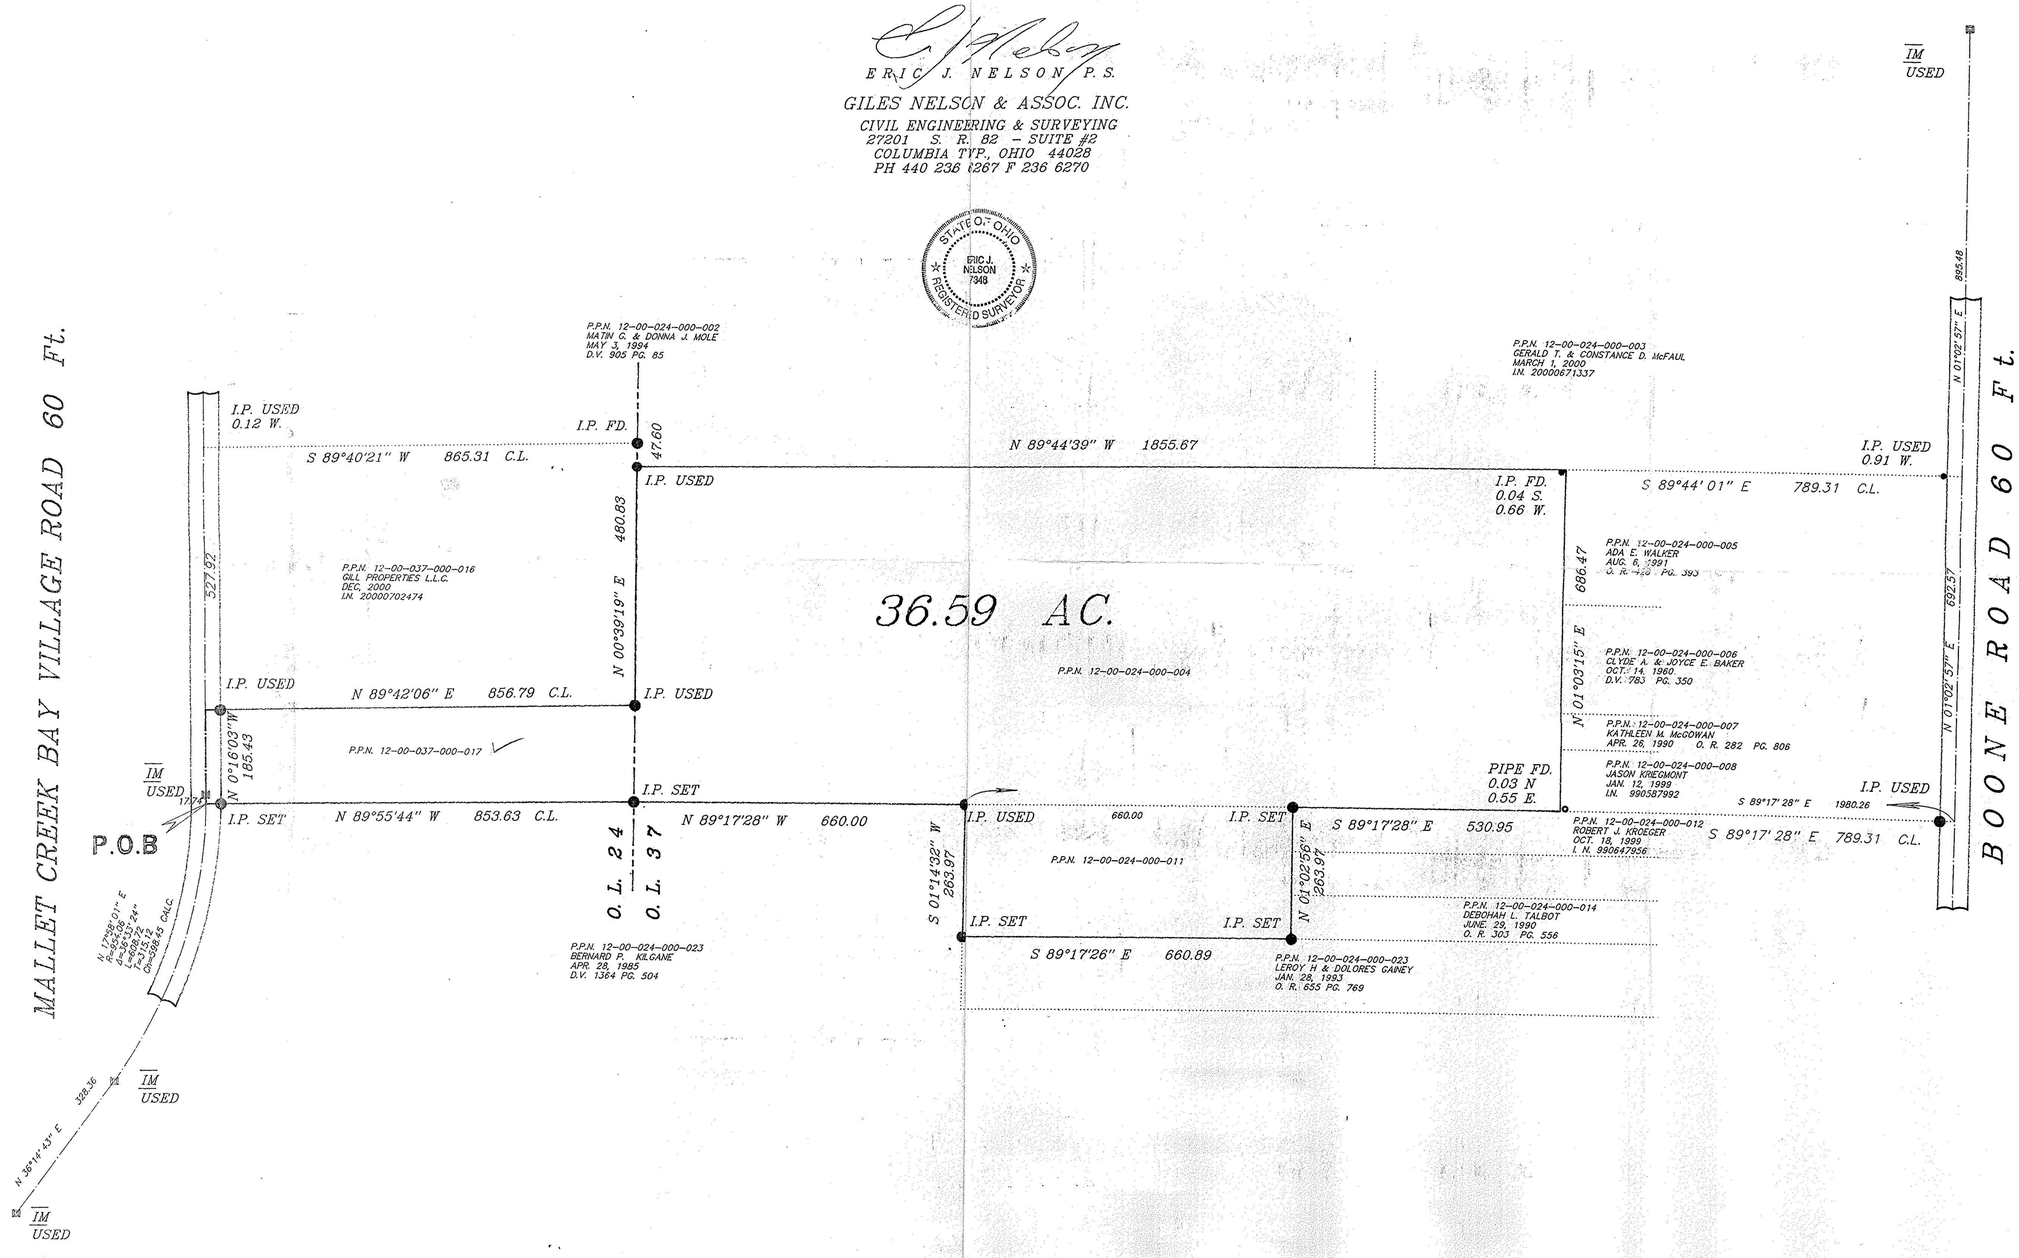
STATE OF OHIO
ERIC J. NELSON 7348
REGISTERED SURVEYOR