SURVEY SPLIT MAP

PPN: 11-00-015-000-001~11-00-026-000-027 & 043

FOR: RONALD L. PALMER

EATON TOWNSHIP LORAIN COUNTY
STATE OF OHIO
PART OF ORIGINAL EATON TOWNSHIP LOT NOS. 15 & 26

HAYWOOD
Civil Engineering & Land Surveying
"Committed to Service and Quality"

630 Cleveland Street Office: (440) 365-9831
Elyria, Ohio 44035 Fax: (440) 365-3426
www.haywoodcivilengineering.com

SURVEYOR'S CERTIFICATION

THIS IS TO CERTIFY THAT AT THE REQUEST OF THE OWNERS I HAVE SURVEYED AND PLATTED 56.2409 ACRES OF LAND AS SHOWN HEREON IN ORIGINAL EATON TOWNSHIP LOT NOS. 15 AND 26, TOWNSHIP OF EATON, COUNTY OF LORAIN, STATE OF OHIO. DISTANCES ARE SHOWN IN FEET AND DECIMAL PARTS THEREOF. BEARINGS SHOWN ARE ASSUMED AND USED TO DESCRIBE ANGLES ONLY. ALL OF WHICH I CERTIFY TO BE CORRECT.

STATE OF OHIO
DOUGLAS H. MOSLEY
S-6303
REGISTERED
PROFESSIONAL SURVEYOR

Doug Mosley
7/22/03

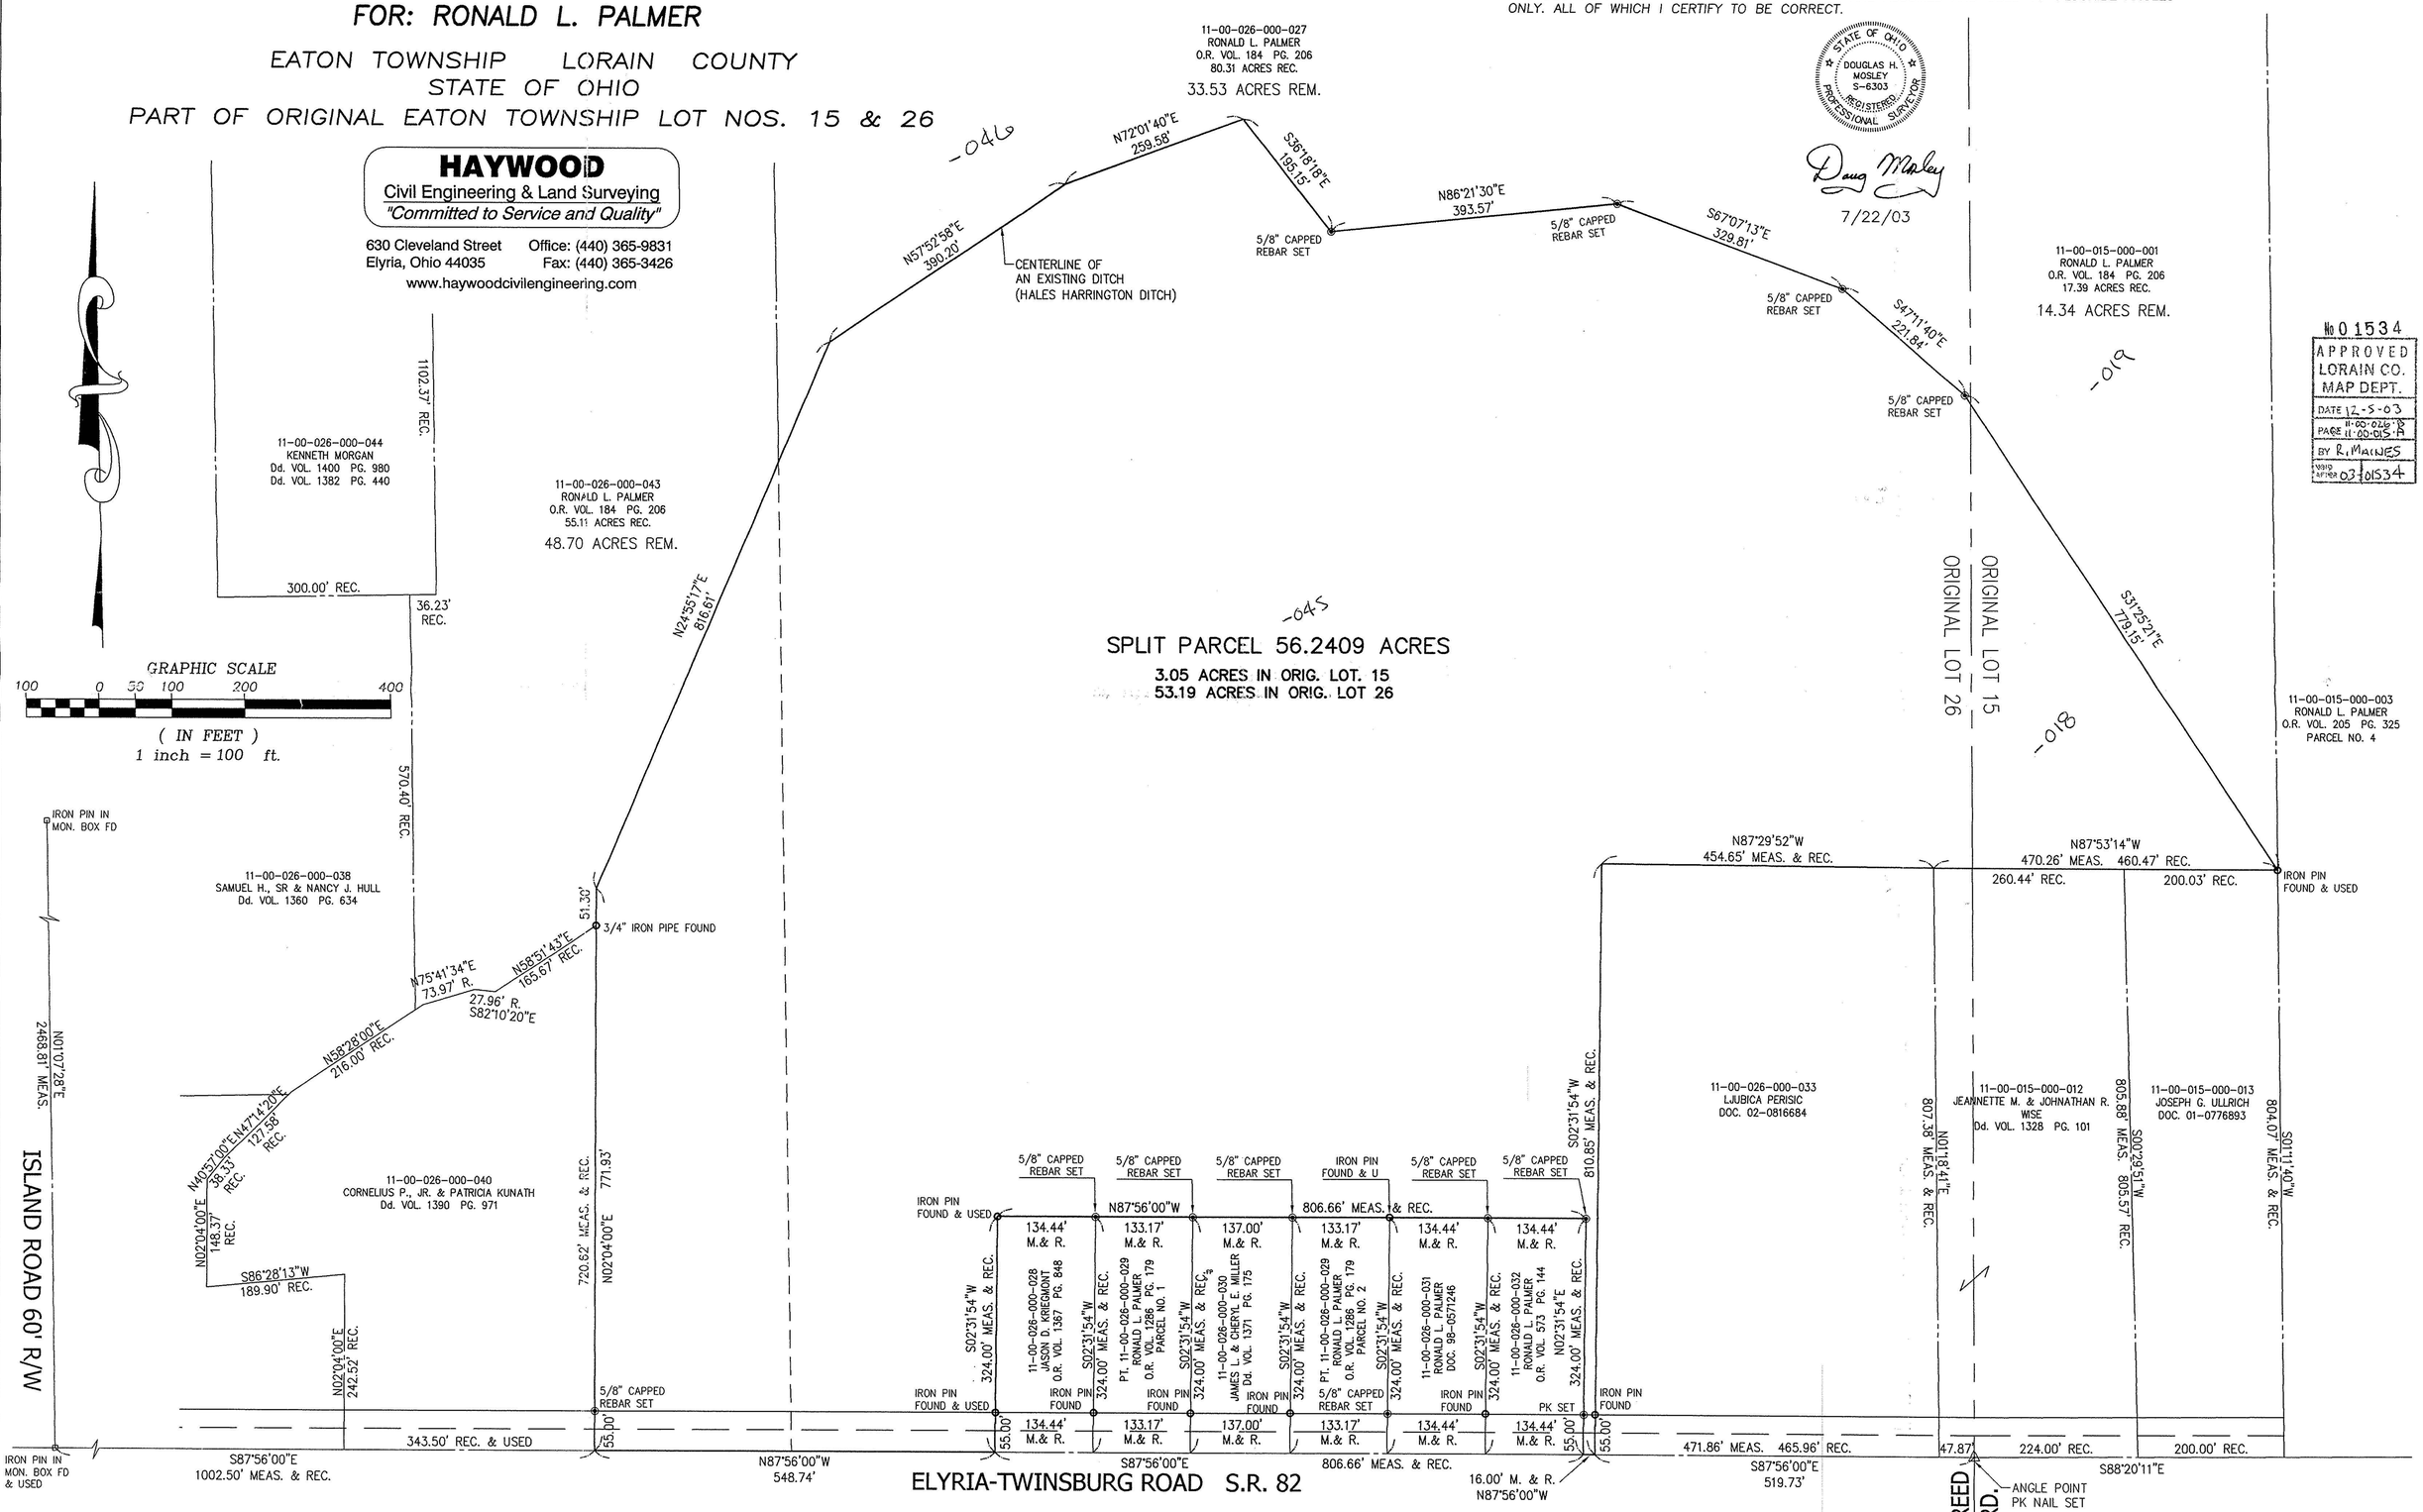

No 01534
APPROVED
LORAIN CO.
MAP DEPT.
DATE 12-5-03
PAGE 11-00-026-18 11-00-015-A
BY R. MAINES
TRANSFER NO. 03-01534