GRAPHIC SCALE 1"=200'

0 200 400 600

N

× IPS
• IPF
▪ MON

PARCEL OWNERSHIP

-053 Bradley E. & Marianne C. Sommerfelt
Doc. 2002-0863427
-055 John D. Cox Exhibit B Doc. 2002-0873246
-045 Thomas & Deborah A. Bousek V. 1322 P. 461

Bearings are to an assumed meridian and used to indicate angles only.
Basis of bearings is the centerline bearing for Whitehead Road as found in Deed Volume 1322 P. 461
This plat of survey represents the minimum standards for boundary surveys in the State of Ohio sd sdopted 5-1-80 of the Administrative Code chapter 4733-37.

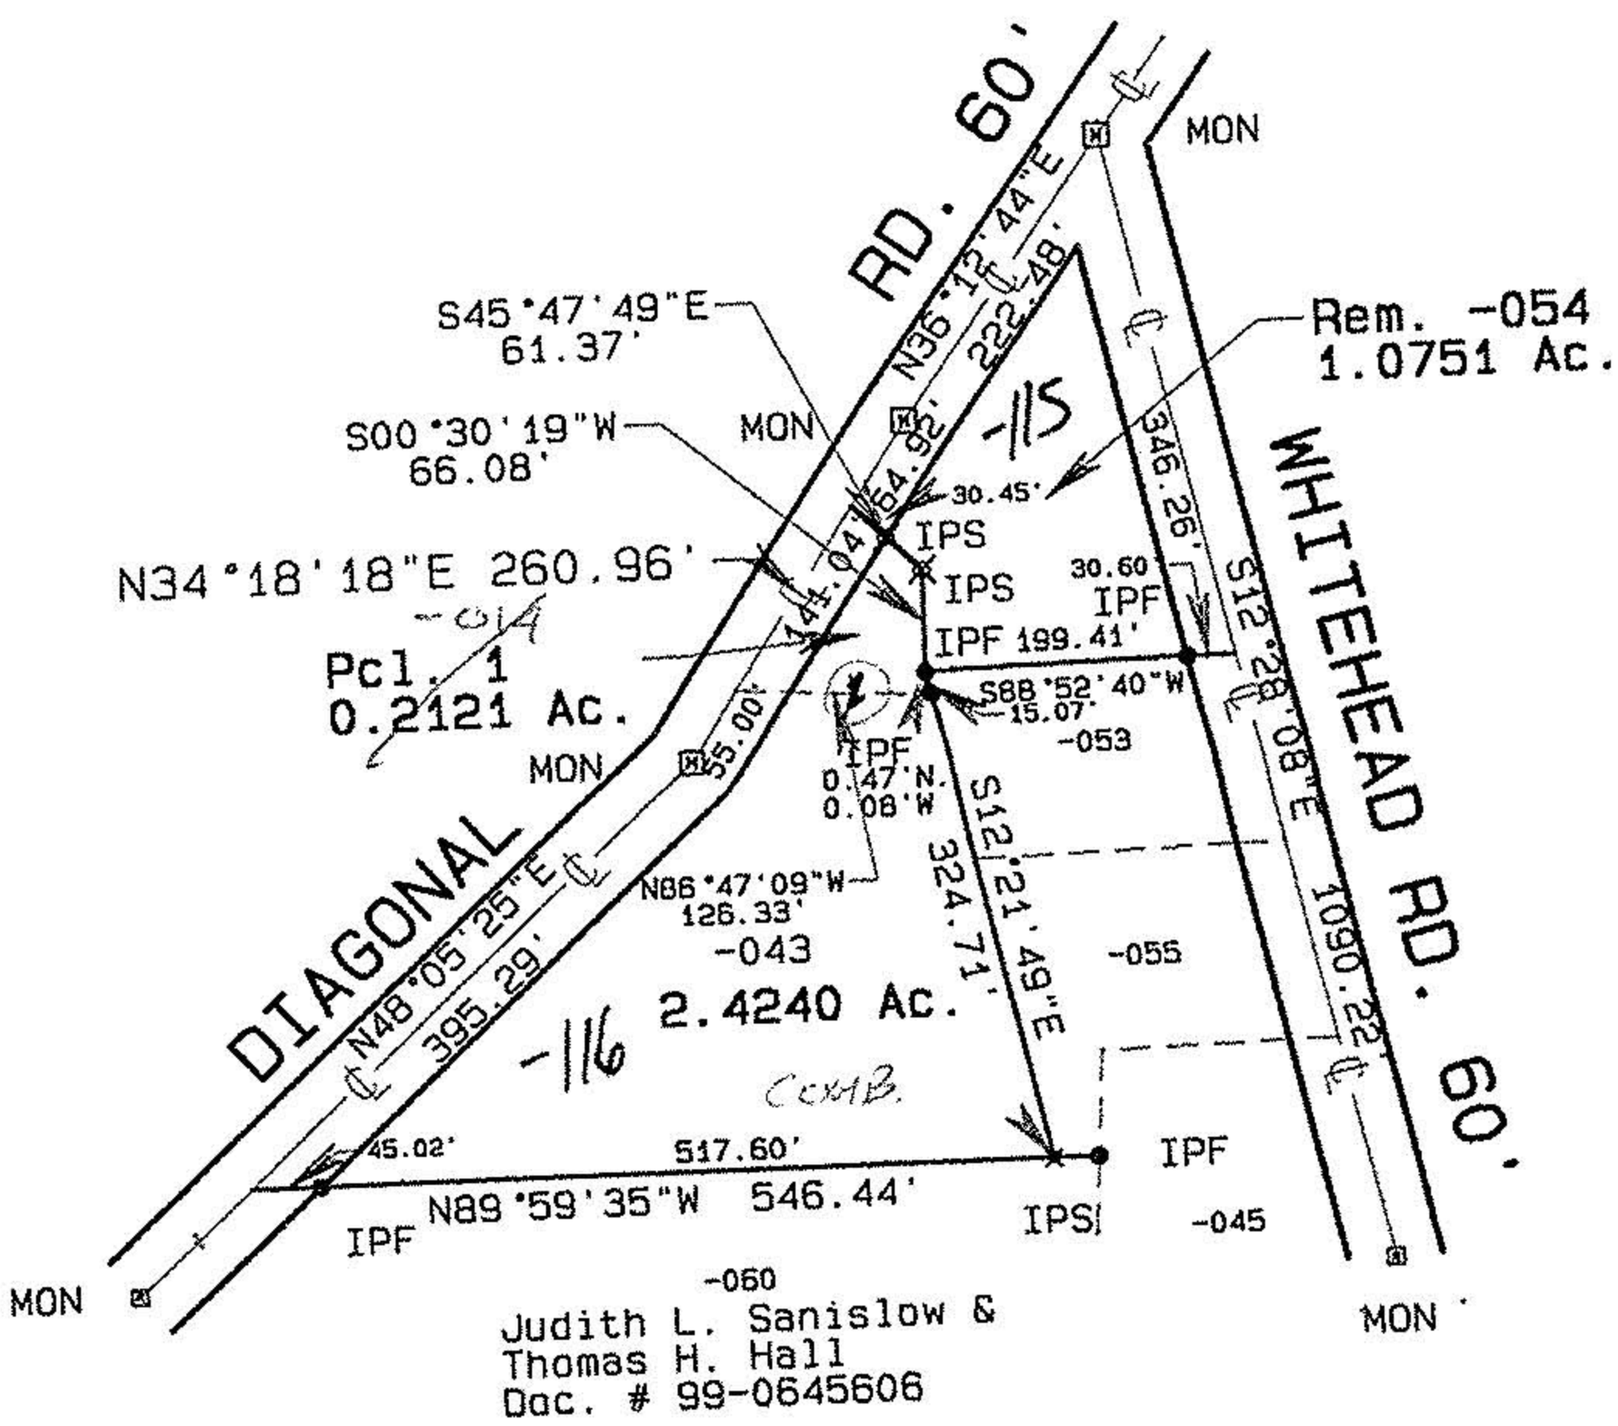

Judith L. Sanislow &
Thomas H. Hall
Doc. # 99-0645606

STATE OF OHIO
RICHARD D. CARLSON
7496
REGISTERED SURVEYOR
9-4-03

SURVEY FOR

JOHN COX

Section 19 Carlisle Twp.

Lorain Co. Ohio

CARLSON SURVEYS
August 5, 2003

No 01473

APPROVED
LORAIN CO.
MAP DEPT

DATE 9-24-03

PAGE 10-F

BY JHAtfield

03-01473