


**SURVEYOR'S CERTIFICATE**  
 SITUATED IN THE TOWNSHIP OF CARLISLE, COUNTY OF LORAIN, STATE OF OHIO, KNOW ALL MEN BY THESE PRESENTS, THAT I, THE UNDERSIGNED, DO HEREBY CERTIFY THAT I HAVE SURVEYED THE PREMISES AND PREPARED THIS MAP AND THAT SAID MAP IS CORRECT.

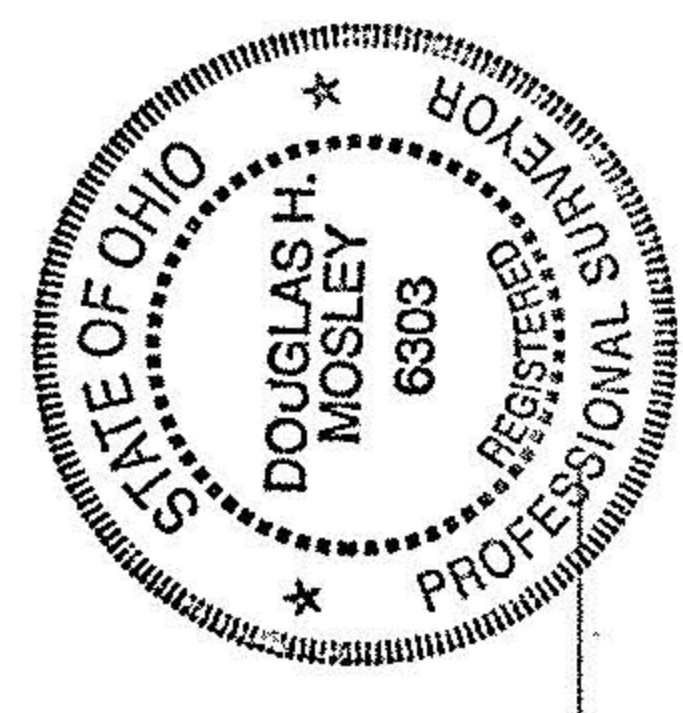

*Douglas Mosley*  
 DOUGLAS MOSLEY  
 REGISTERED SURVEYOR NO. 6303

**LEGEND OF SYMBOLS & LINETYPES**

- IRON PIN
- ⊙ CENTERLINE
- ℞ RIGHT-OF-WAY LINE
- ▭ MONUMENT BOX
- CENTERLINE RIGHT-OF-WAY
- RIGHT-OF-WAY LINE
- PROPERTY LINE
- PROPOSED PROPERTY



#00292

APPROVED	#99-00292
LORAIN CO. MAP DEPT.	
DATE 12-30-99	BY <i>[Signature]</i>
PAGE 10 of 15-D	

**BOUNDARY SURVEY & LOT SPLIT**  
 PART OF CARLISLE TOWNSHIP LOT 15  
 CITY OF ELYRIA, COUNTY OF LORAIN,  
 STATE OF OHIO

PREPARED FOR  
 SPITZER DEVELOPMENT  
 150 E. BRIDGE ST.  
 ELYRIA OHIO, 44036

PREPARED BY  
 BRAMHALL ENGINEERING &  
 SURVEYING CO., INC.  
 37307 HARVEST DRIVE  
 AVON OHIO, 44011

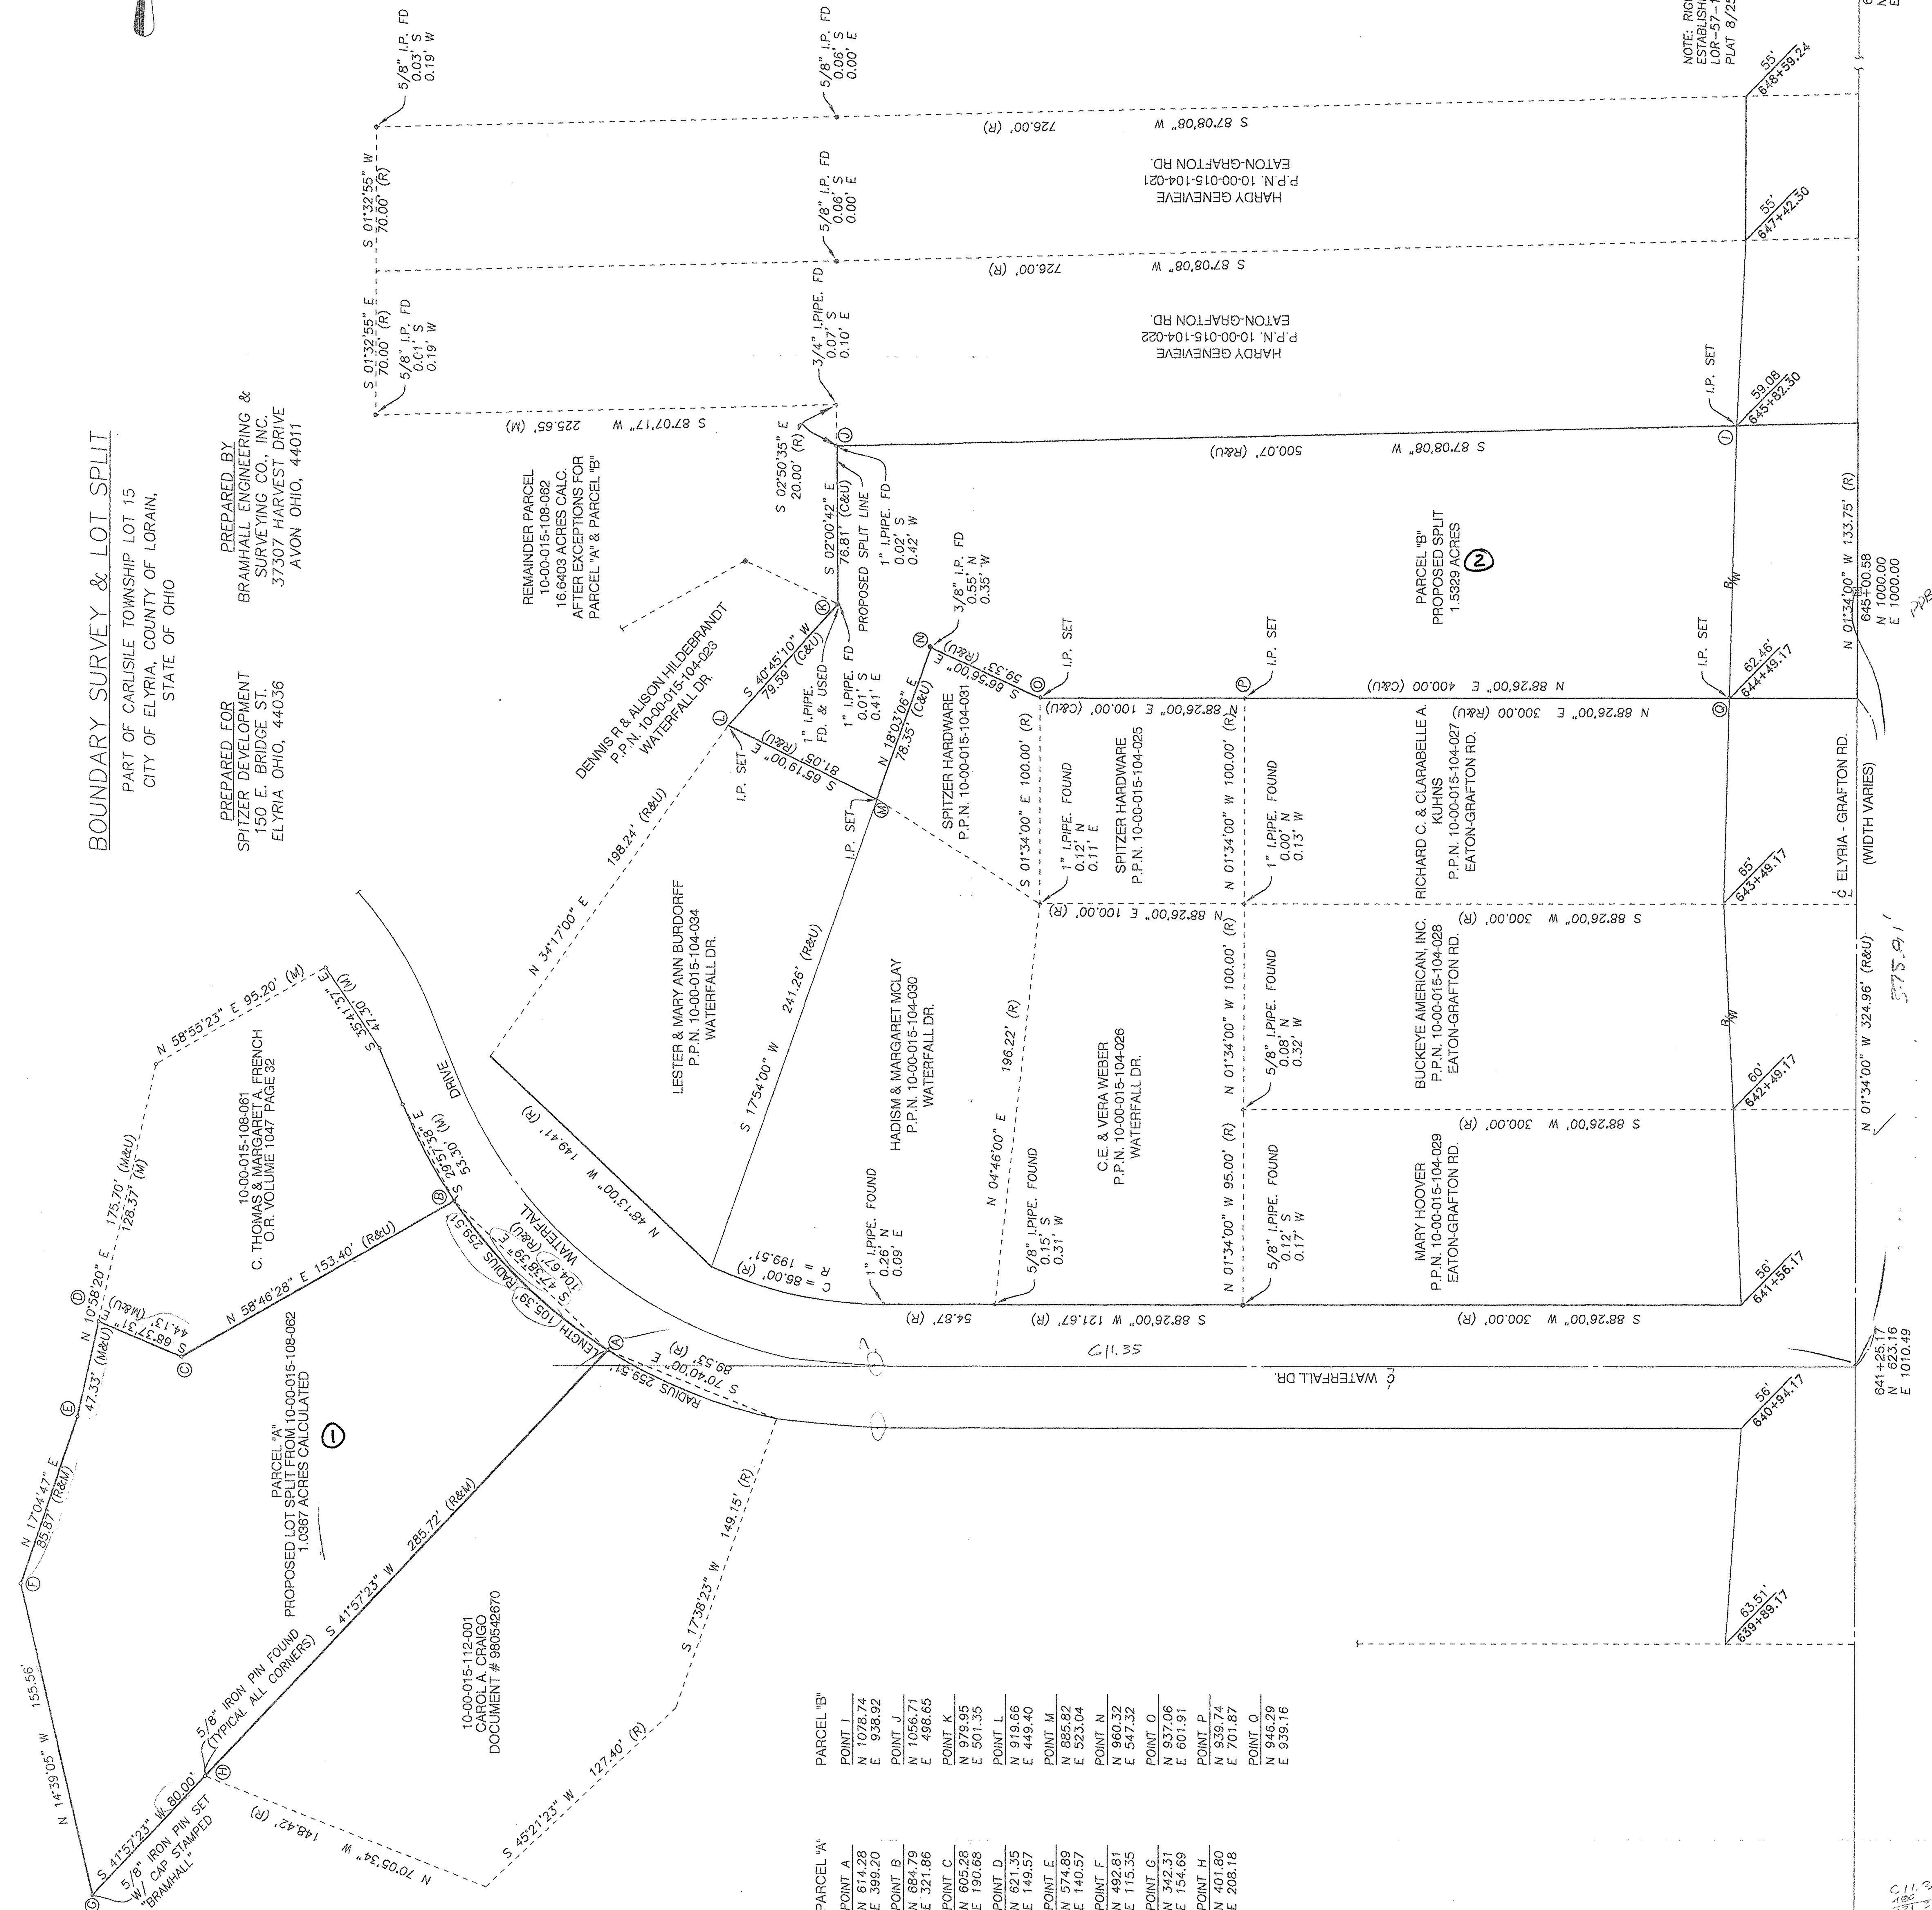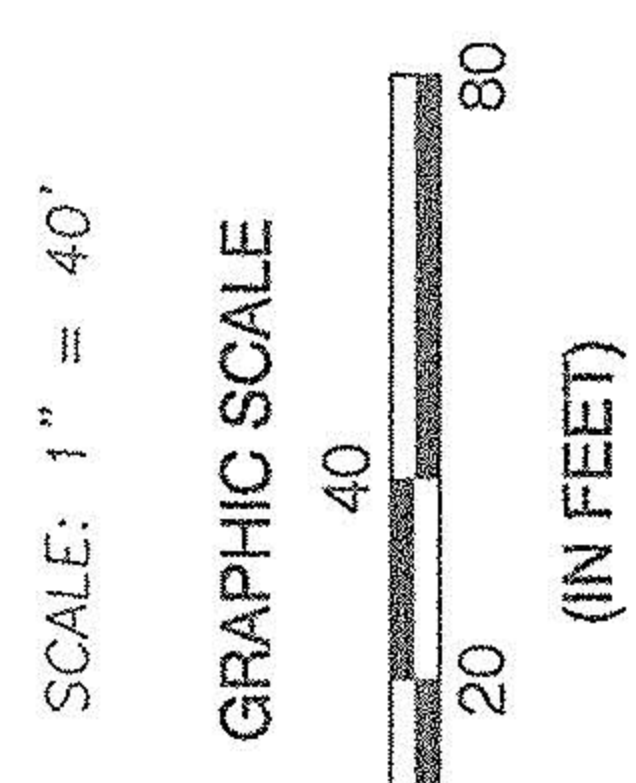

PARCEL "A"		PARCEL "B"	

DATE: 08/08/99  
 JOB NO. 98-448

NOTE: RIGHT-OF-WAY LIMITS ESTABLISHED PER 0007 PROJECT LOR-57-117, RIGHT OF WAY PLAT 8/25/61

634+28.19

641+26.17  
 N 01°34'00" W  
 E 1010.49

642+49.17  
 S 88°26'00" W  
 E 300.00

643+49.17  
 S 88°26'00" W  
 E 300.00

644+49.17  
 E 300.00