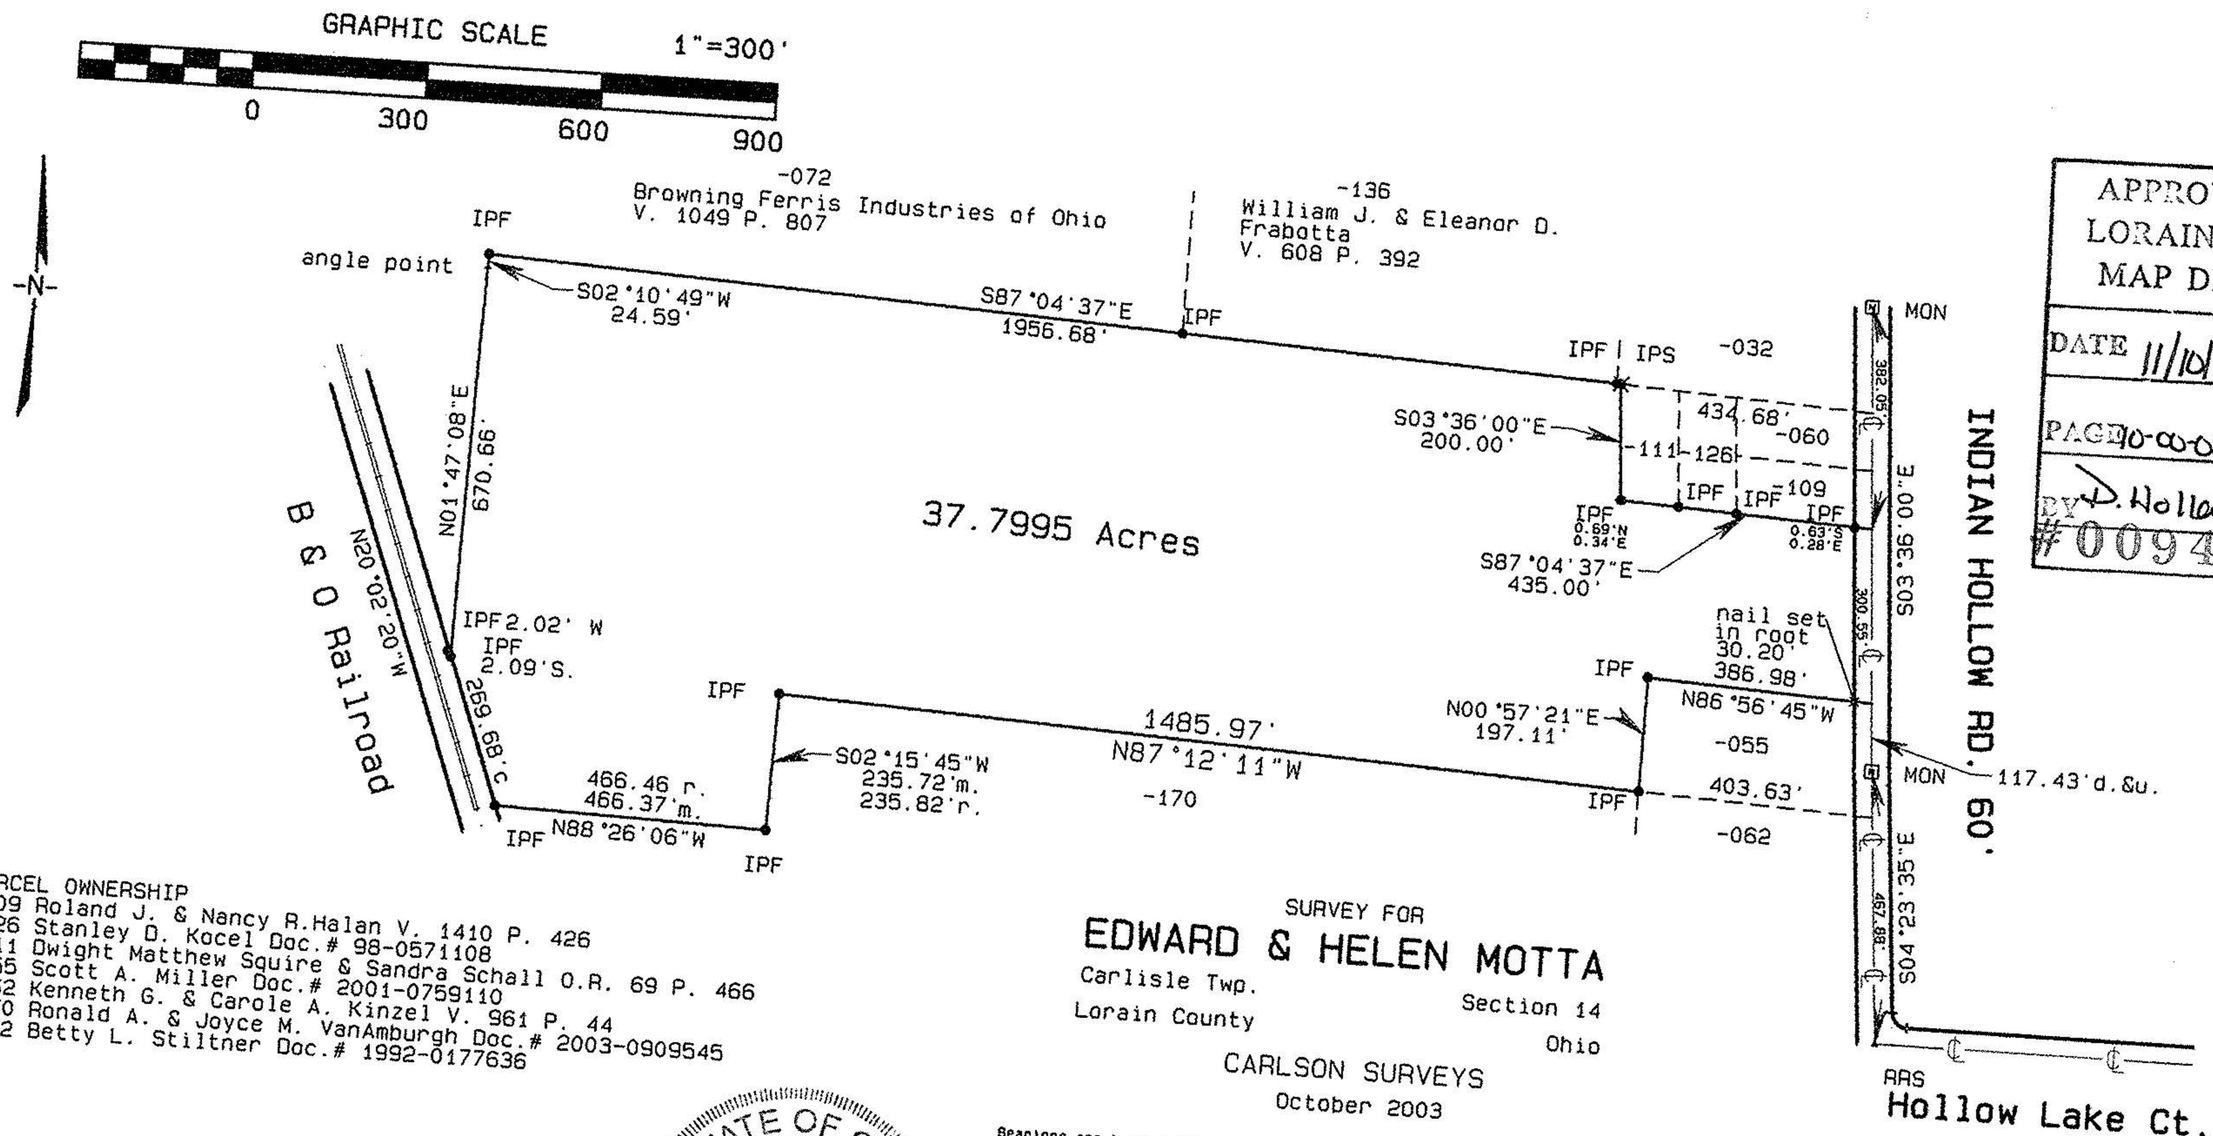

APPROVED
LORAIN CO.
MAP DEPT
DATE 11/10/03
PAGE 10-00-014-B
BY D. Holland
#00943-A

PARCEL OWNERSHIP
-109 Roland J. & Nancy R.Halan V. 1410 P. 426
-126 Stanley D. Kocel Doc.# 98-0571108
-111 Dwight Matthew Squire & Sandra Schall O.R. 69 P. 466
-055 Scott A. Miller Doc.# 2001-0759110
-062 Kenneth G. & Carole A. Kinzel V. 961 P. 44
-170 Ronald A. & Joyce M. VanAmburgh Doc.# 2003-0909545
-032 Betty L. Stiltner Doc.# 1992-0177636

SURVEY FOR
EDWARD & HELEN MOTTA
Carlisle Twp.
Lorain County
Section 14
Ohio

CARLSON SURVEYS
October 2003

Bearings are to an assumed meridian and used to indicate angles only.
Basis of bearings is the bearing for the centerline of Indian Hollow Road as found in Deed Volume 1410 page 426.
This Plat of Survey represents the minimum standards for bounday surveys in the State of Ohio as adopted 5-1-80 of the Administrative Code chapter 4733-37.

STATE OF OHIO
RICHARD D. CARLSON
7496
REGISTERED SURVEYOR
10-30-03