Assumed

GRAPHIC SCALE 1"=200'

0 200 400 600

Survey For
Greg & Karen Bonk
Penfield Twp. Tract 6, O.L. 42
Lorain County Ohio
Carlson Surveys 440-926-0200

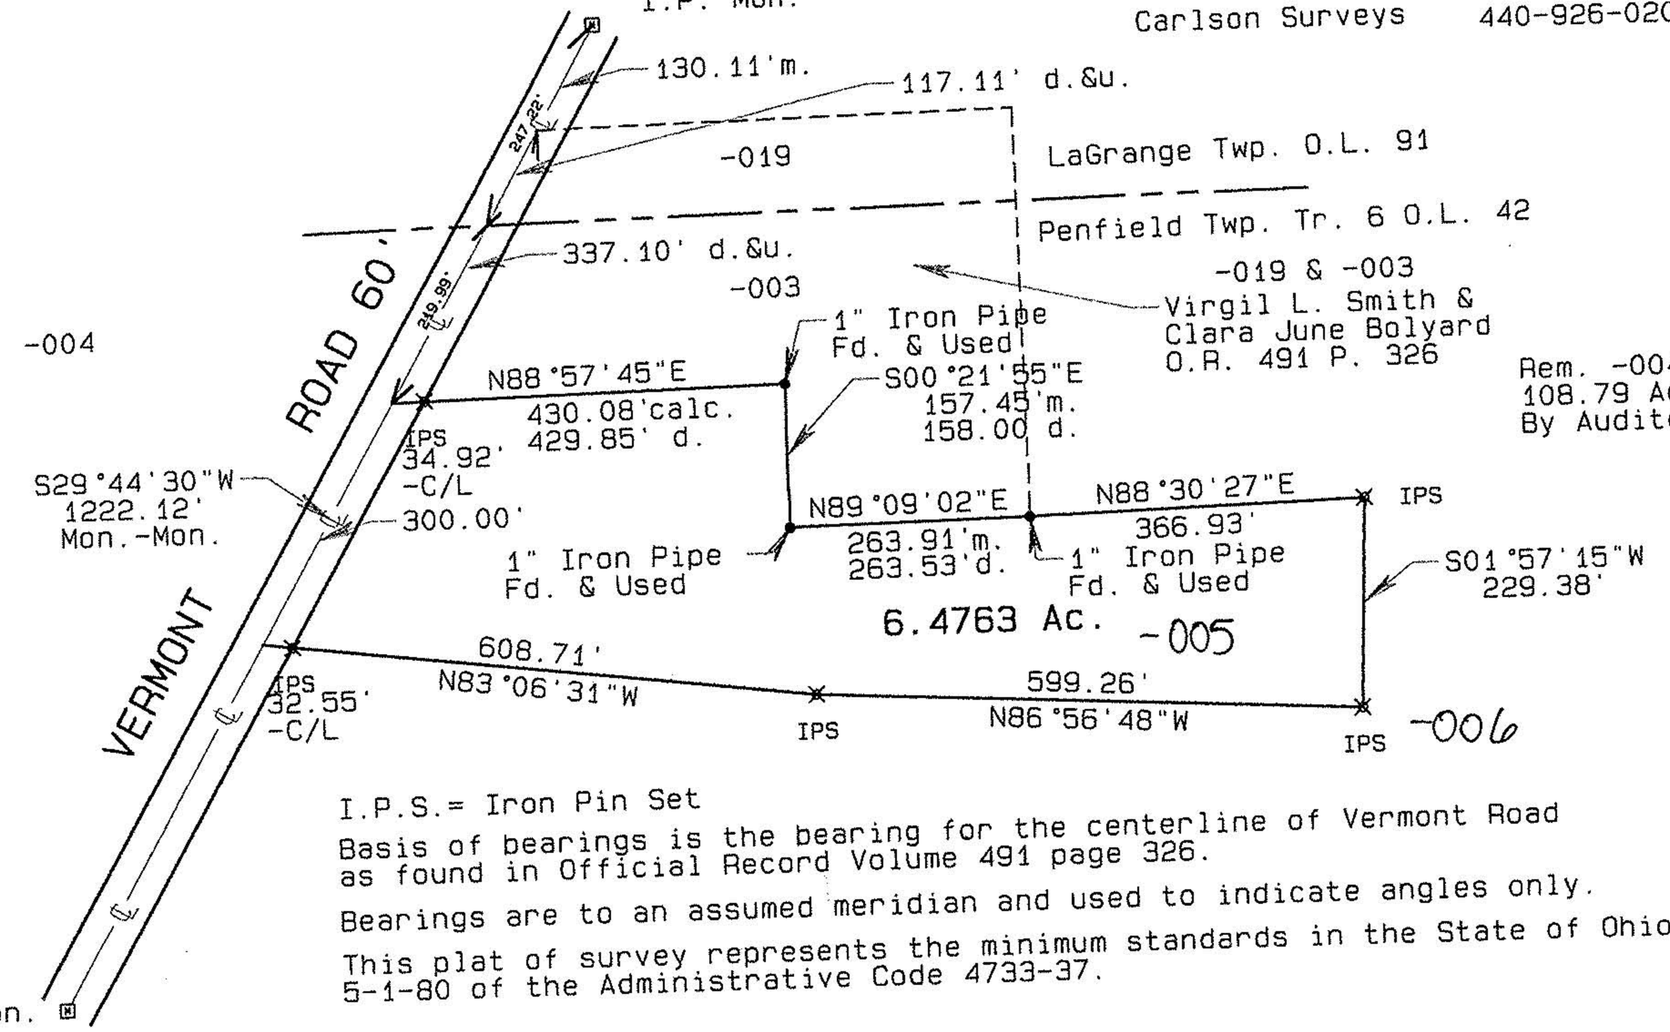

STATE OF OHIO
RICHARD D CARLSON
7496
REGISTERED SURVEYOR
5-19-03

№01385

APPROVED
LORAIN CO.
MAP DEPT

DATE 6-9-03

PAGE 19-D

BY J HATFIELD

#03-01385

I.P.S.= Iron Pin Set

Basis of bearings is the bearing for the centerline of Vermont Road as found in Official Record Volume 491 page 326.

Bearings are to an assumed meridian and used to indicate angles only.

This plat of survey represents the minimum standards in the State of Ohio as adopted 5-1-80 of the Administrative Code 4733-37.