



SURVEY FOR
BARNEY HARTMAN
 93.93 Ac.
 HENRIETTA TWP O.L.99
 LORAIN COUNTY OHIO
 CARLSON SURVEYS
 Rev. 5-20-04 P.L. 748
 Rev. 5-21-04 P.L. 11

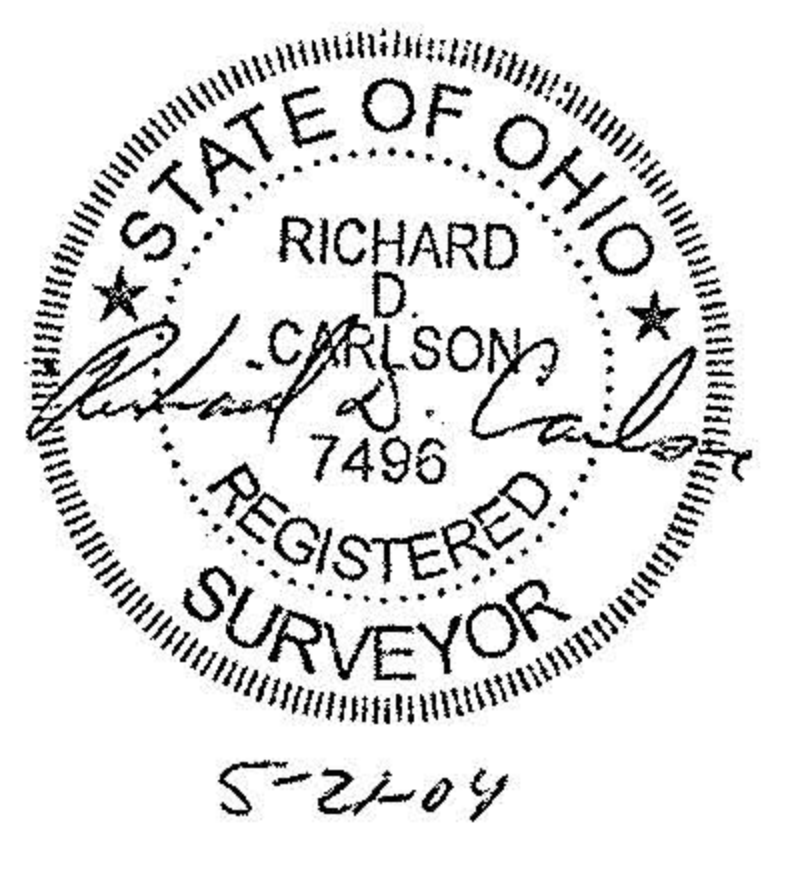


O.L. 98
-017

O.L. 3
-006

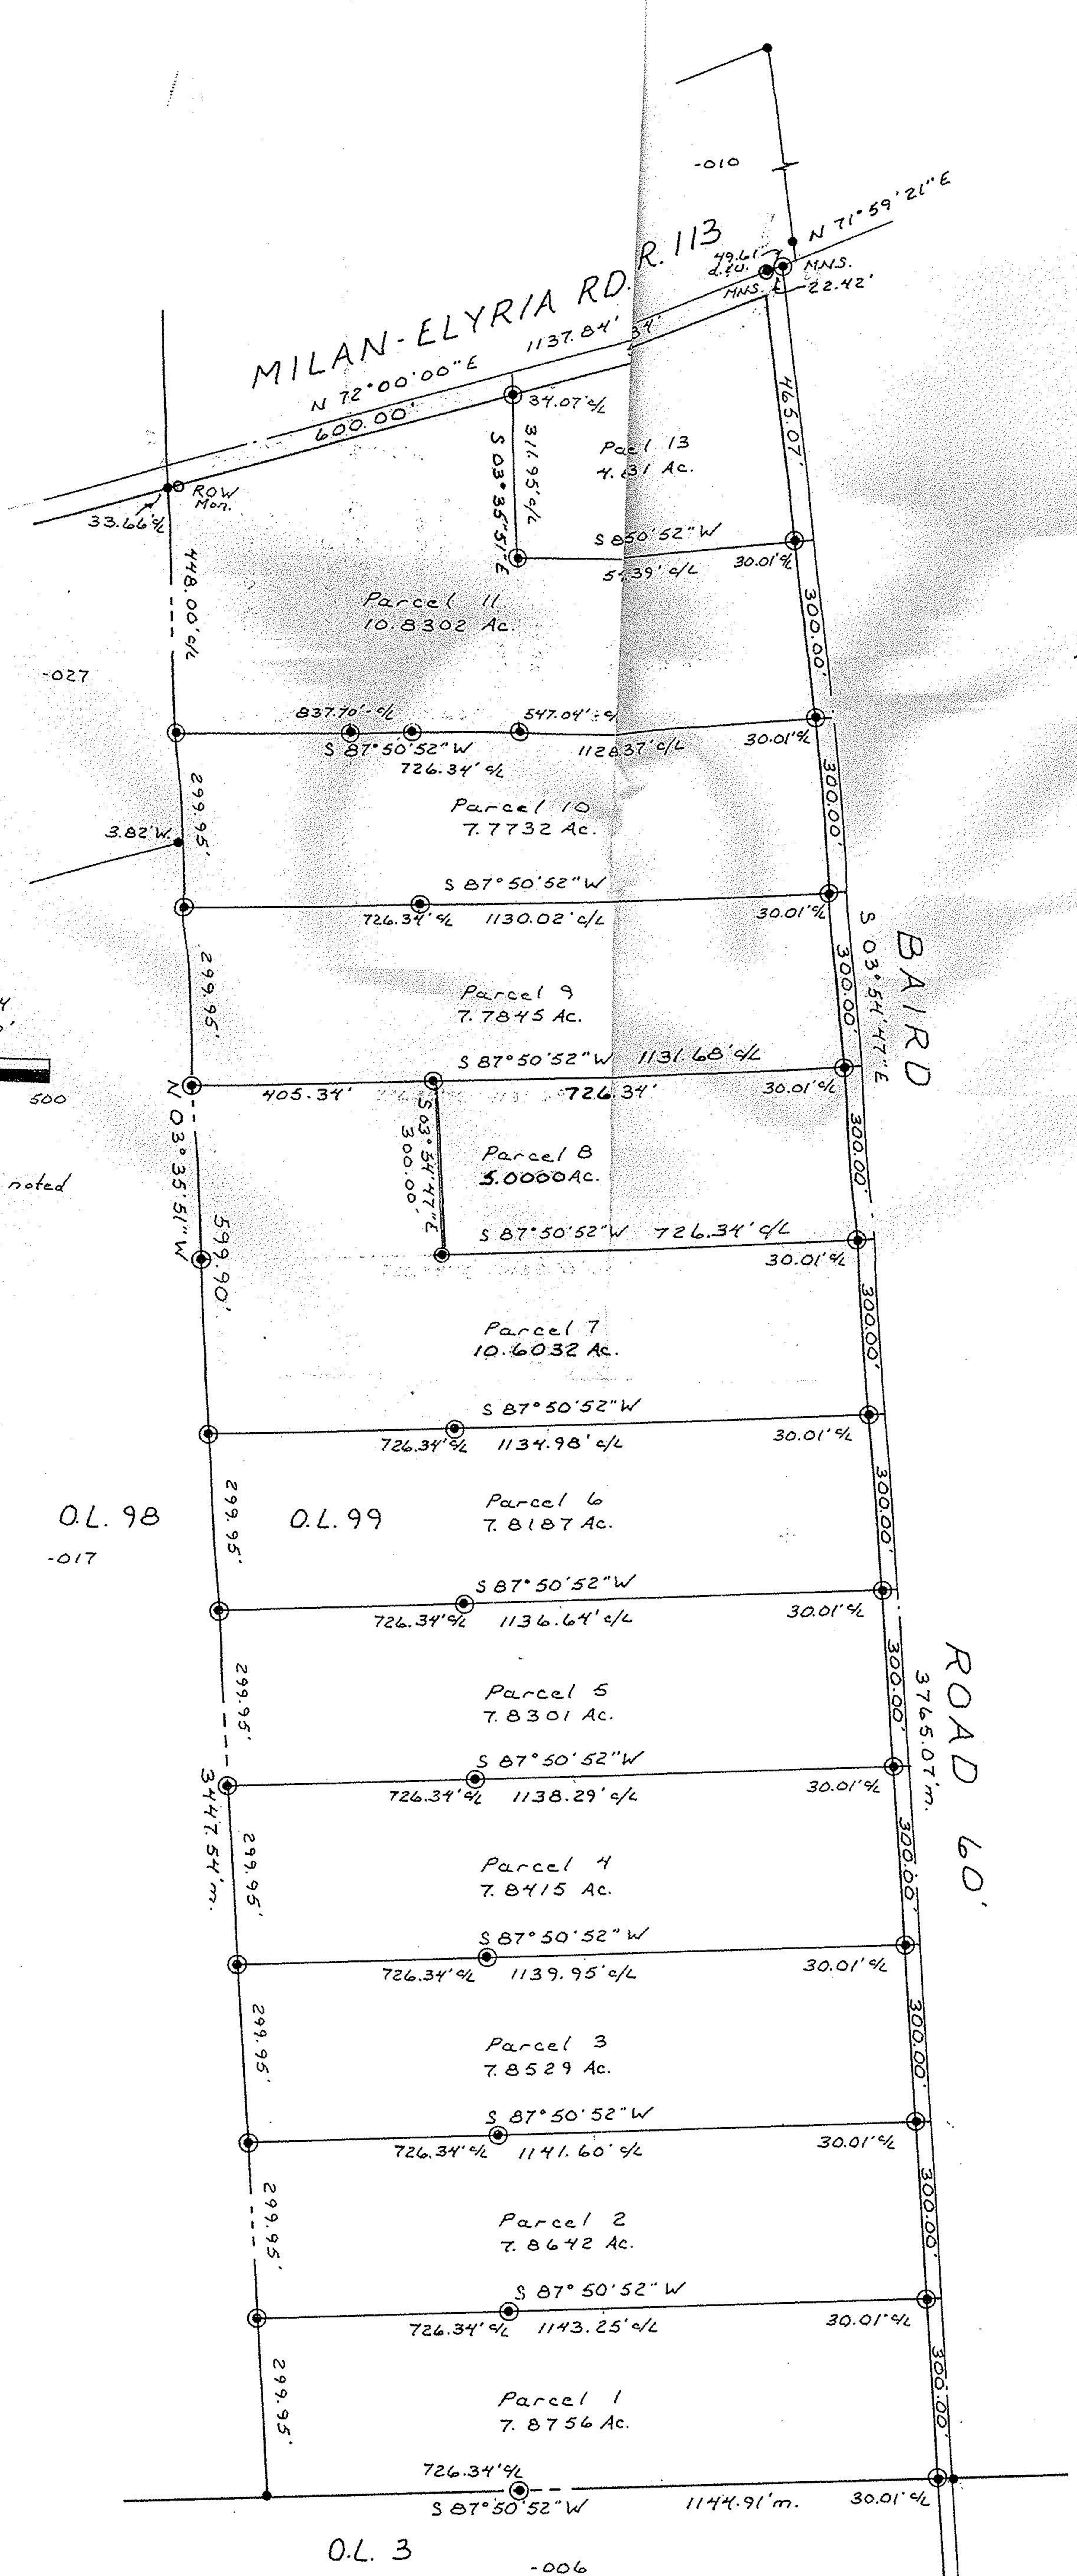

No 01675
 APPROVED
 LORAIN CO. MAP DEPT
 DATE 6-7-04
 PAGE 8-00-09-A
 BY JHathfield
 #04-01675

SURVEY FOR
BARNEY HARTMAN
 93.93 Ac.
 HENRIETTA TWP O.L.99
 LORAIN COUNTY OHIO
 CARLSON SURVEYS
 Rev. 5-20-04 P.L. 748
 Rev. 5-21-04 P.L. 11

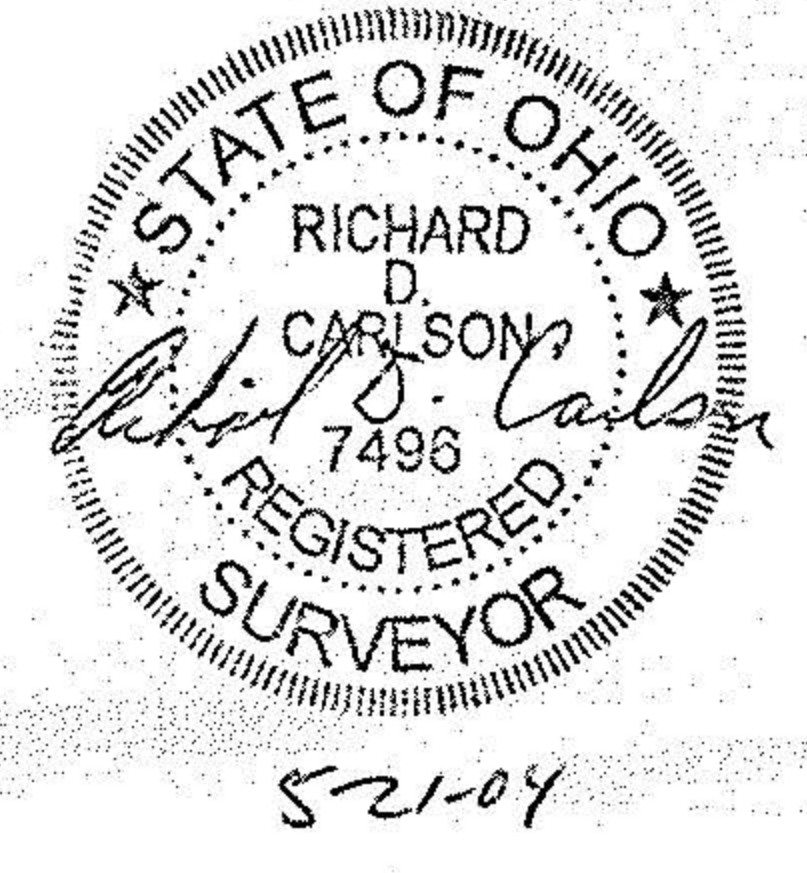

O.L. 98
-017

O.L. 3
-006