№ 01675

APPROVED
LORAIN CO.
MAP DEPT.
DATE 6-7-04
PAGE 8-00-099-A
BY JHatfield
#04-01675

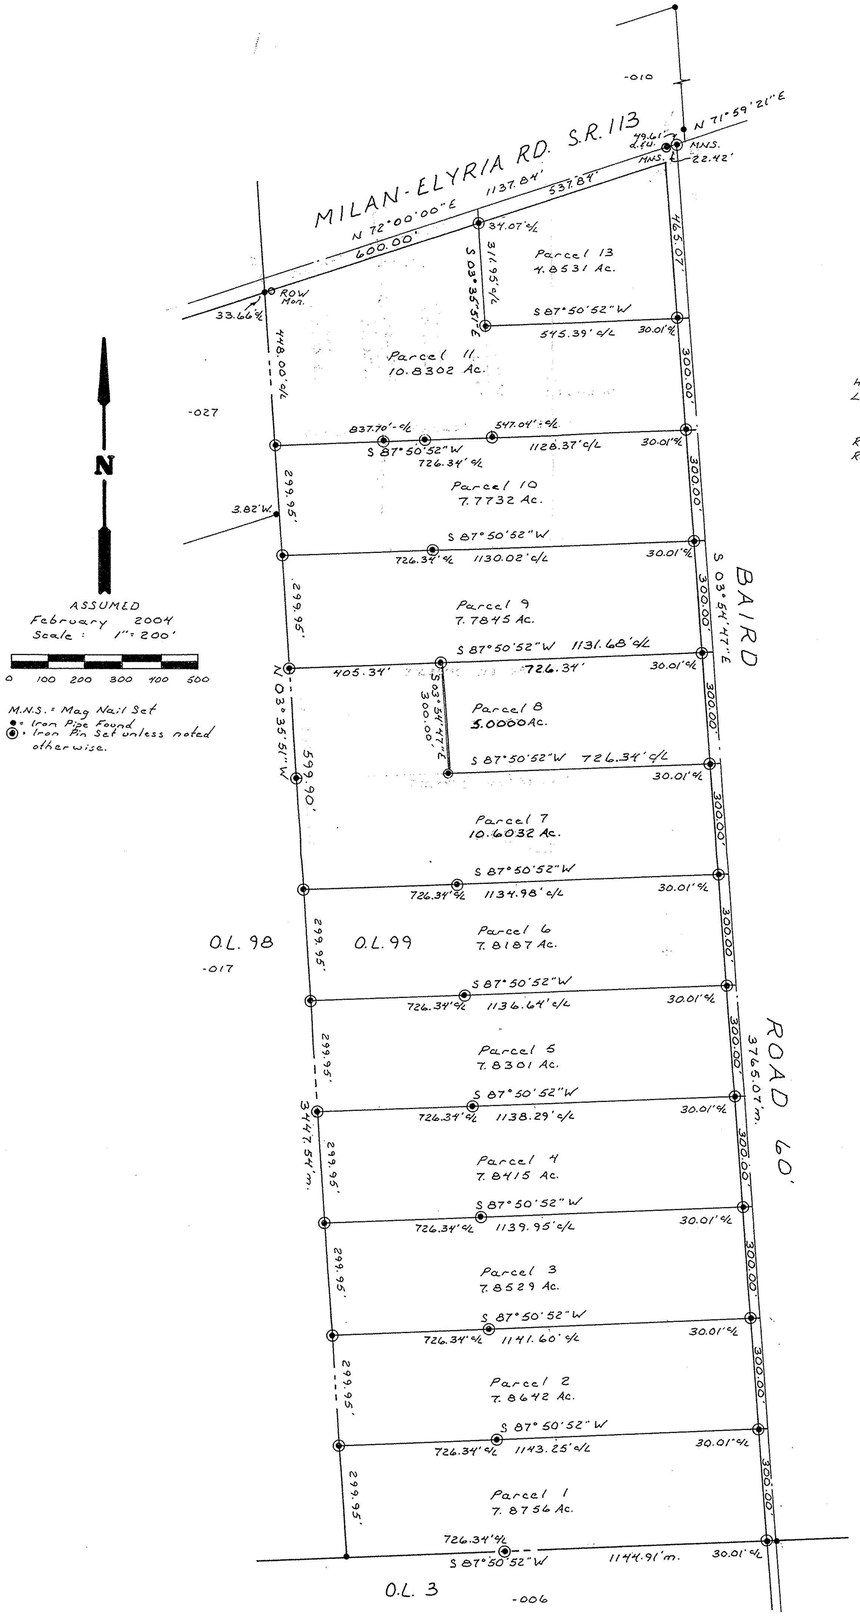

SURVEY FOR
BARNEY HARTMAN
93.93 Ac.

HENRIETTA TWP. O.L.99
LORAIN COUNTY OHIO

CARLSON SURVEYS

Rev. 5-20-04 Pcl. 7&8
Rev. 5-21-04 Pcl. 11

STATE OF OHIO
RICHARD D. CARLSON
7496
REGISTERED SURVEYOR

5-21-04

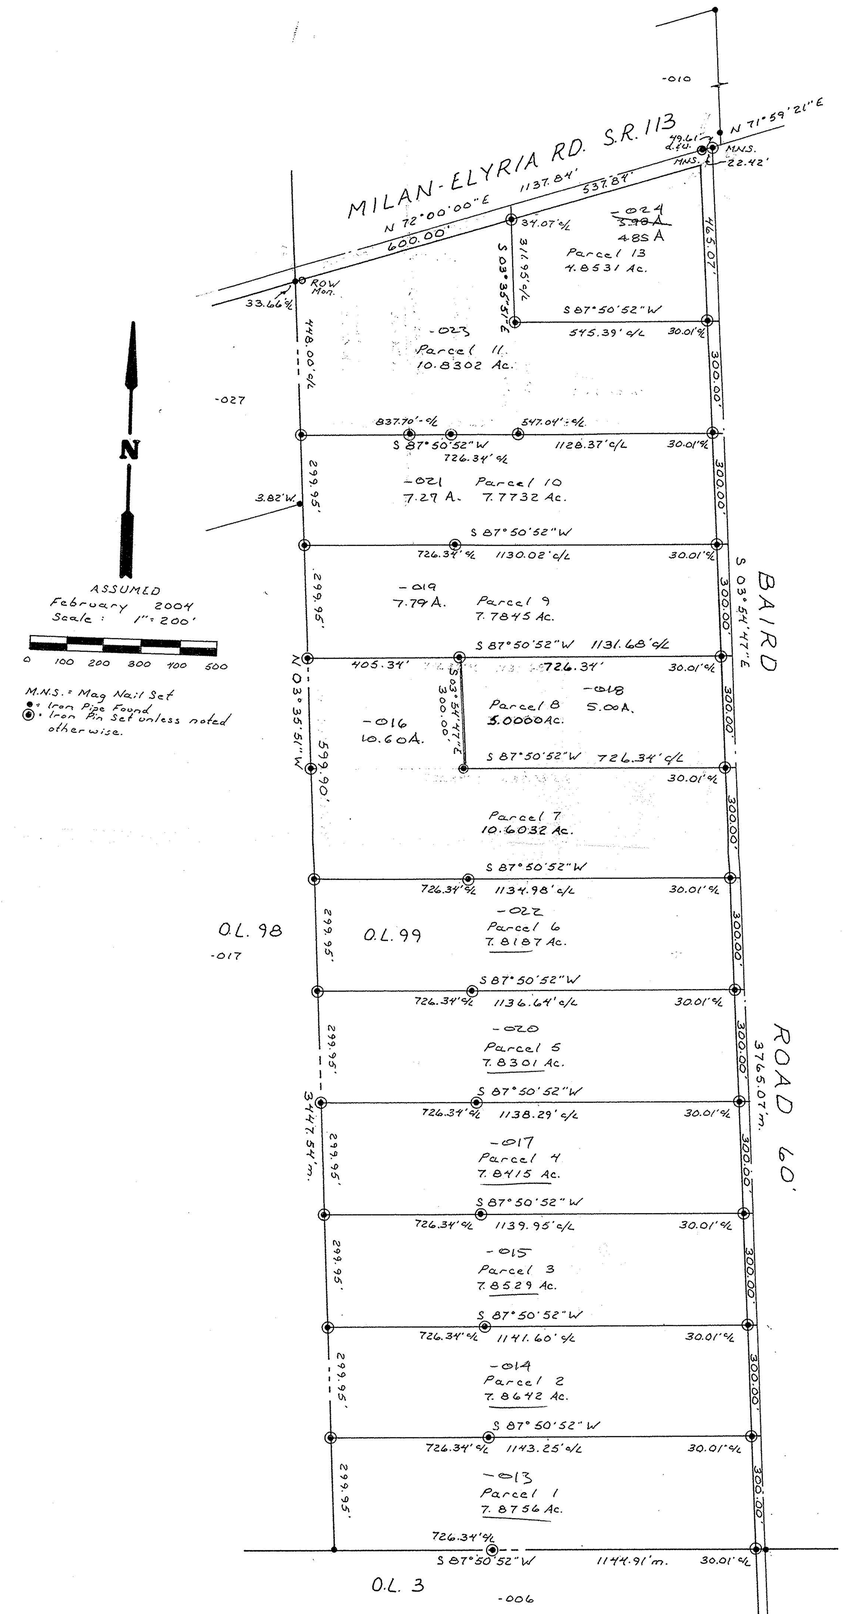

SURVEY FOR
BARNEY HARTMAN
93.93 Ac.

HENRIETTA TWP. O.L.99
LORAIN COUNTY OHIO

CARLSON SURVEYS

Rev. 5-20-04 Pcl. 7&8
Rev. 5-21-04 Pcl. 11

STATE OF OHIO
RICHARD D. CARLSON
7496
REGISTERED SURVEYOR

5-21-04

-099-000-023,024,021,019,018,01
022,017,01