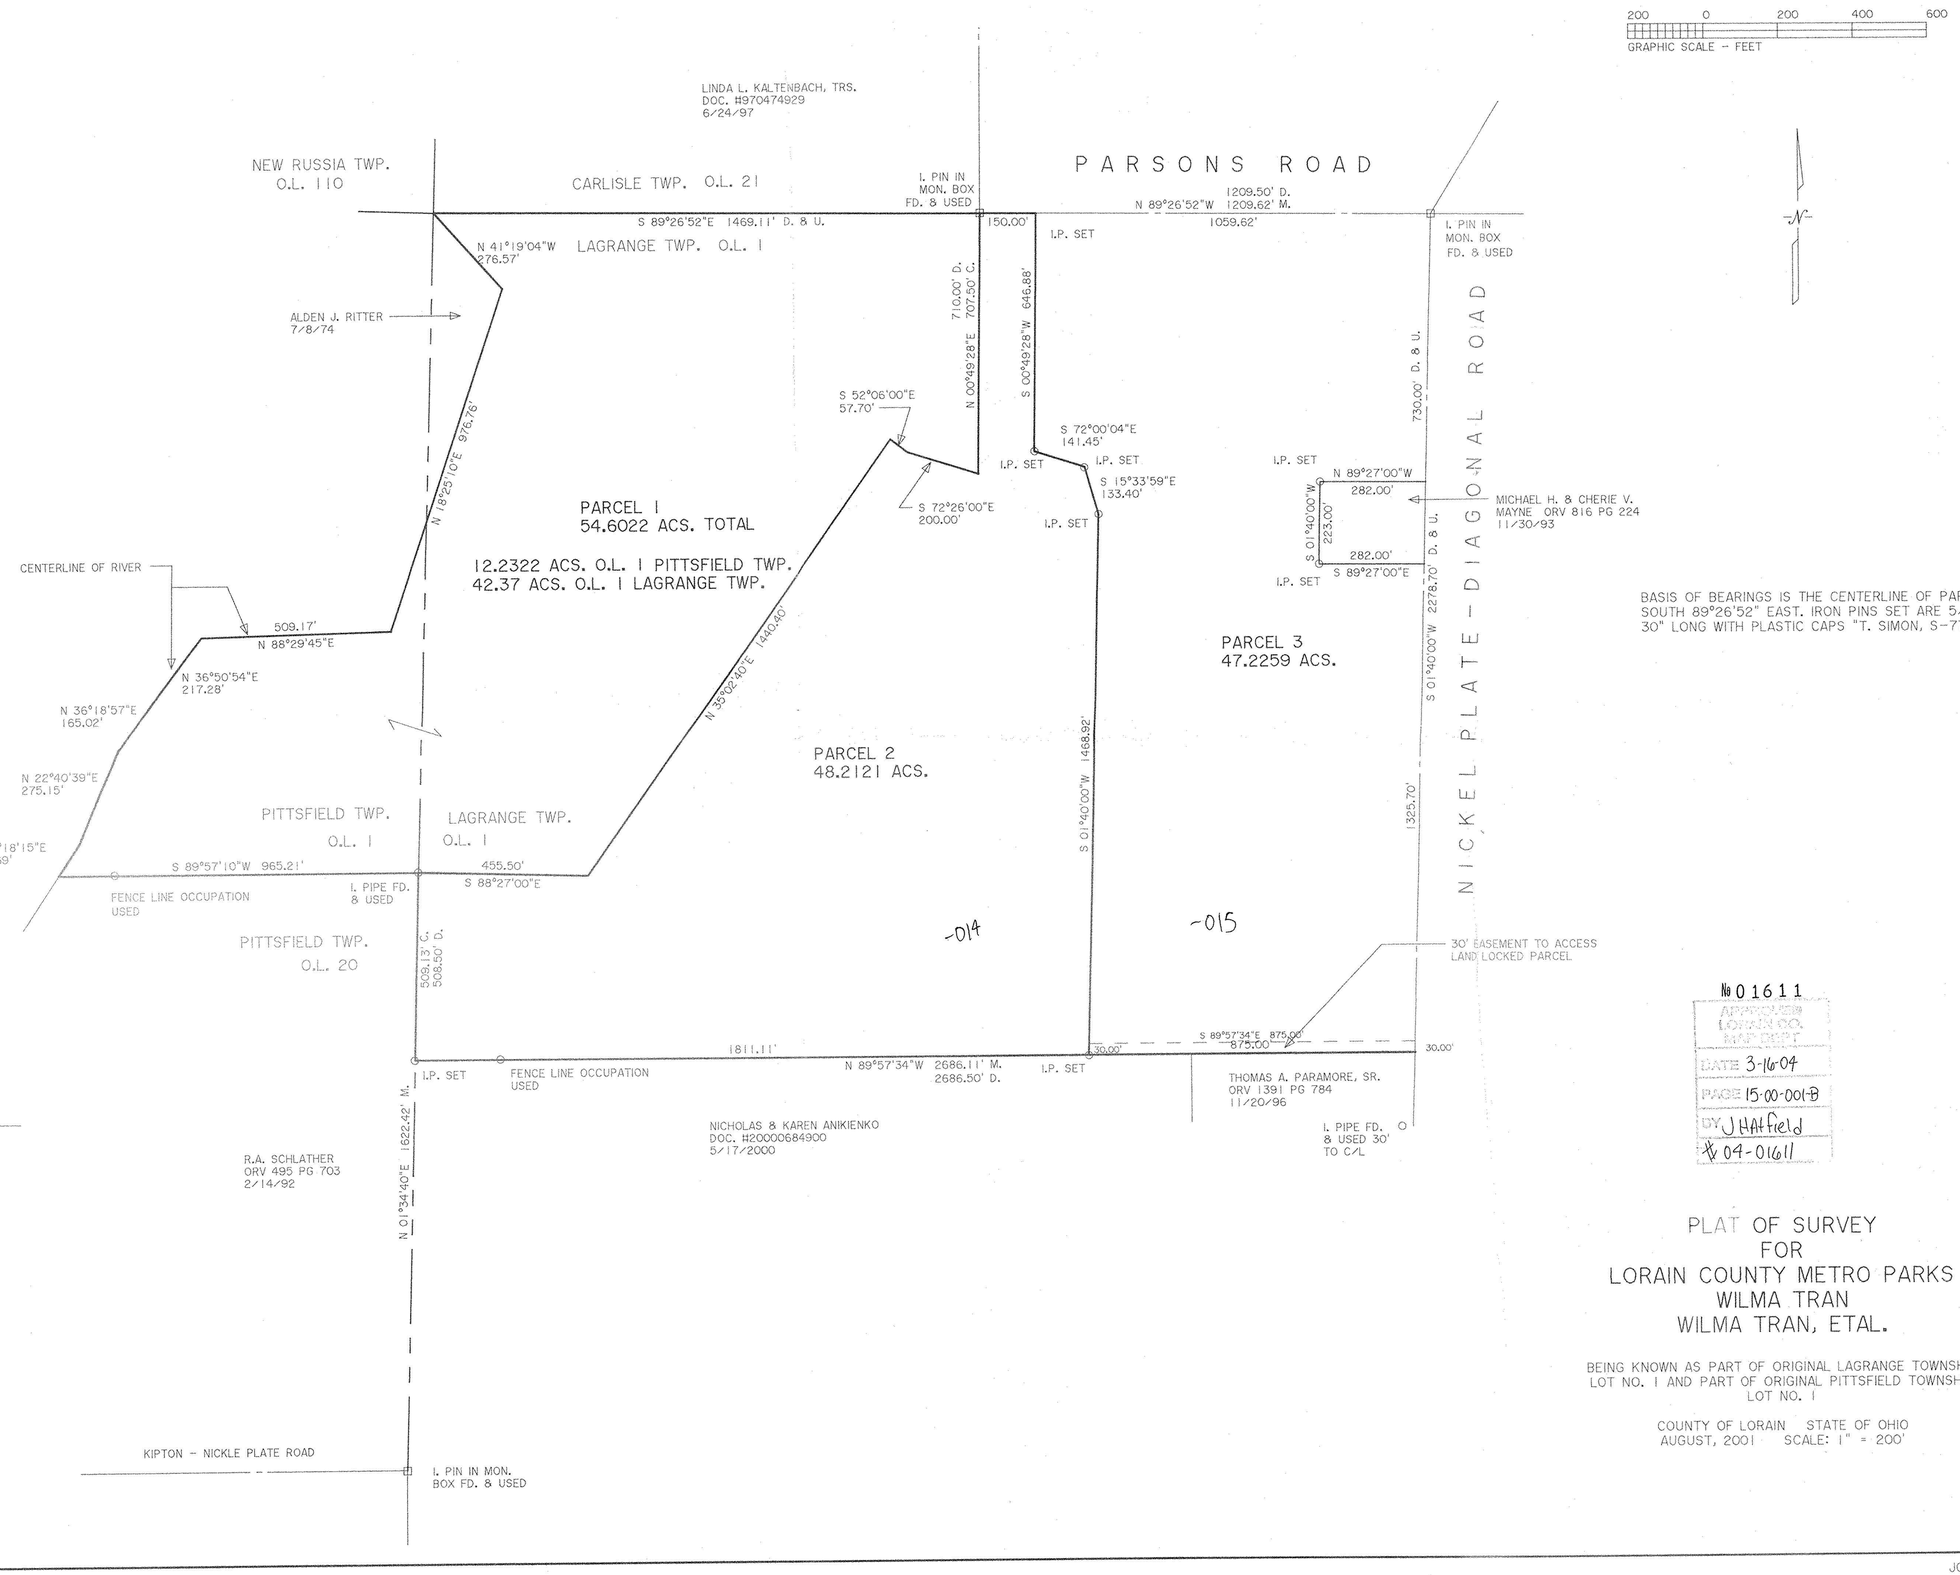

BASIS OF BEARINGS IS THE CENTERLINE OF PARSONS ROAD SOUTH 89°26'52" EAST. IRON PINS SET ARE 5/8" DIAMETER 30" LONG WITH PLASTIC CAPS "T. SIMON, S-7775".

DIMENSIONS SHOWN ON THIS PLAT ARE EXPRESSED IN FEET AND DECIMAL PARTS THEREOF, ALL BEARINGS ARE TO AN ASSUMED MERIDIAN AND ARE USED TO INDICATE ANGLES ONLY. PERMANENT MONUMENTS WERE FOUND OR SET AT ALL POINTS INDICATED HEREON, ALL OF WHICH I CERTIFY TO BE CORRECT.

THOMAS A. SIMON
REG. PROFESSIONAL SURVEYOR
NO. S-7775

STATE OF OHIO THOMAS A. SIMON S-7775 REGISTERED PROFESSIONAL SURVEYOR

№ 01611
APPROVED LORAIN CO. MAP DEPT.
DATE 3-16-04
PAGE 15-00-001-B
BY J Hatfield
04-01611

PLAT OF SURVEY
FOR
LORAIN COUNTY METRO PARKS
WILMA TRAN
WILMA TRAN, ETAL.

BEING KNOWN AS PART OF ORIGINAL LAGRANGE TOWNSHIP LOT NO. 1 AND PART OF ORIGINAL PITTSFIELD TOWNSHIP LOT NO. 1

COUNTY OF LORAIN STATE OF OHIO
AUGUST, 2001 SCALE: 1" = 200'

THOMAS SIMON & ASSOCIATES, INC.
PROFESSIONAL LAND SURVEYORS

COBBLESTONE CORNER PROFESSIONAL CENTER
39049 CENTER RIDGE ROAD
NORTH RIDGEVILLE, OHIO 44039
(440) 327-2925
FAX 327-2964

JOB NO. 2001-054