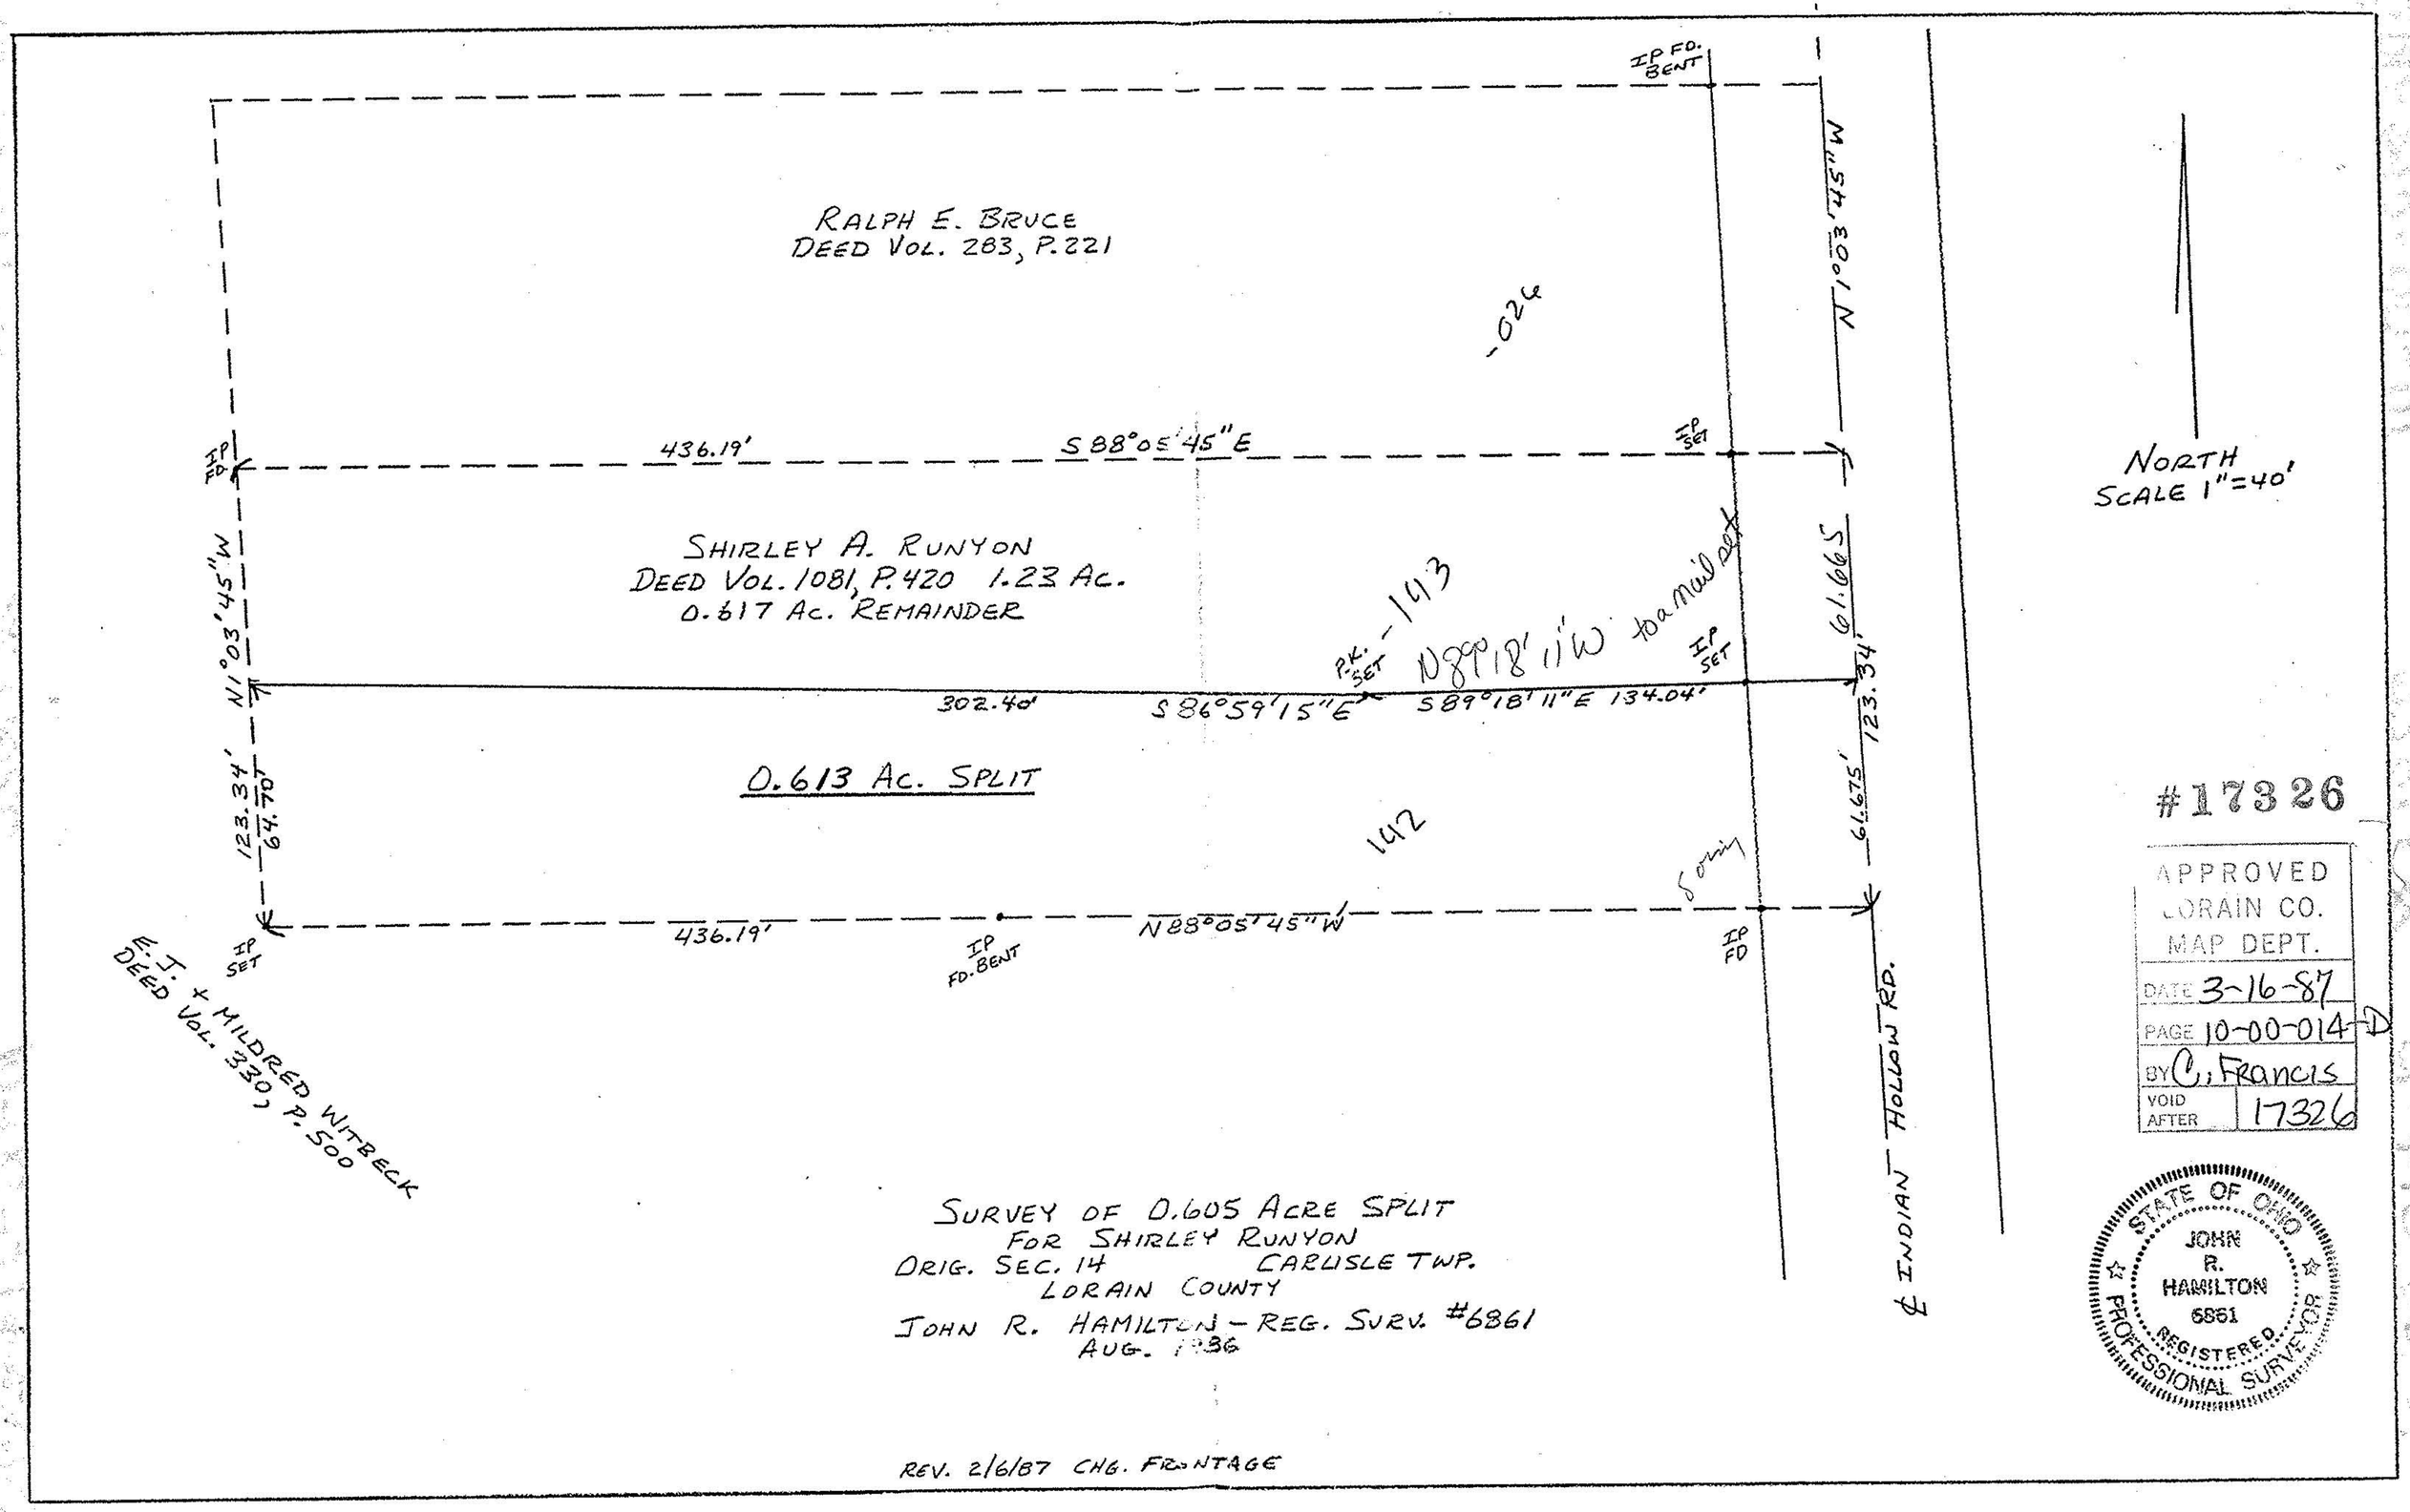

RALPH E. BRUCE
DEED VOL. 283, P.221
IP FD. BENT
N 1°03'45"W
-026
IP FD
436.19'
S 88°05'45"E
IP SET
NORTH
SCALE 1"=40'
SHIRLEY A. RUNYON
DEED VOL. 1081, P.420 1.23 AC.
0.617 AC. REMAINDER
N1°03'45"W
-143
P.K. SET
N89°18'11"W to a mail set
IP SET
61.665
302.40'
S 86°59'15"E
S89°18'11"E 134.04'
123.34'
0.613 AC. SPLIT
123.34'
64.70'
142
61.675'
436.19'
N88°05'45"W
IP SET
IP FD. BENT
IP FD
E.J. + MILDRED WITBECK
DEED VOL. 330, P.500
℄ INDIAN HOLLOW RD.
SURVEY OF 0.605 ACRE SPLIT
FOR SHIRLEY RUNYON
ORIG. SEC. 14 CARLISLE TWP.
LORAIN COUNTY
JOHN R. HAMILTON - REG. SURV. #6861
AUG. 1986
REV. 2/6/87 CHG. FRONTAGE
#17326
APPROVED
LORAIN CO.
MAP DEPT.
DATE 3-16-87
PAGE 10-00-014-D
BY C. Francis
VOID AFTER 17326
STATE OF OHIO
JOHN R. HAMILTON
6861
REGISTERED
PROFESSIONAL SURVEYOR