

Iron Pipe
Used
Cawley

N
S

2548.48 obs
Cawley & Reed

CAPEL ROAD 60'

REED RD.

Subd. 15 Countryside Subd.

Lawrence W & Kathryn Reynolds
11-00-018-000-045
Deed Vol. 1251, Pg 803

Subd. 1 Countryside Subd.

Lawrence W & Kathryn Reynolds
11-00-018-000-041
Deed Vol 1251, Pg 803

Benjamin & Mildred Estep
11-00-018-000-02C
Deed Vol 1, Pg 239

Lot # 2
700' x E
700' x E
4.02 Ac.

Lot # 3
50' 0.5" 14" W
420' 0.0"
12.32 Acres
Richard & Shirley Kountz
11-00-018-000-075

Richard & Shirley Kountz
11-00-019-000-029
4.51 Acres

600' 0.0" x E
50' 0.5" 14" W
Iron Pin Set

11-00-018-000-069
Douglas Crum
12.424 Ac


11-00-019-000-02C
500' Rec.
3.443 Acres

SEE BELOW
10-00-018-000-
-019-000-
11-00-018-000-
-019-000-

Petro & Teresa Mahley
11-00-023-000-11
Deed Vol 1385, Pg 254

N 0° 05' 14" E 2301.38' Deed & Used x E

#19193A
APPROVED
DRAIN CO.
MAP DEPT.
10-26-90
FRANCIS
#19193A

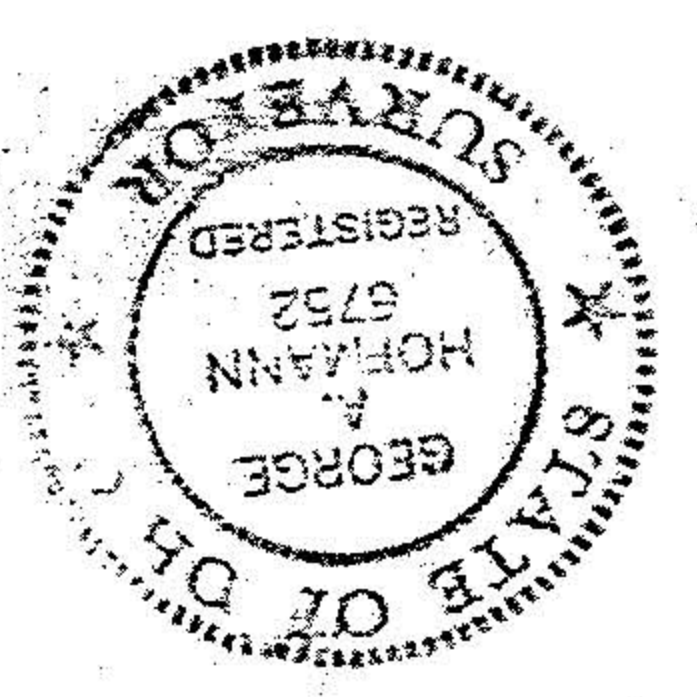

JAMES B. ROOT & ASSOCIATES
CONSULTING CIVIL ENGINEERS
By: George Hohnann

SCALE: 1"=200 DATE: DEC 1988
Revised Feb. 24, 1989

CLINT WILLIAMS REALTY
ORIGINAL EATON TOWNSHIP LOTS 18 & 19
LOBAIN COUNTY, OHIO
ORDER # 9777 F.B. 666 Pg. 62

AT THE INSTANCE OF
AND DOUGLAS CRUM
MADE FOR RICHARD & SHIRLEY KOUNTZ
OF PARCEL Nos 11-00-018-000-070 & 11-00-019-000-027