


BUTTERNUT RIDGE RD.  
P.V. 40 P 7

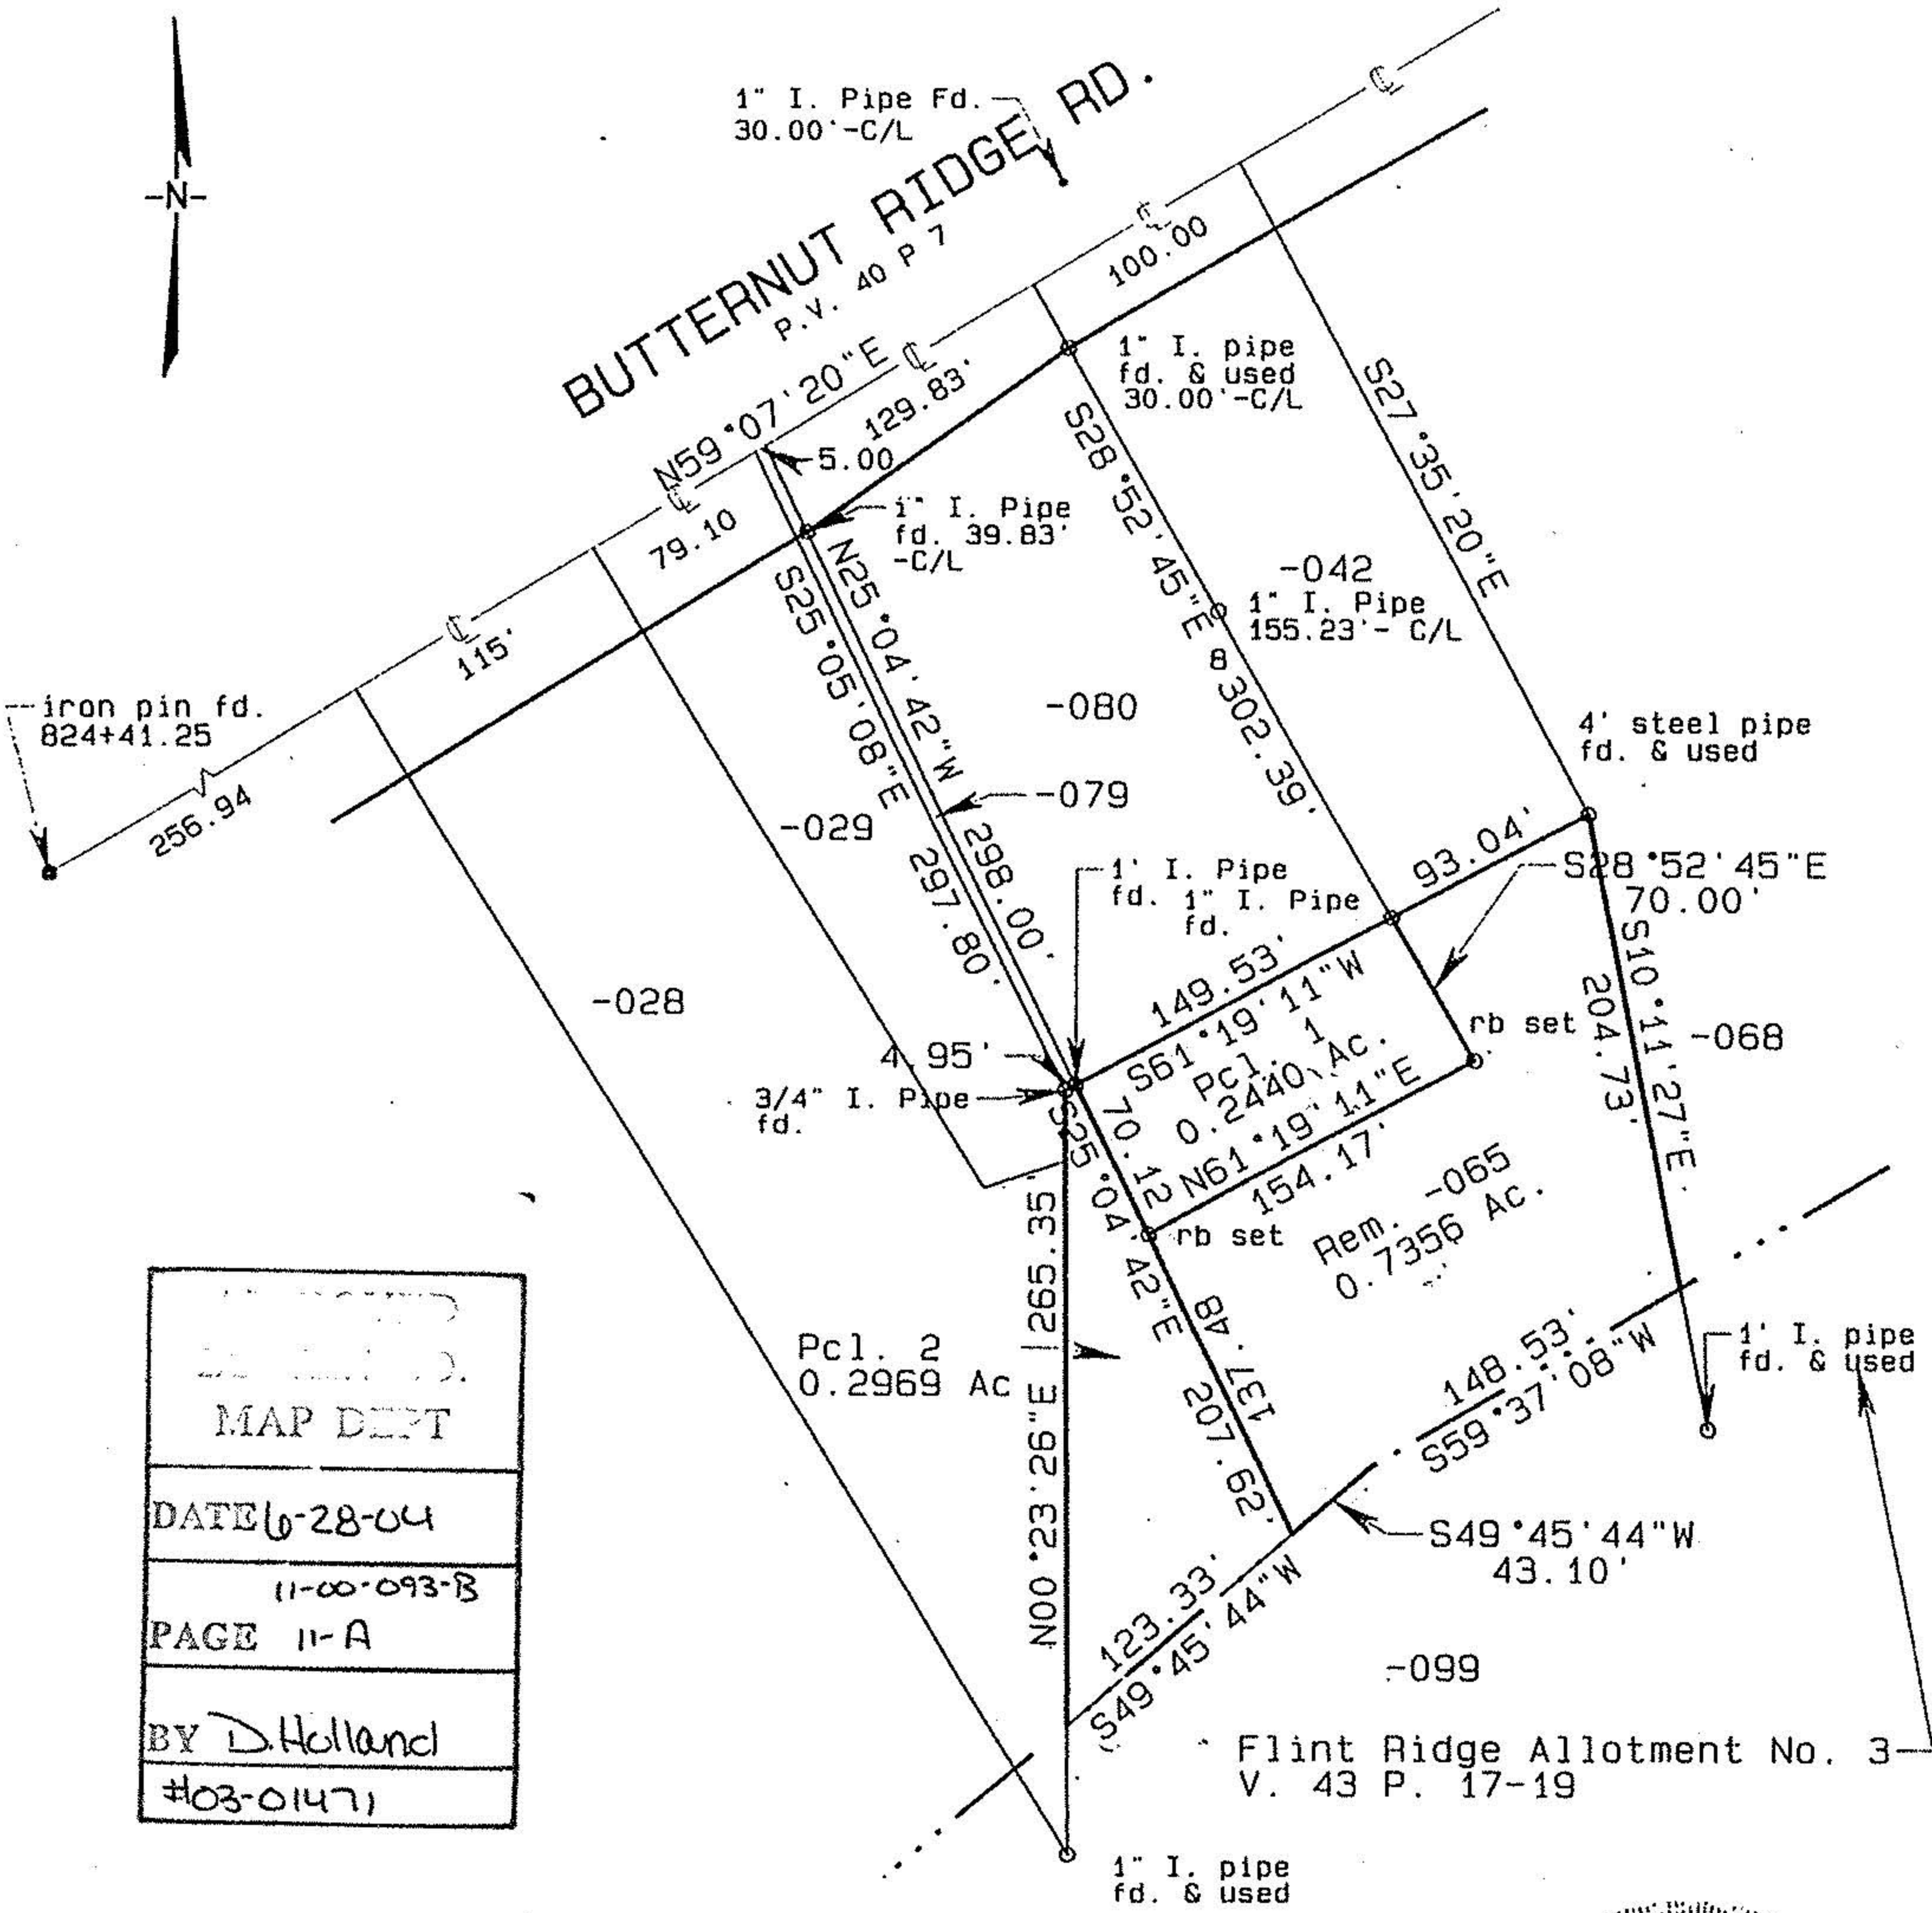

MAP DEPT  
DATE 6-28-04  
11-00-093-B  
PAGE 11-A  
BY D. Holland  
#03-01471

- 042 Harry A. Rizer Doc. # 2002-0852406 first parcel
- 068 Christopher P. Pilan O.R.V. 560 P. 101
- 099 Harry A. Rizer Doc. # 2002-0852406 parcel no. 2
- 028 Timothy & Diana S. Tyler O.R.V. 20 P. 544
- 029 Alvin L. & Carol J. Mains V. 1403 P. 493 pcl. 1
- 079 Alvin L. & Carol J. Mains V. 1403 P. 493 pcl. 2
- 080 Norma J. & Anthony W. McKenzie O.R.V. 1213 P. 846



Split of Pcl. -065 for Harry A. Rizer	
Scale: 1"=100	Eaton Twp. O.L. 93
Date: 12/10/2002	Lorain County, Ohio
Revised:	Drawn By: RDC
Job:	Surveyor: Carlson Surveys