03-00-047-103-029
4-030

DATE OF SURVEY: MAY, 2001

BASIS OF BEARINGS: Northerly R/W of Cleveland Street

REFERENCES: PLATS AS SHOWN
DEEDS
TAX MAPS

PART OF SULBOT 28 EUCLID ERIE PARK SUBDIVISION AND ADJACENT LANDS

SITUATED IN THE STATE OF OHIO, COUNTY OF LORAIN, ORIGINAL SHEFFIELD TOWNSHIP LOT NO. 47

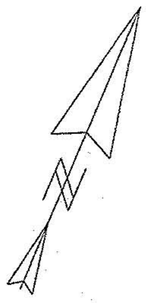

SCALE: 1" = 30'

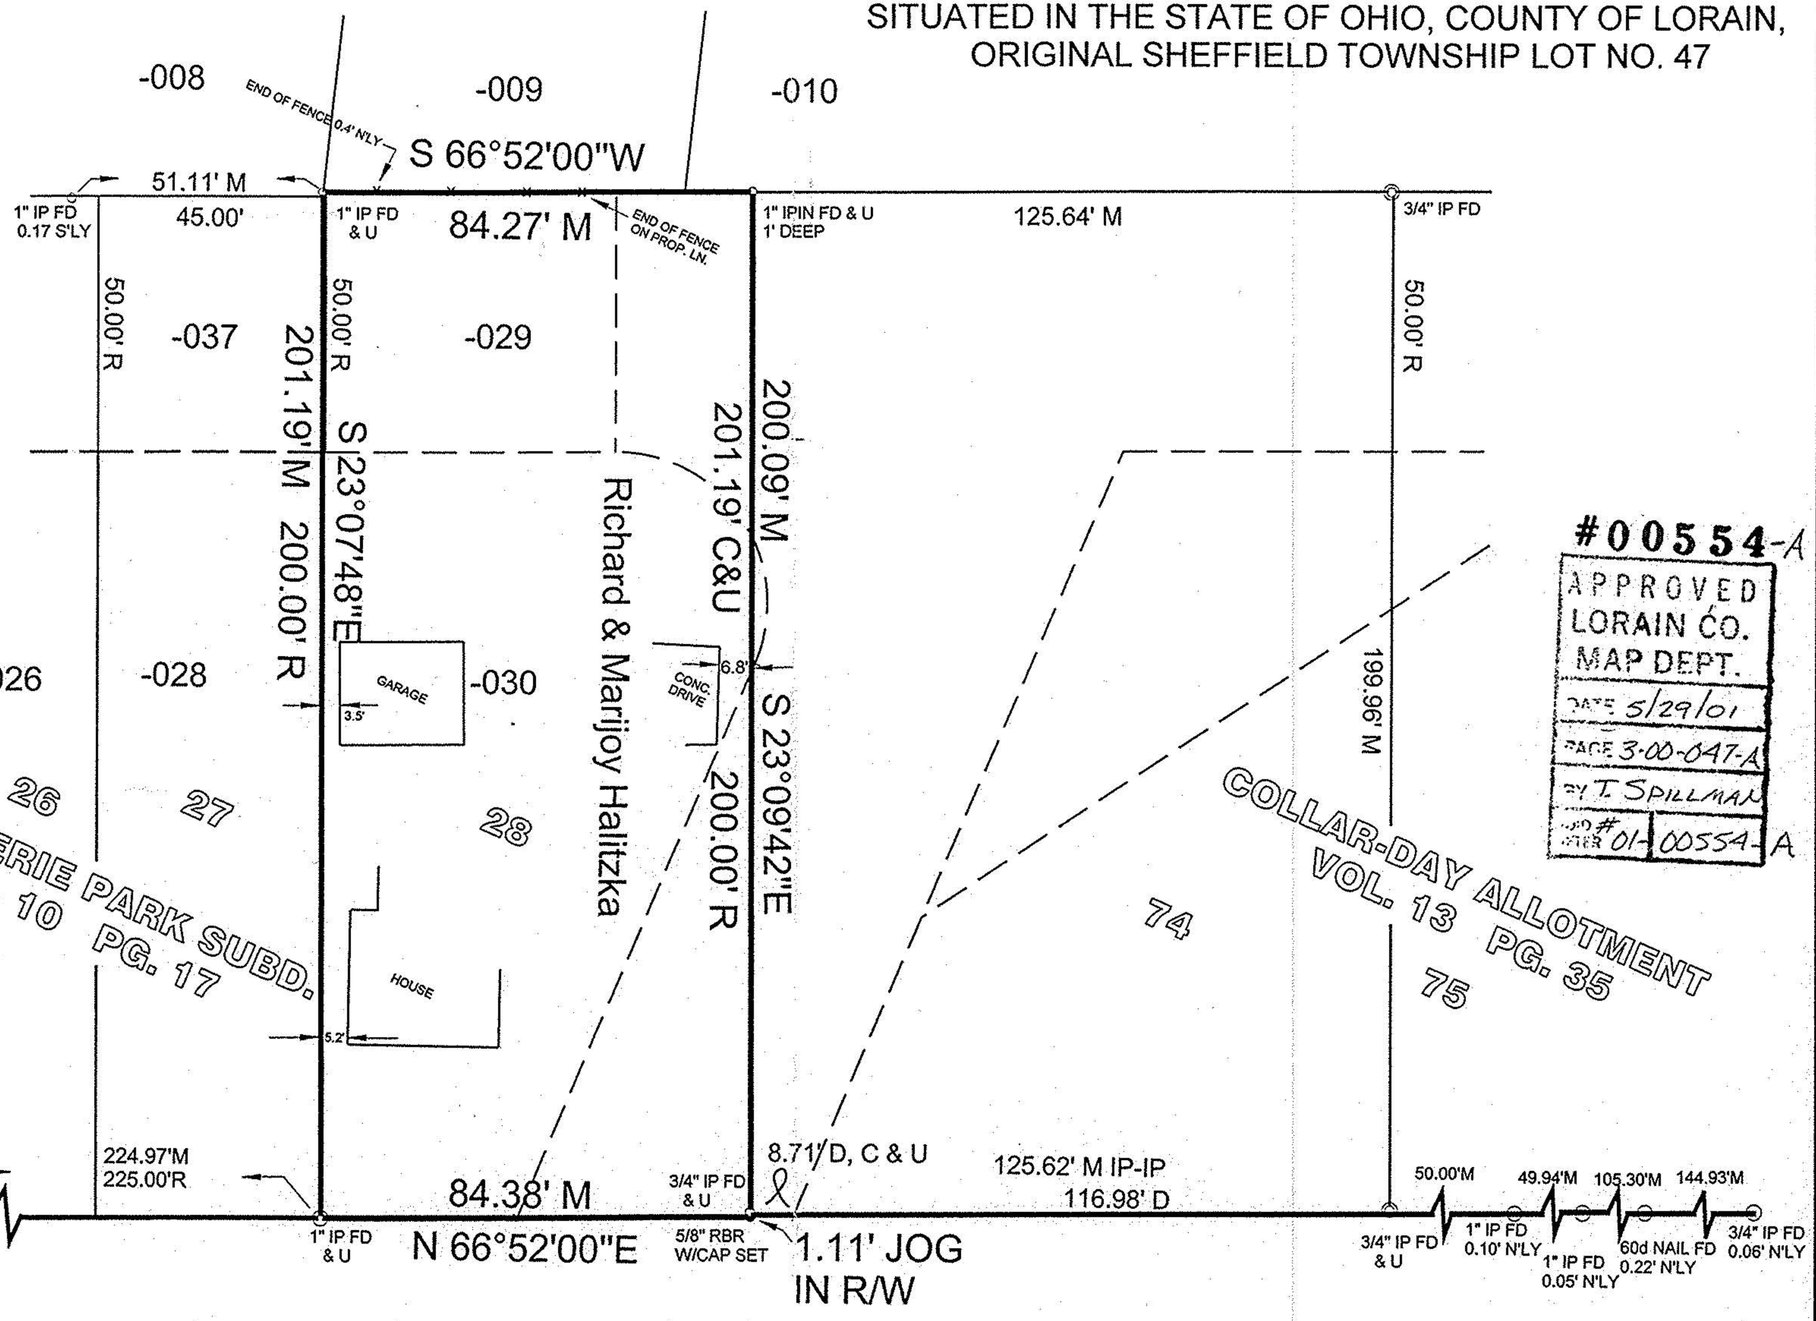

LEGEND

M	MEASURED
U	USED
F	FOUND
C	CALCULATED
R	RECORD
IP	IRON PIPE
D	DEED

STATE OF OHIO
MICHAEL A. STRAUB 7055
REGISTERED PROFESSIONAL SURVEYOR

5/16/01
Michael Straub, P.S. #7055

#00554-A
APPROVED
LORAIN CO.
MAP DEPT.
DATE 5/29/01
PAGE 3-00-047-A
BY T SPILLMAN
JOB # 01-00554-A

SURVEY MAP
OF
PPNs 03-00-047-103-029 AND -030
MADE FOR AND AT THE INSTANCE OF
RICHARD & MARIJOY HALITZKA

DR. BY: PK
CHK. BY: MS
APR. BY: MS
DATE: 5-16-01

R.E. WARNER & ASSOCIATES, INC.
CONSULTING ENGINEERS
Three King James Park Suite 300
24600 Center Ridge Road
Westlake, Ohio 44145
Tel. 440-835-9400
Fax 440-835-9474

Drawing File: C:\SURV\01-006\01-006.ZAK