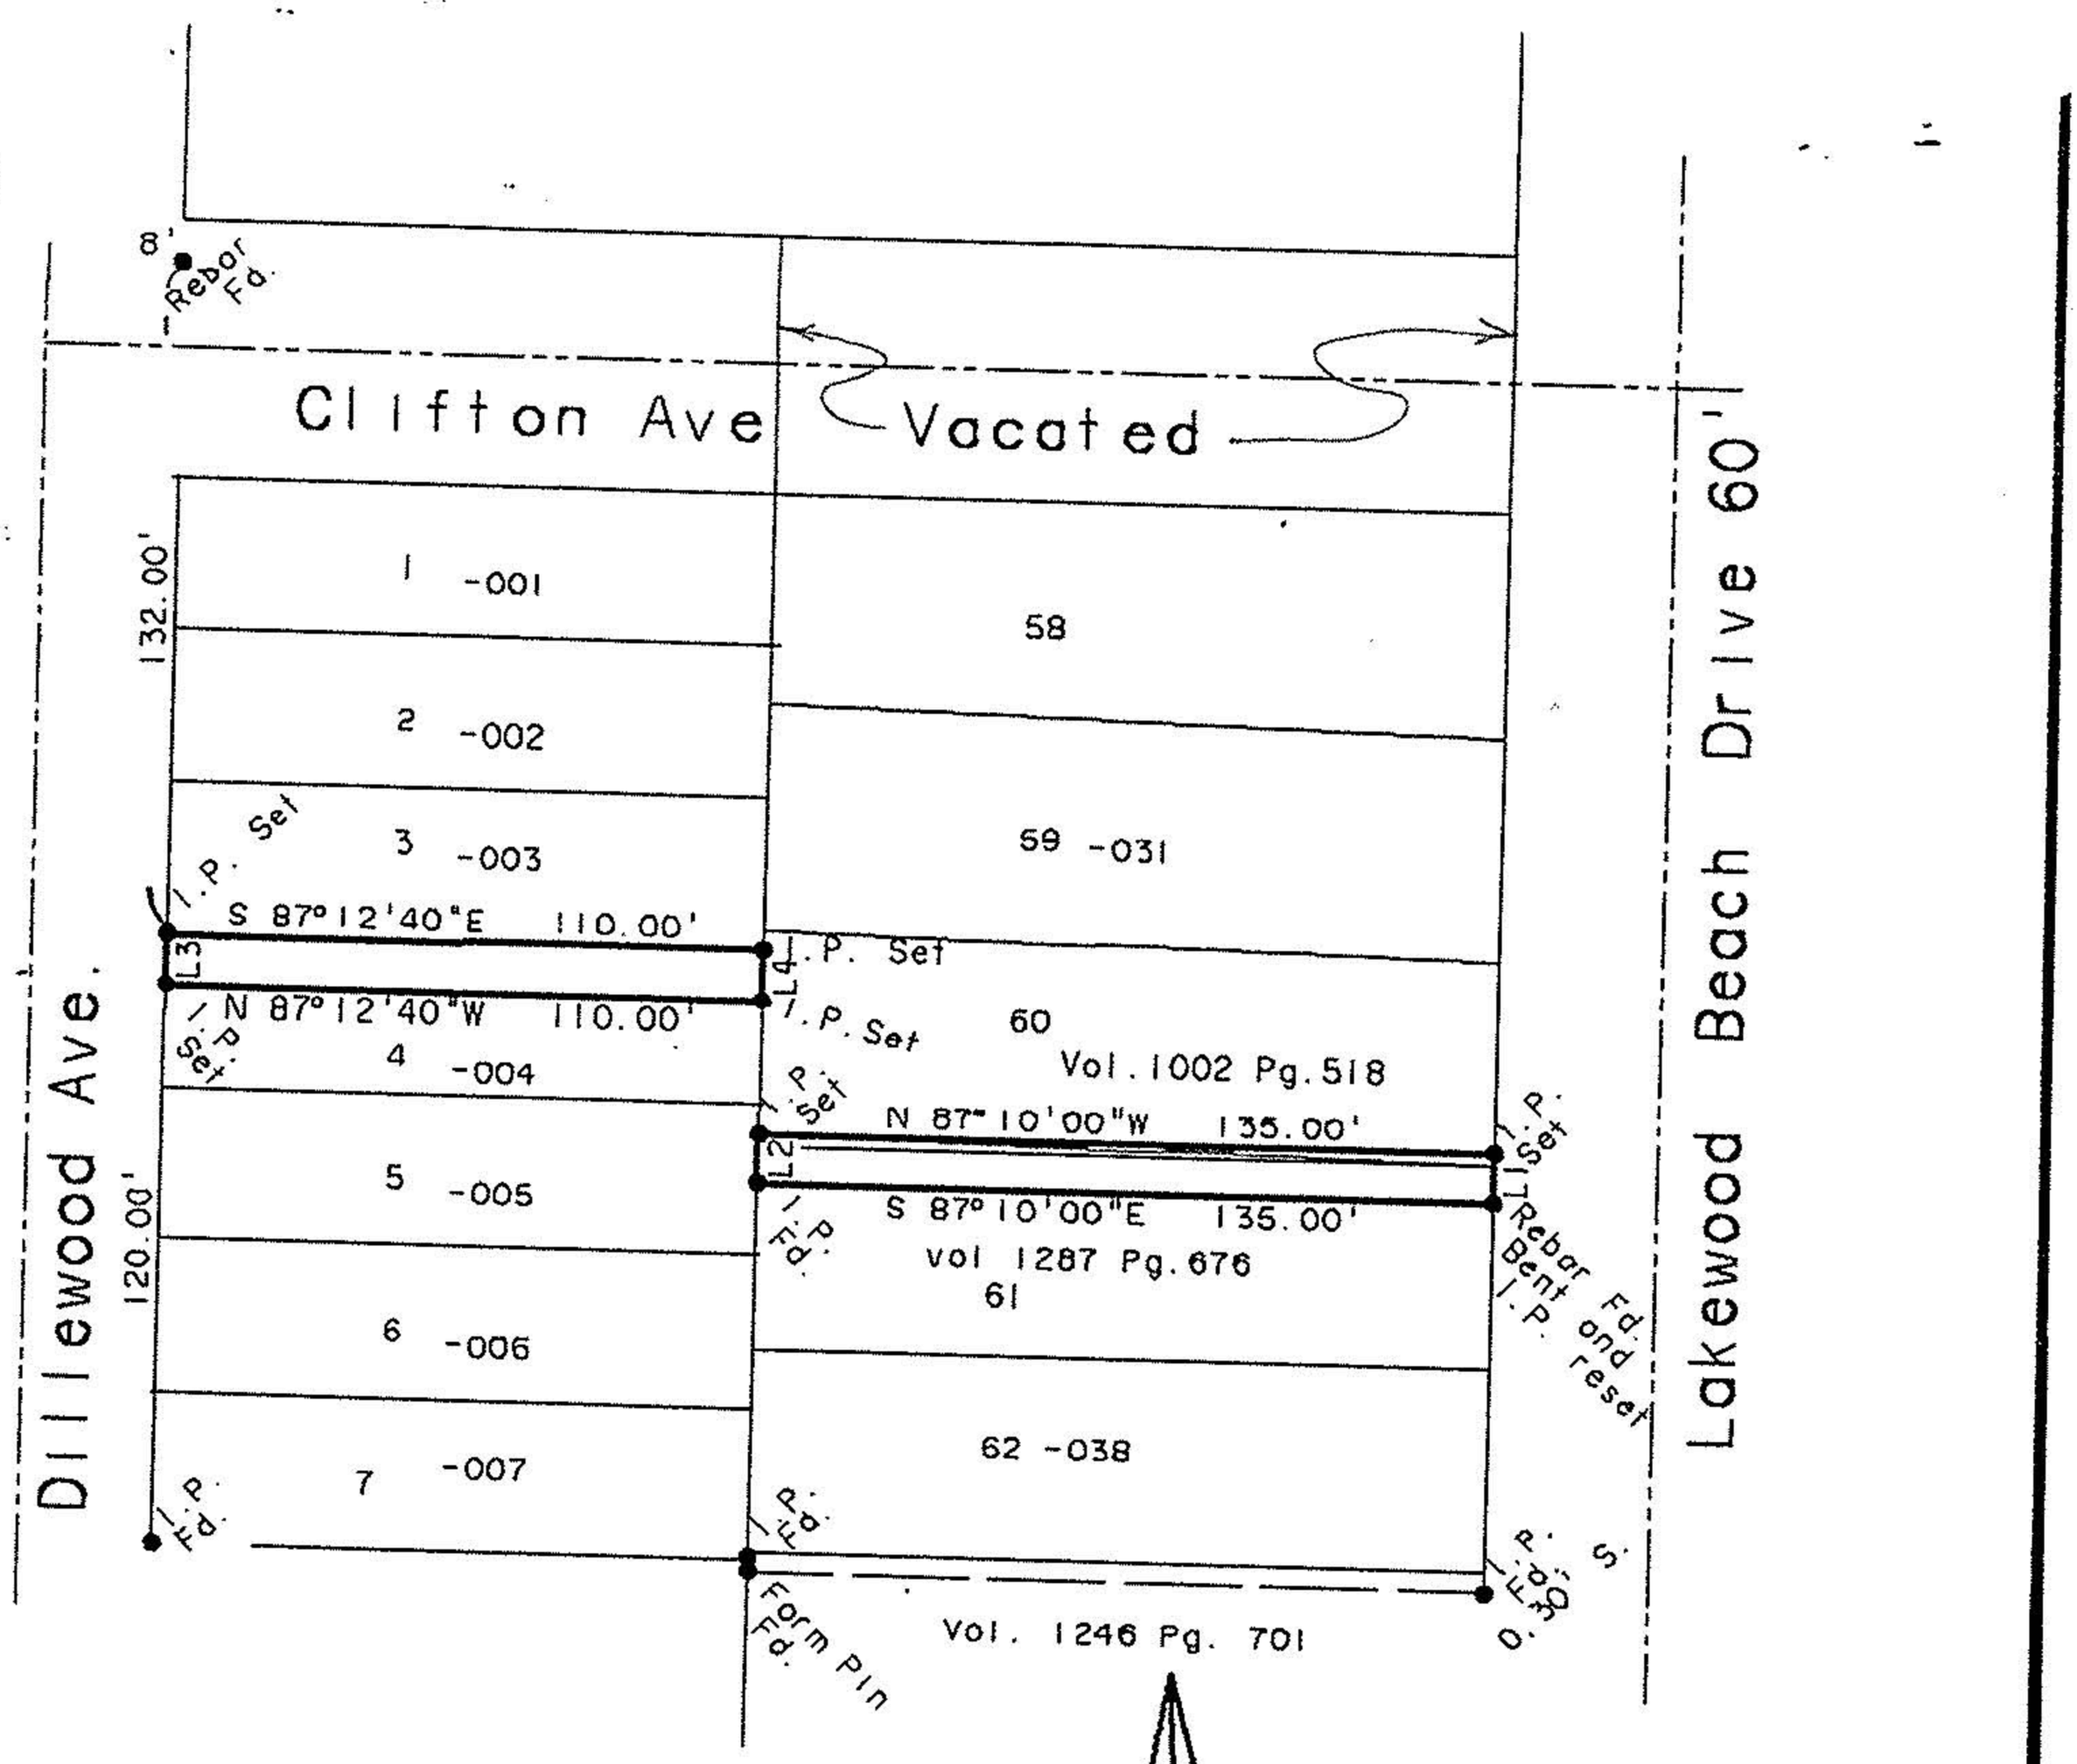

LINE	BEARING	DISTANCE
L 1	N 02° 50' 00"E	10.00'
L 2	S 02° 50' 00"W	10.00'
L 3	N 02° 50' 00"E	10.00'
L 4	S 02° 50' 00"W	10.00'

Bearings shown are assumed and are used to describe angles only.

Prepared for Mr. Ronald Crapo
of 972 Lakewood Beach Drive.
Sheffield lake. Ohio 44054.

Note Only copies signed in red Ink shall be considered Valid.

Patrick A. McGannon

Patrick A. McGannon P.S. 7154

0 25' 50' 75' 100'
Scale 1" = 50'
Feb. 22, 1992

19831

APPROVED
LORAIN CO.
MAP DEPT.
DATE 3-25-92
PAGE 03-00-043.00 44
CAROLYN
BY FRANCIS
VOID
AFTER # 19831

Boundary Survey

Patrick A. McGannon, Registered
Professional Surveyor
1731 Gettysburg Drive, Lorain, Ohio., Ph (216) 282 2712

STATE OF OHIO
PATRICK A. McGANNON
7154
REGISTERED
PROFESSIONAL SURVEYOR