3-00-042-A #5711 03-00-042-103

5711

Map of Survey of Proposed Vacated Tennyson Ave
Right of Way of former L.S.E Railroad
Sheffield Lake Ohio
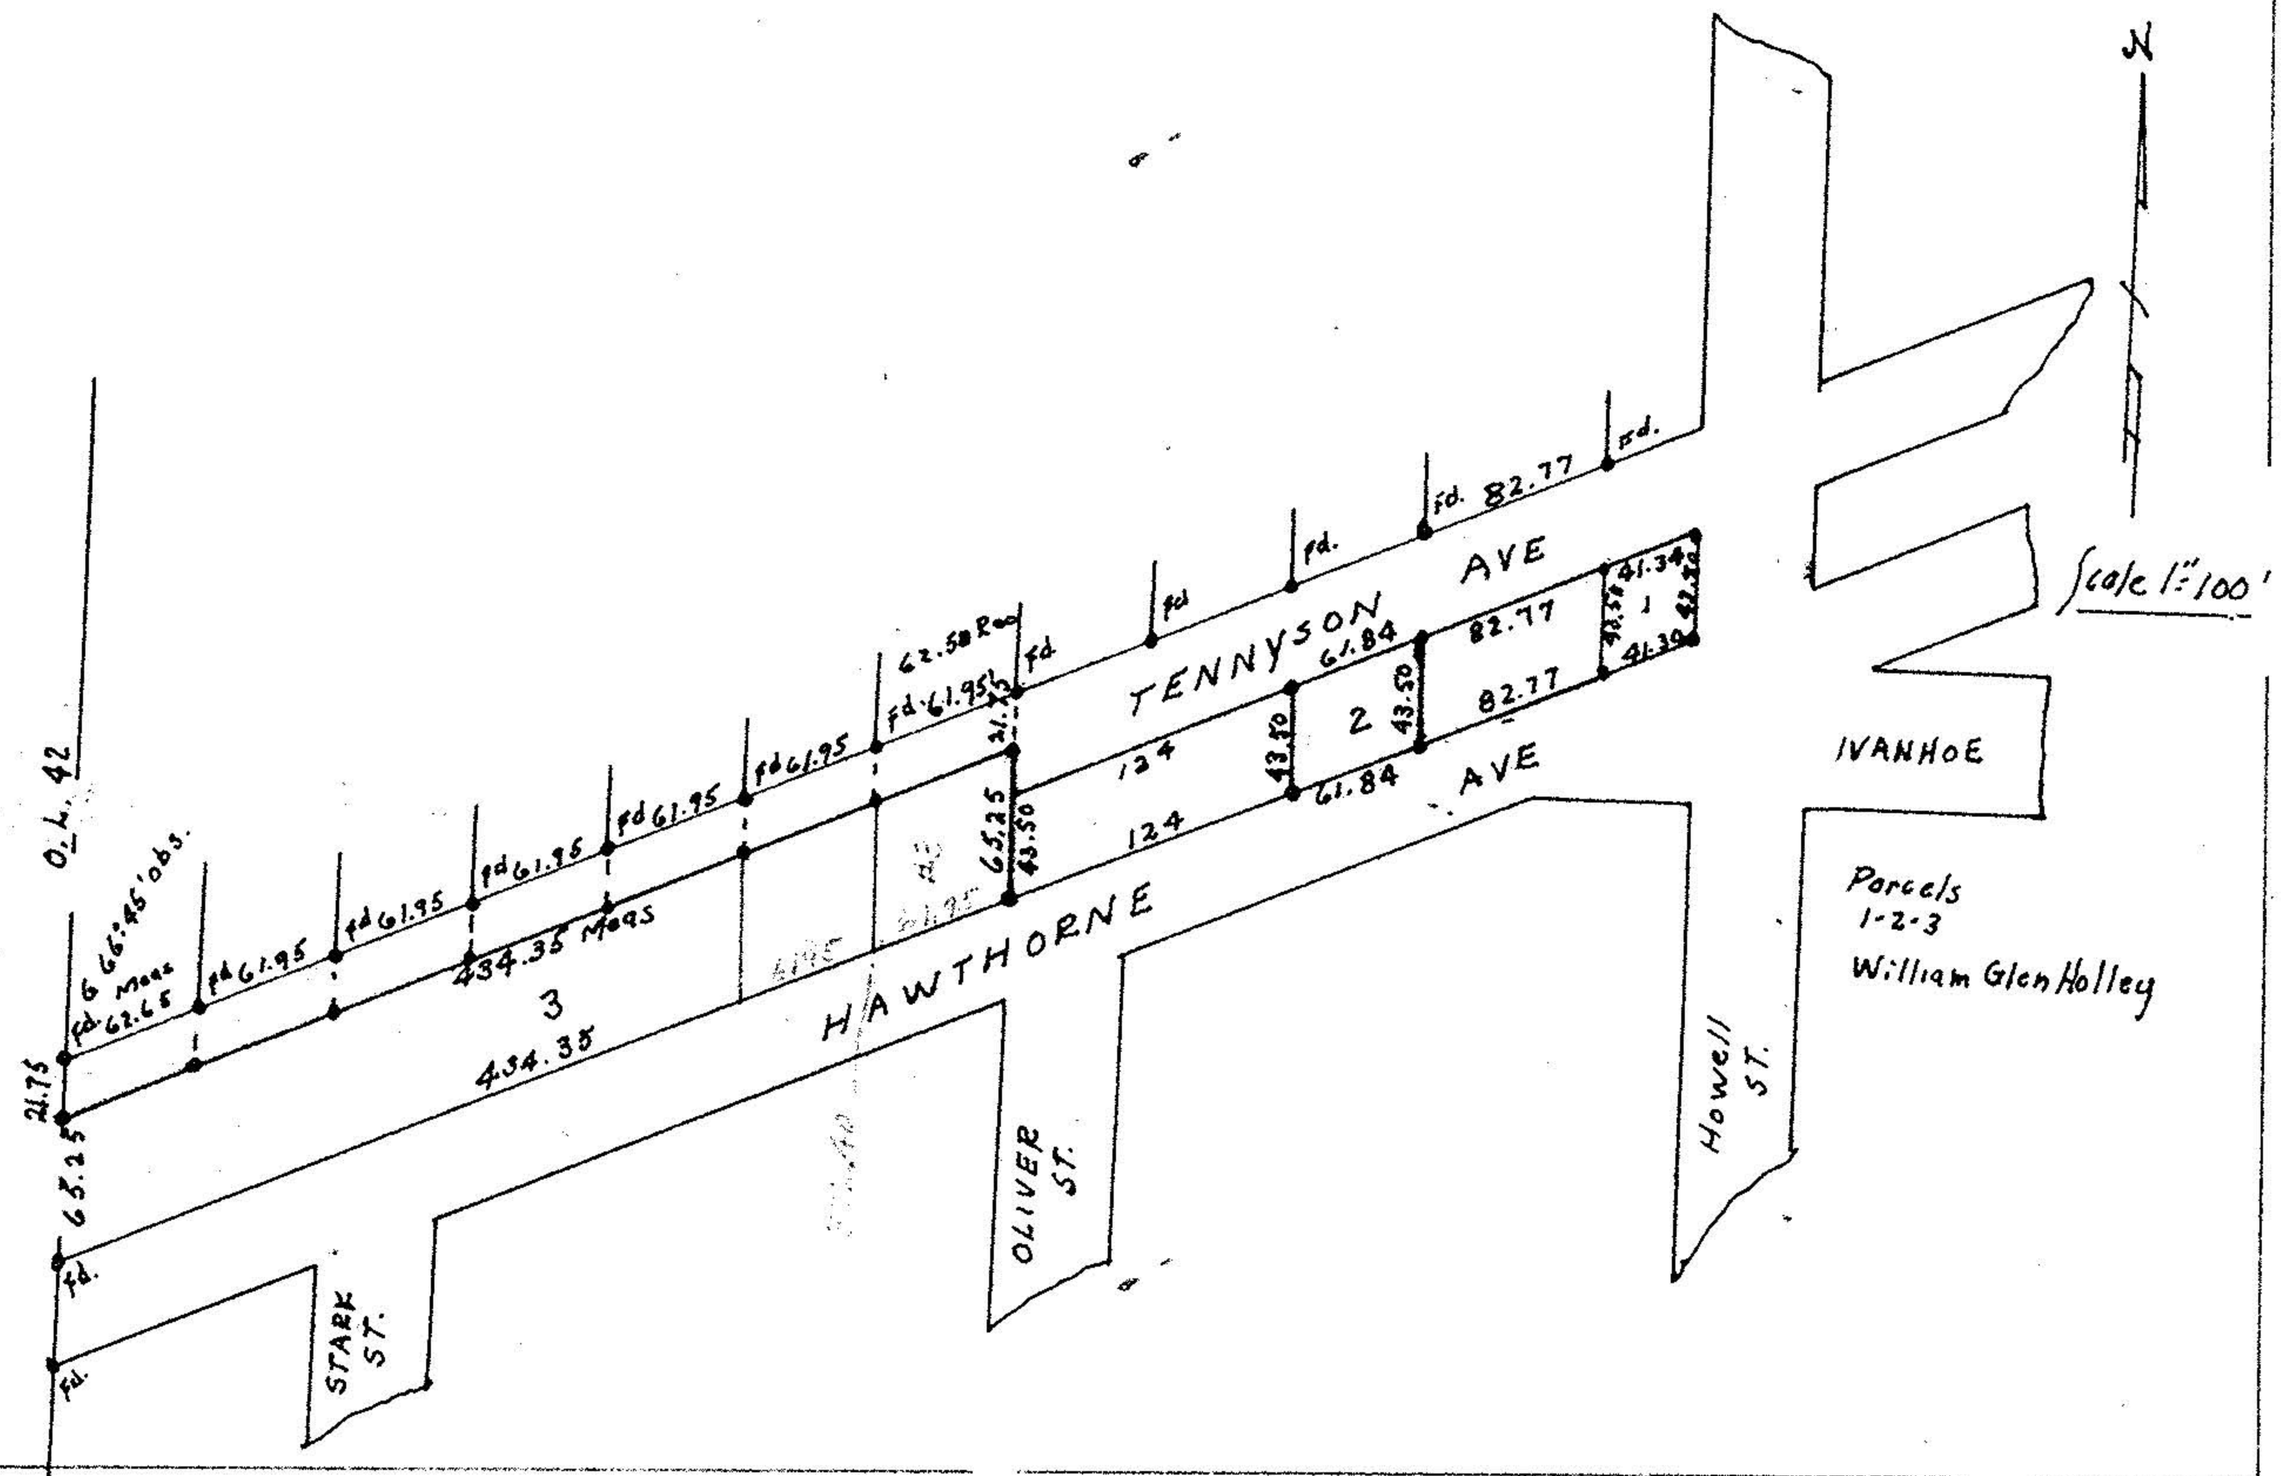
Sept. 25, 1965 By Arnold F. Koepp Registered Surveyor No. 4306