

KLEINOEDER-SCHMIDT and ASSOCIATES

ENGINEERS SURVEYORS CONSULTANTS IN LAND PLANNING

ELYRIA · HORWALK · MEDINA

OHIO


SURVEY

Sublot(s) _____

Subd'n _____

Township SHEFFIELD Tract _____
 Orig. Lot(s) 33 Sec. _____
 County of LOBAIN State of Ohio
 Corporation CITY OF SHEFFIELD LAKE

3-00-033-A
3-00-033-104-3
3-00-033-33

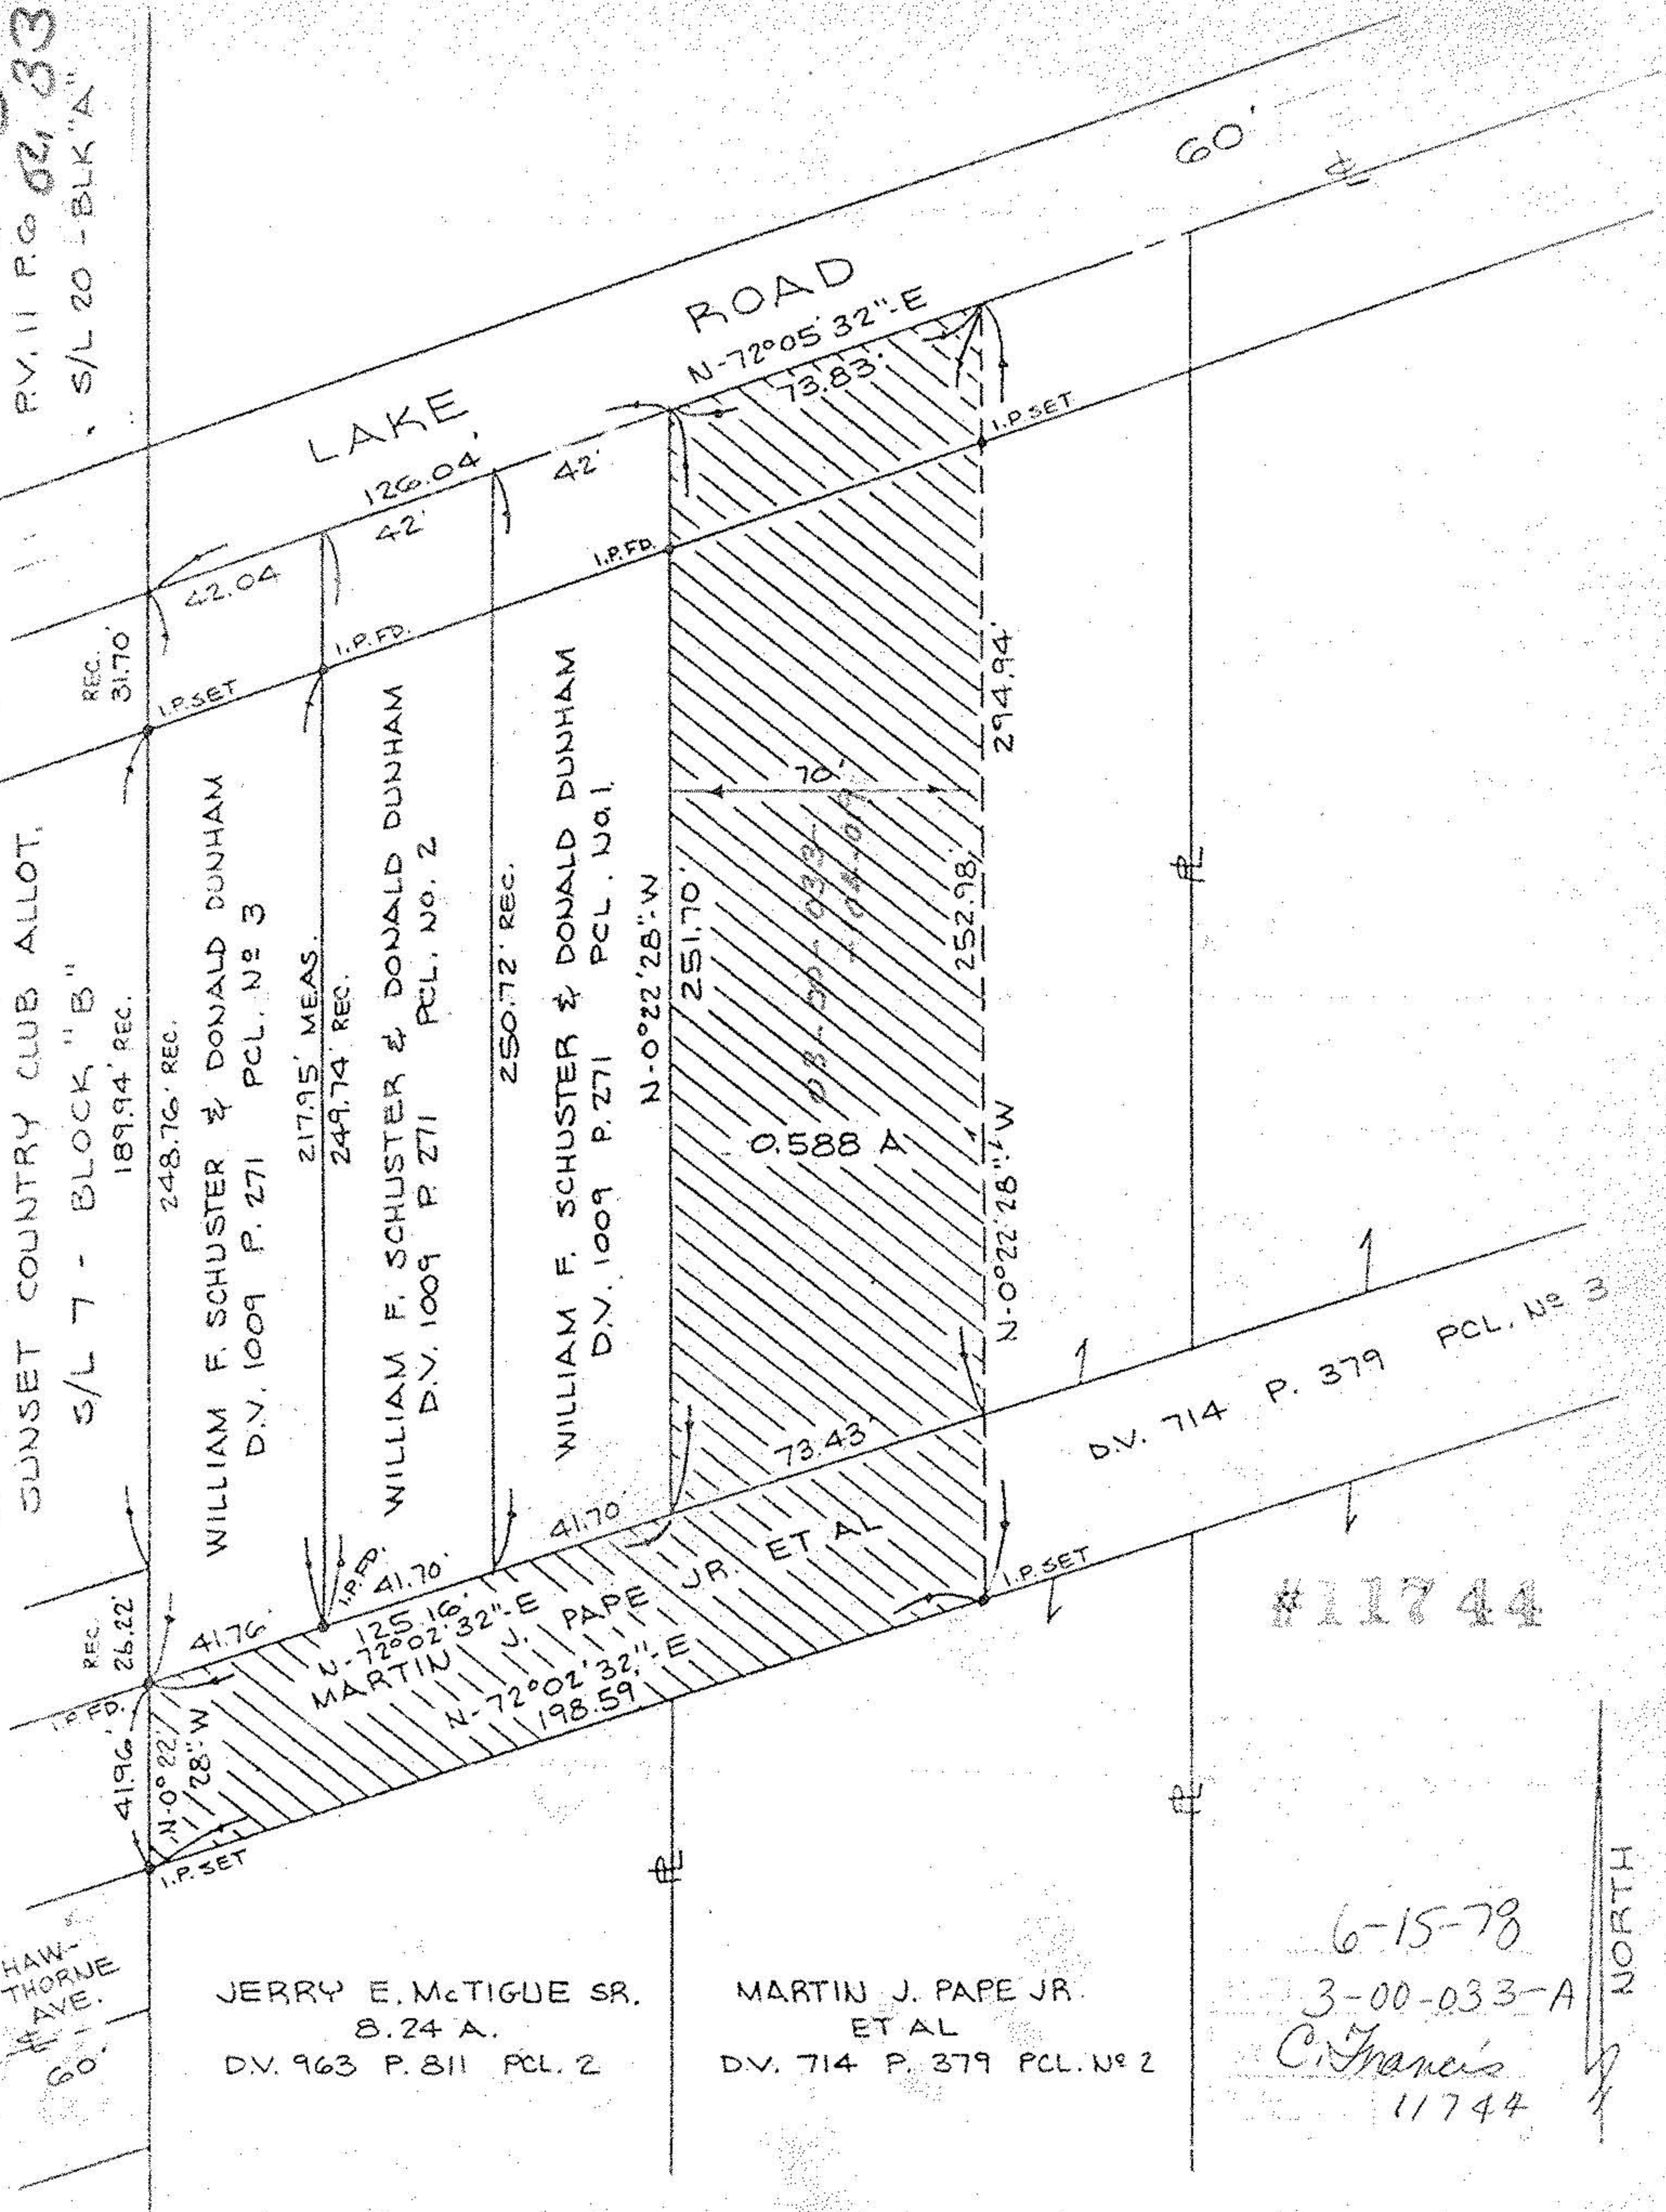

Prepared for: **WILLIAM F. SCHUSTER & DONALD DUNHAM**
5348 E. LAKE ROAD
SHEFFIELD LAKE, OHIO

Scale: 1" = 50' Date: 9-23-77 Dr. by: *OE* Job No: 77-242

3-00-033-A