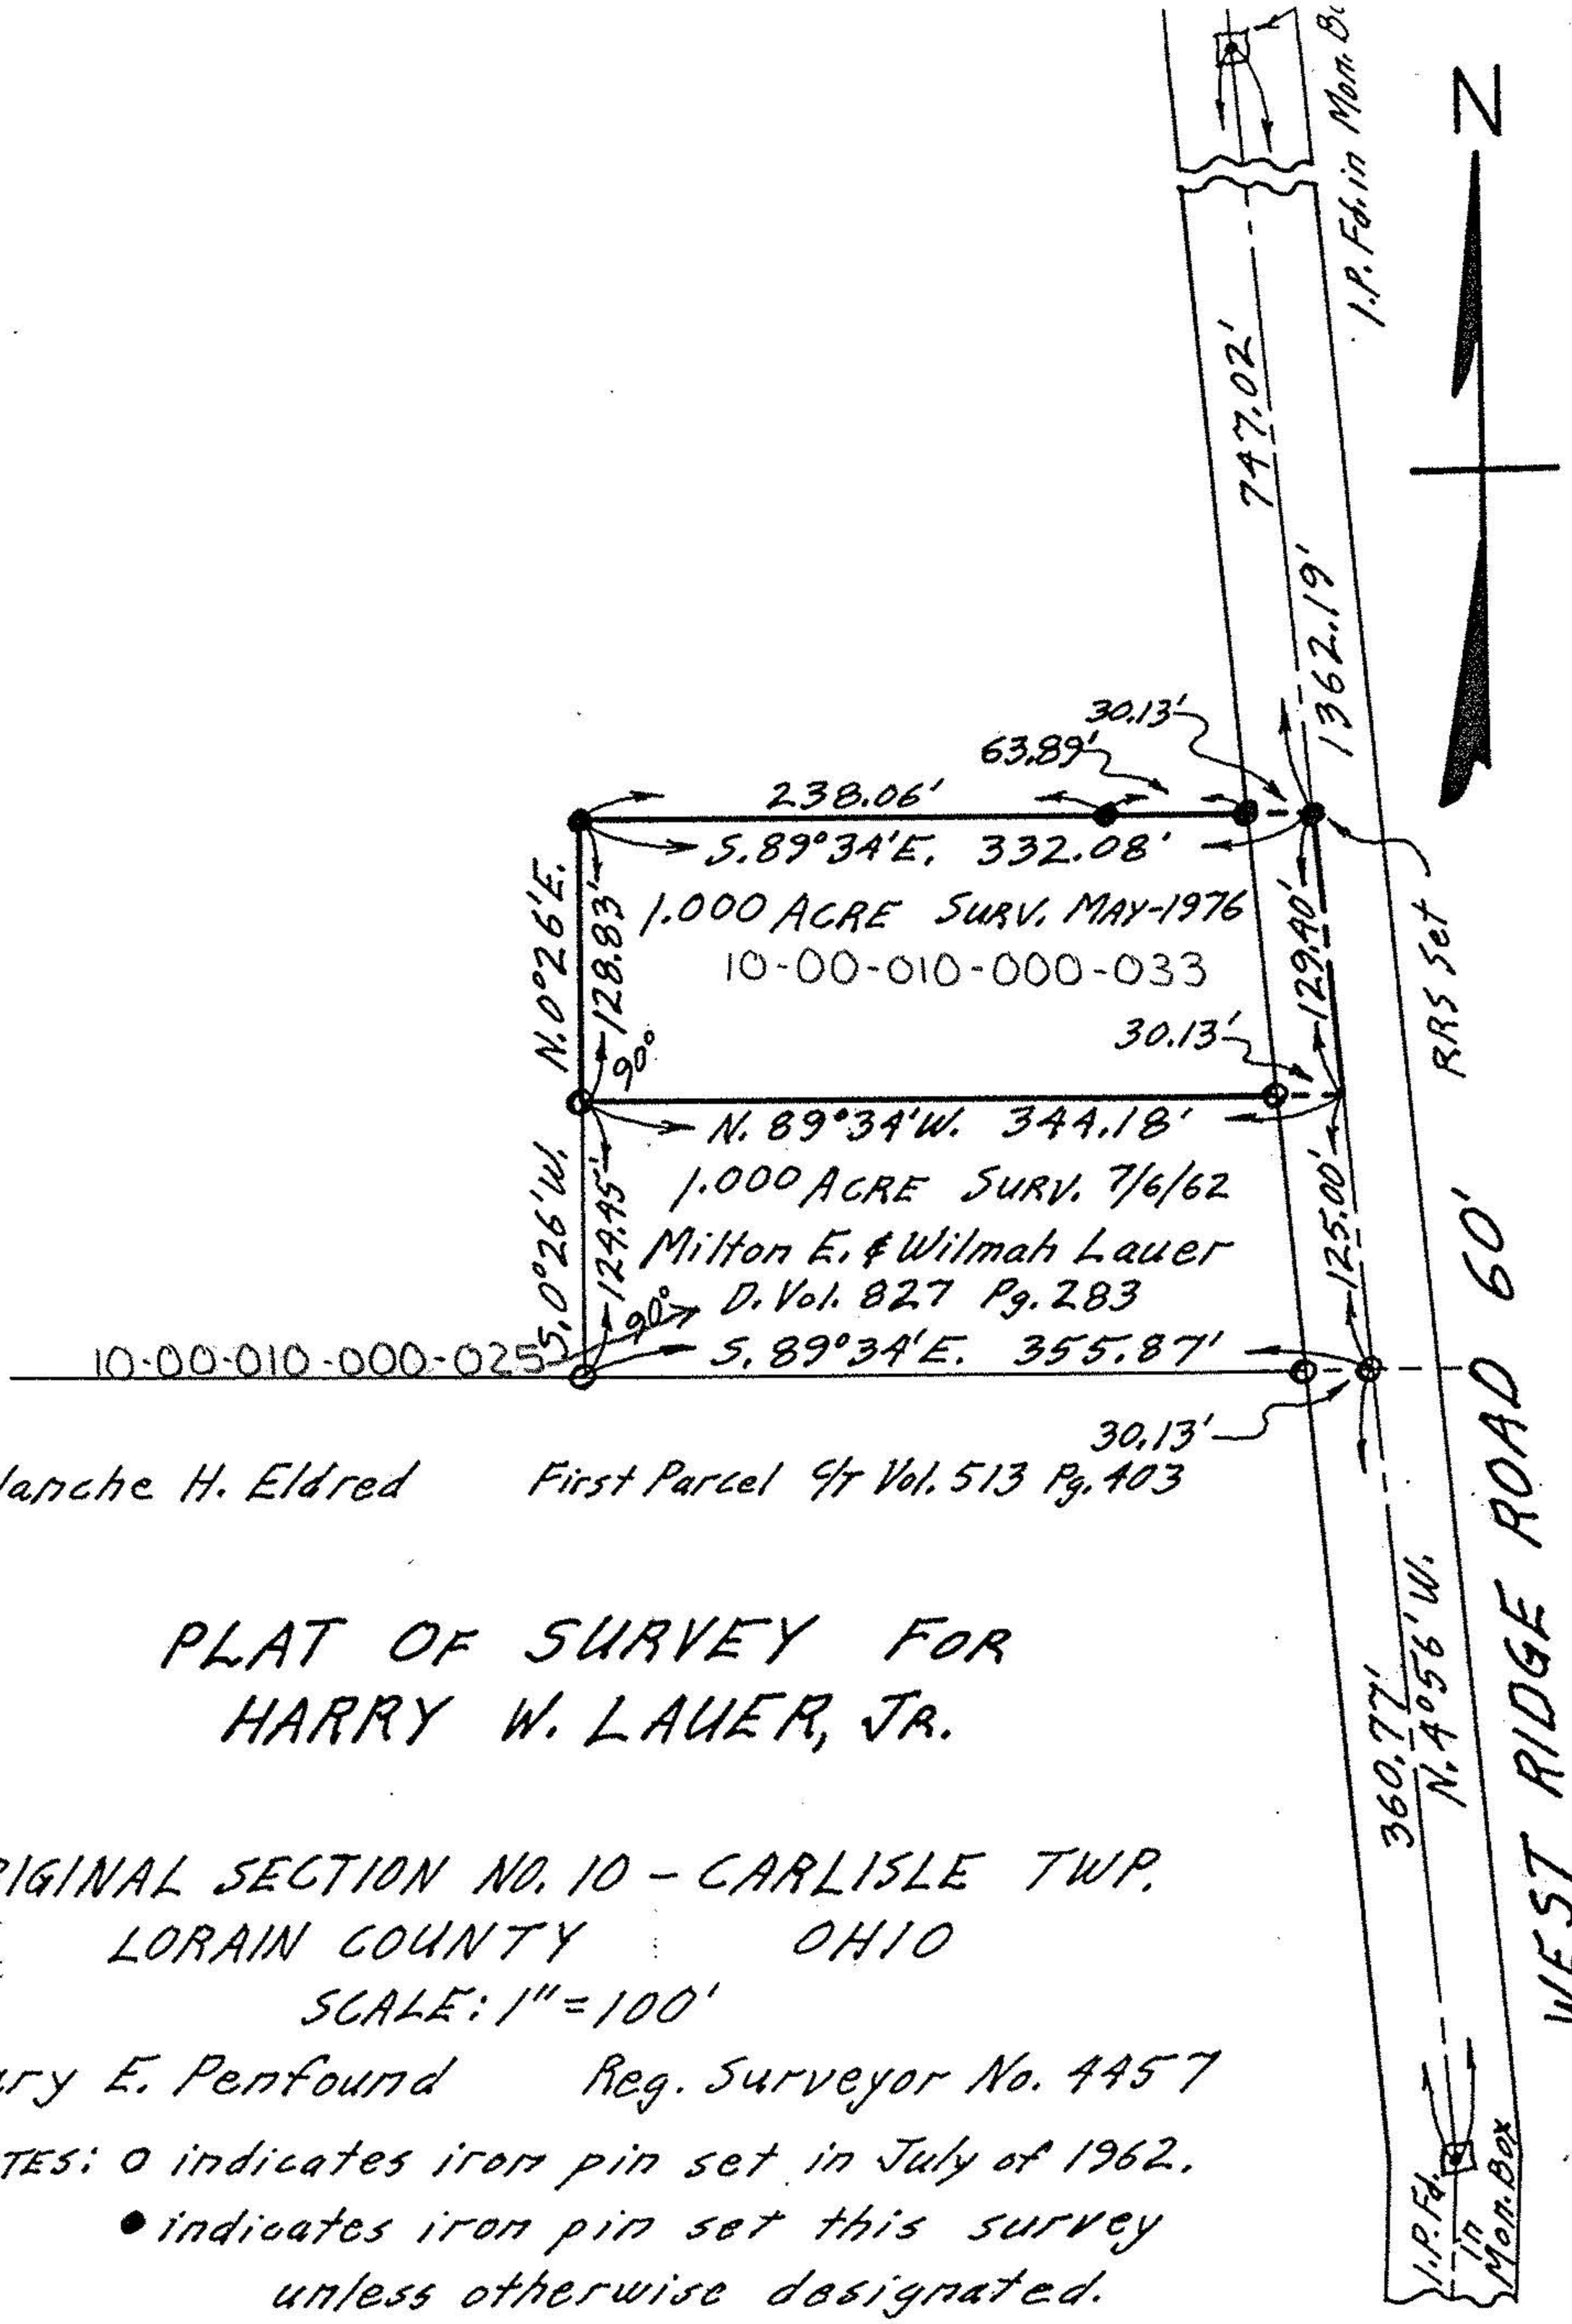

PLAT OF SURVEY FOR HARRY W. LAUER, JR.

ORIGINAL SECTION NO. 10 - CARLISLE TWP.
LORAIN COUNTY : OHIO
SCALE: 1" = 100'

Gary E. Penfound Reg. Surveyor No. 4457

NOTES: O indicates iron pin set in July of 1962.
● indicates iron pin set this survey
unless otherwise designated.