LAUNDON • SIMON • CAHL & ASSOC. INC.
CONSULTING ENGINEERS & SURVEYORS
ELYRIA, OHIO 44035

SURVEY FOR
WARREN IVES

Orig. Lot	City of	Date 9-7-84 Scale 1" = 60'
Orig. Sec 10	Village of	Dwn. by R.G.S. Chkd. by J.C.
Tract	County of LORAIN	Job No. 84-1323 F.B. 180-69
Township of CARLISLE	State of OHIO	Printed OCT. 1 1984

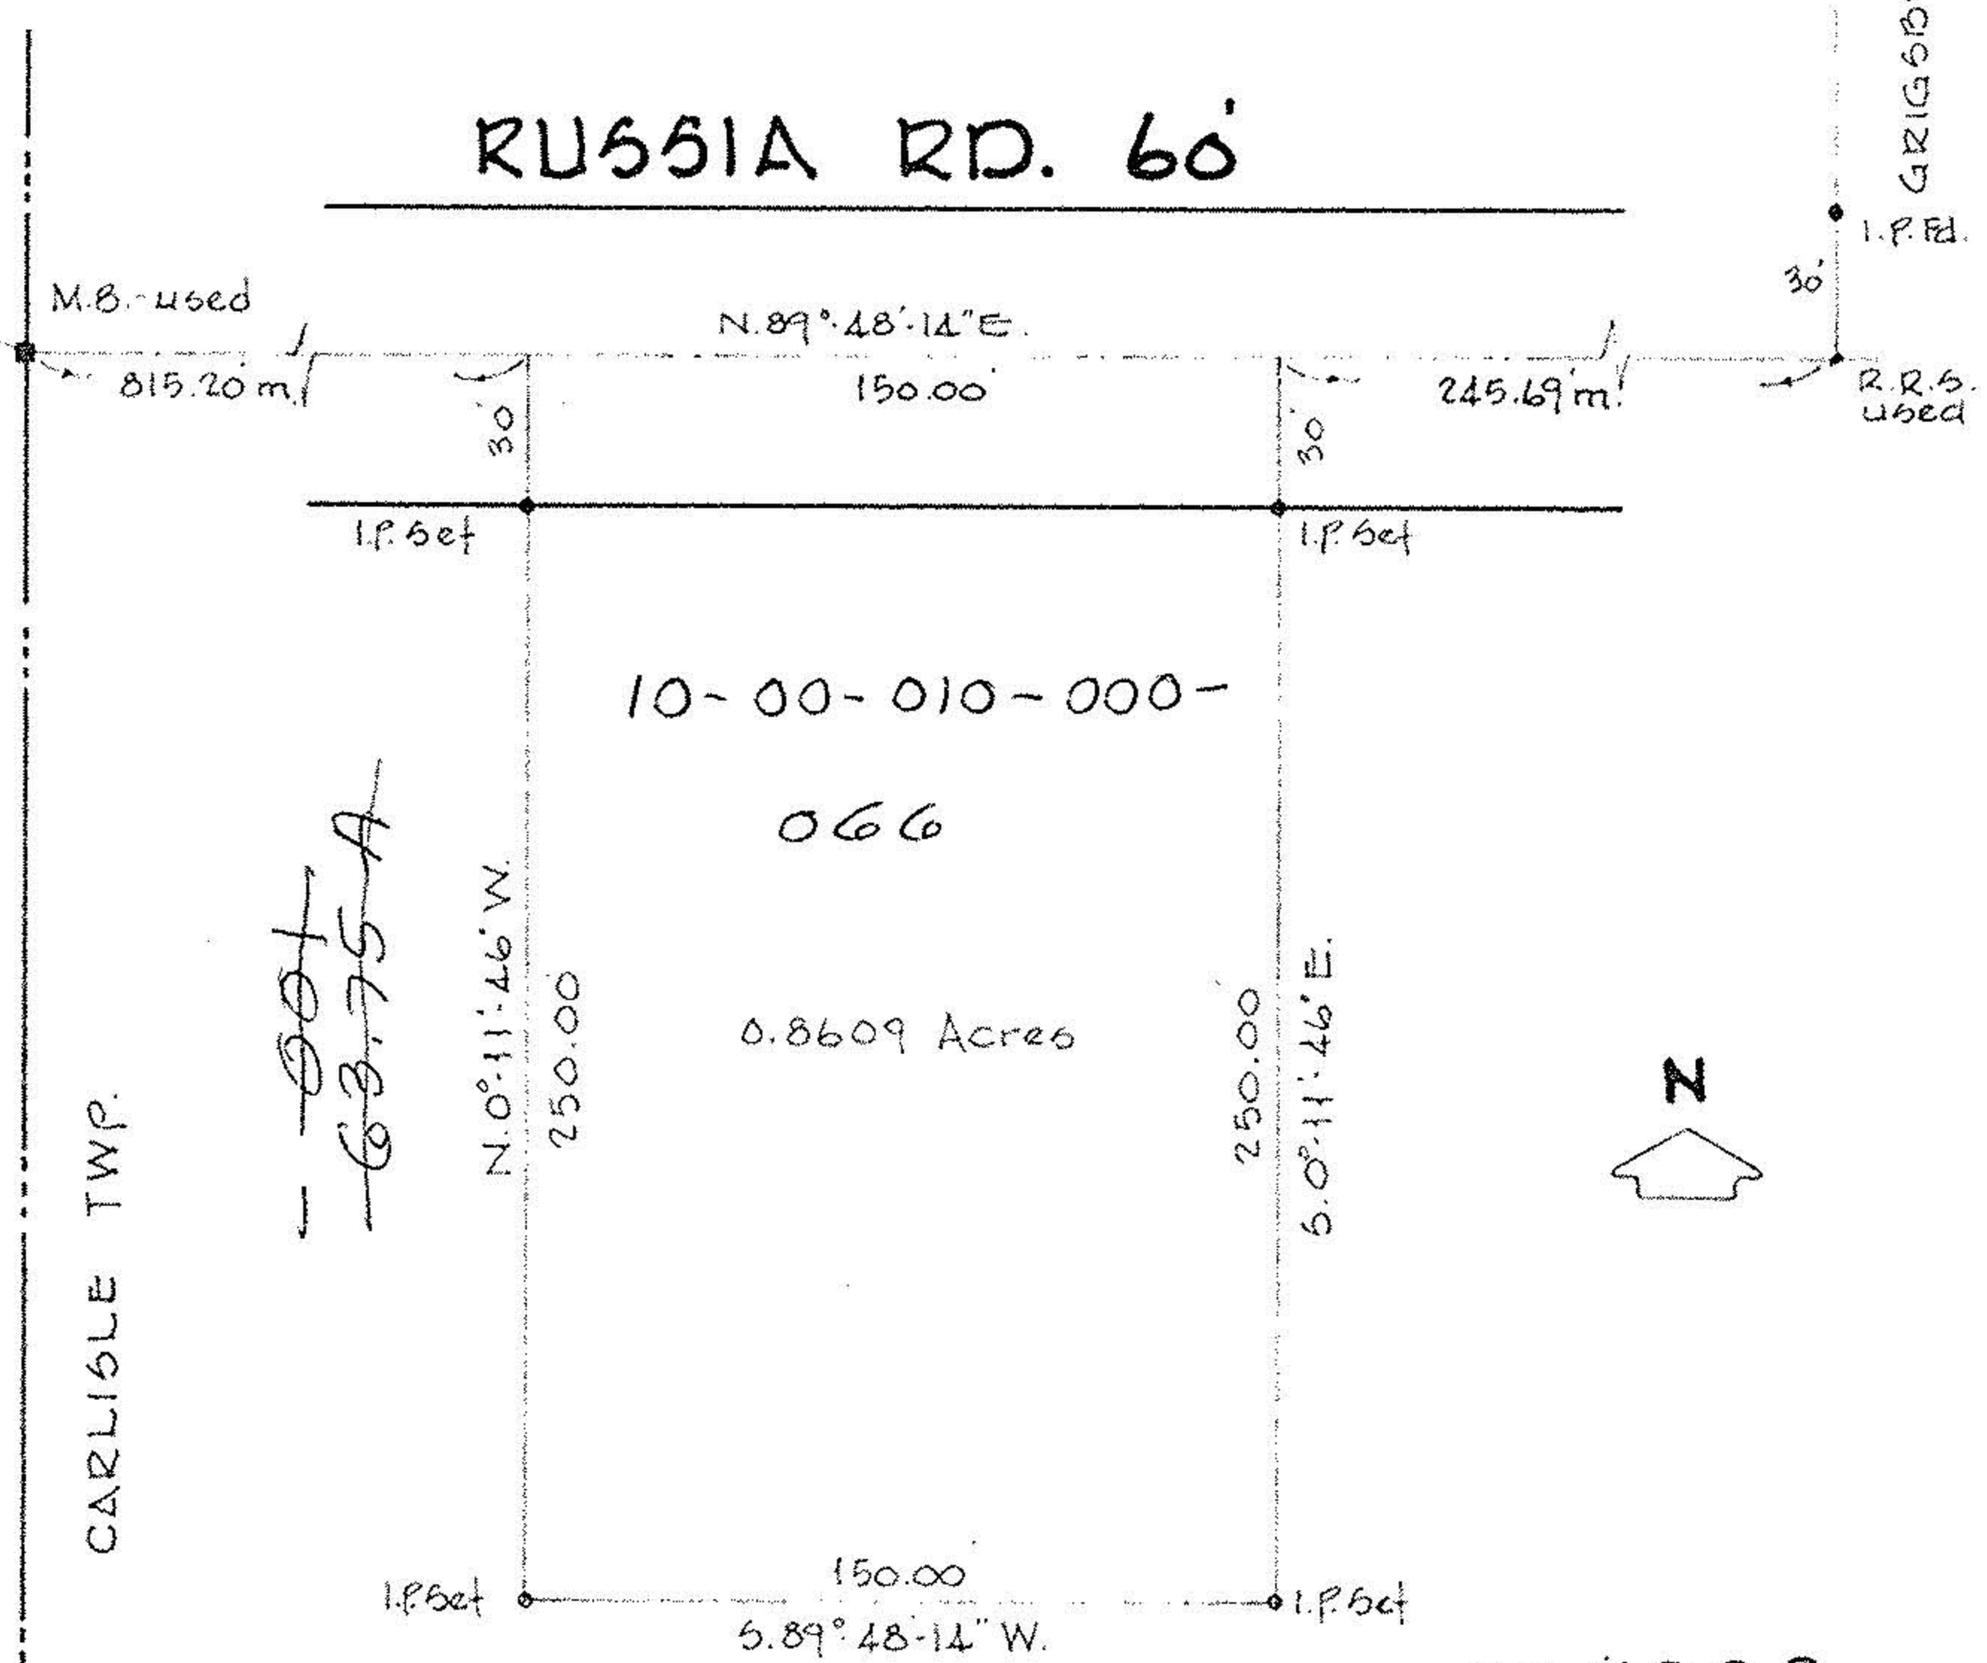

#15836

APPROVED
LORAIN CO.
MAP DEPT.

DATE 10.5.84

PAGE 10-A

BY T. McNair

VOID

10-00-010-000-

#15836

10-A

S.C. 10