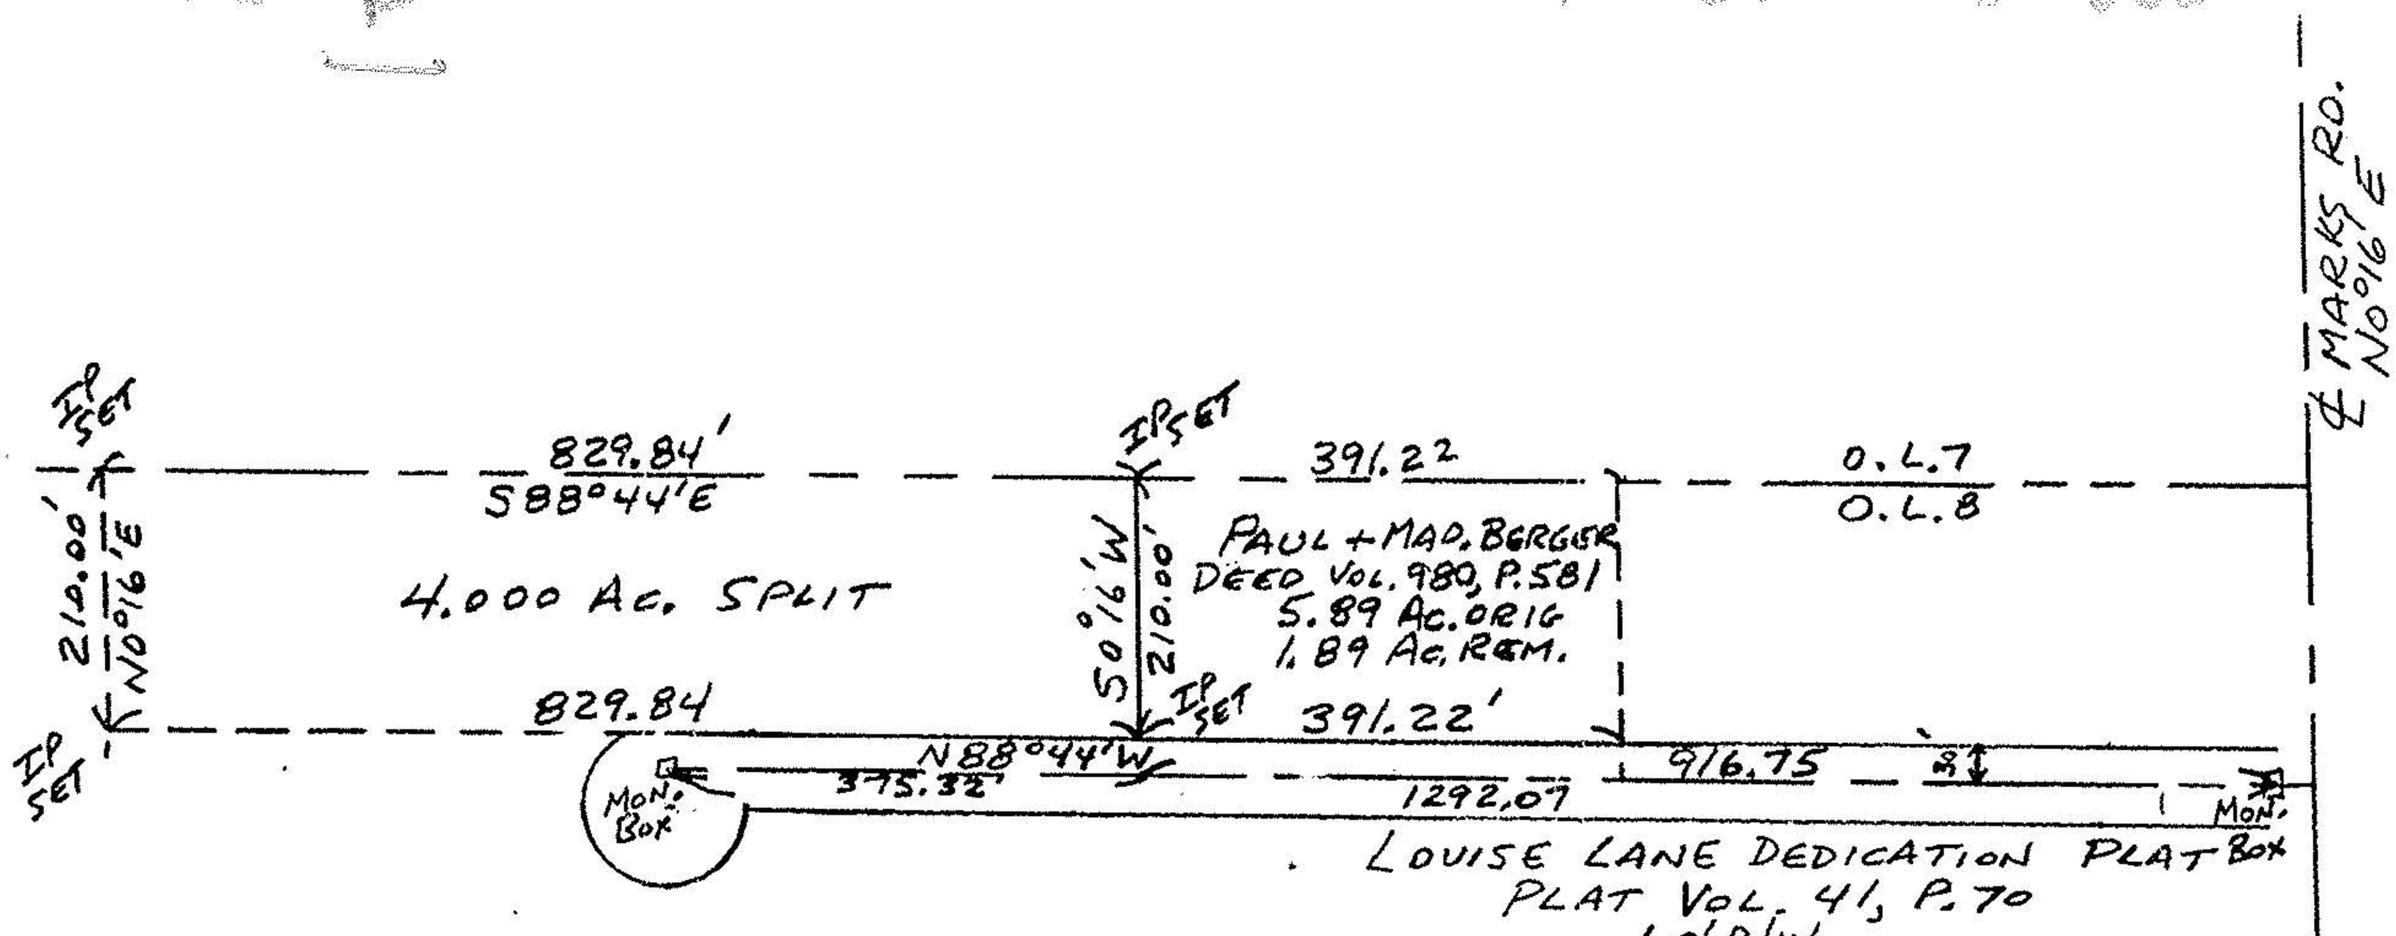

STATE OF OHIO
JOHN R. HAMILTON 6861
REGISTERED PROFESSIONAL SURVEYOR

MAP OF SURVEY FOR DOUG KEYSE
O.L. 8 - COLUMBIA TWP. - LORAIN CO.
MAY 1991 SCALE 1" = 200'
JOHN R. HAMILTON - REG. SURVEYOR #6861

NORTH
SCALE 1" = 200'

#19425

APPROVED
LORAIN CO.
MAP DEPT.

DATE 6-17-91

PAGE 12-00-008-B

BY CAROLYN FRANCIS