#8342

7-00-021

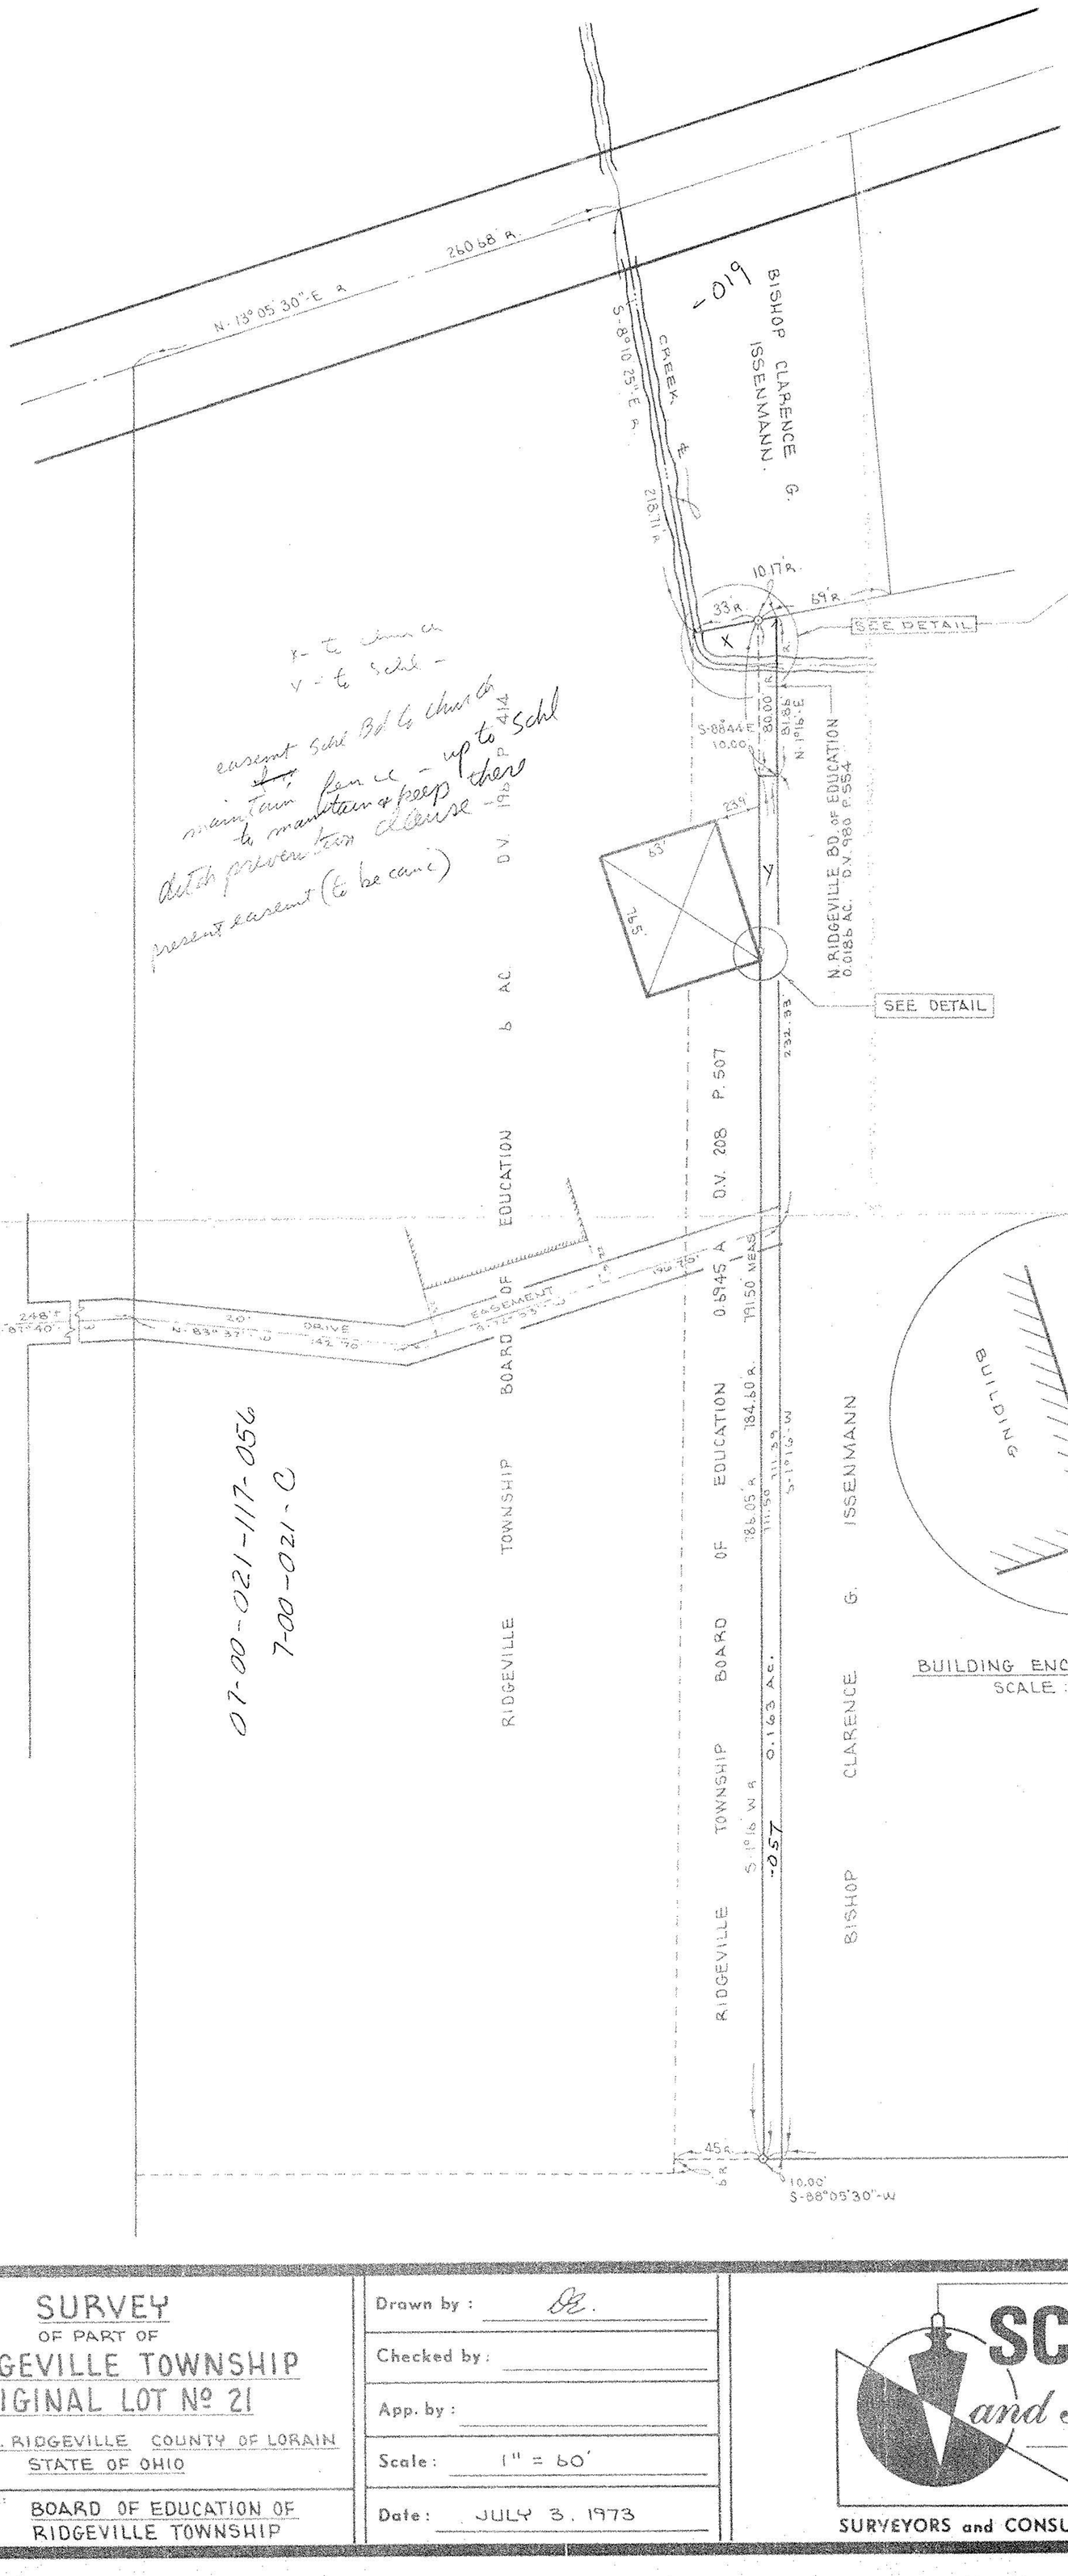

SURVEY
OF PART OF
RIDGEVILLE TOWNSHIP
ORIGINAL LOT Nº 21
CITY OF N. RIDGEVILLE COUNTY OF LORAIN
STATE OF OHIO

PREPARED FOR: BOARD OF EDUCATION OF RIDGEVILLE TOWNSHIP

Drawn by : DE.
Checked by :
App. by :
Scale : 1" = 60'
Date : JULY 3, 1973

SCHMIDT and Associates
Elyria, Ohio
Norwalk, Ohio
SURVEYORS and CONSULTANTS in LAND PLANNING

REFERENCES

REV. 8-2-1973
REV. 3-6-74
REV. 3-25-74

SHEET NO. 1 of 1

JOB NO. 73-152

7-00-021