


WOOSTER - AVON LAKE ROAD

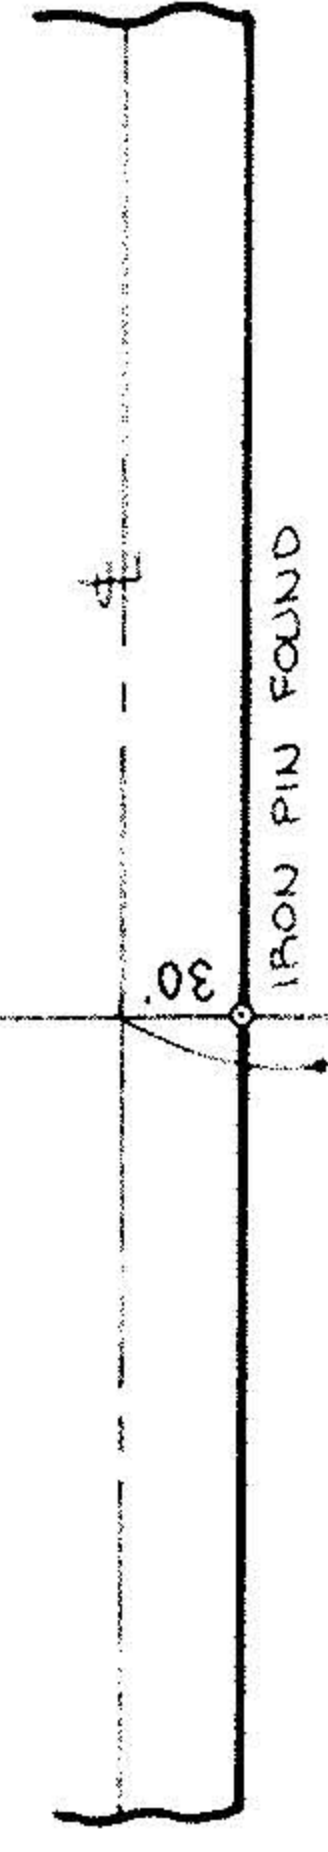

827.28

N-89°29'20"E

5-89°29'20"W

0L 22
0L 21

230.75

N-01°12'40"W

S-0°46'34"E

971.85'

974.03'

238.13
N-88°57'00"E

BISHOP CLARENCE G. ISSENMANN

NORTH RIDGE INV. CORP.

RIDGEVILLE BOARD OF EDUCATION

CITY OF
RIDGEVILLE

CITY OF
NORTH
RIDGEVILLE

01-22-2021-117-007
7-22-2021-C
5.236 ACRES




CITY OF
NORTH
RIDGEVILLE

REFERENCES	JOB NO. 14-230
R-025 1-244	SHEET NO. of

KLEINOEDER-SCHMIDT

and ASSOCIATES

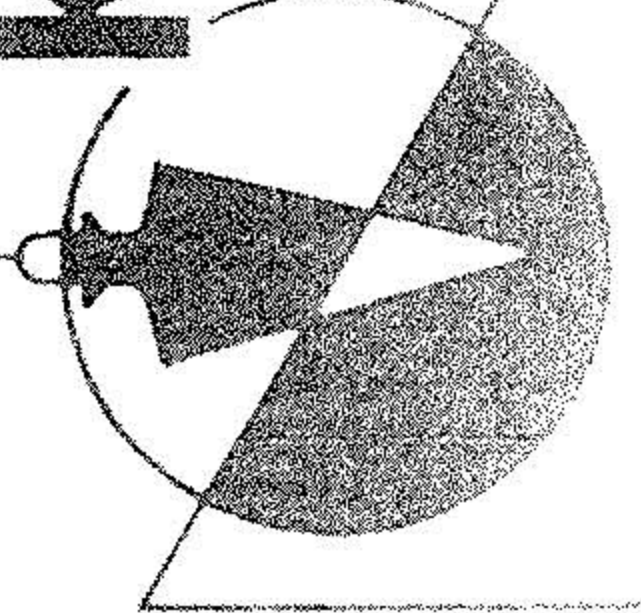

ENGINEERS SURVEYORS CONSULTANTS IN LAND PLANNING
 ELYRIA - NORWALK - MEDINA OHIO

Drawn by: DLH
Checked by:
App. by:
Scale: 1" = 100'
Date: NOV 15 2014

Rev.	12/9/15
------	---------

PROJECT
 SURVEY OF PART OF
 ORIGINAL RIDGEVILLE TOWNSHIP LOT NO 21
 COUNTY OF LORAIN
 STATE OF OHIO

Prepared for: MIKE ZUNICH