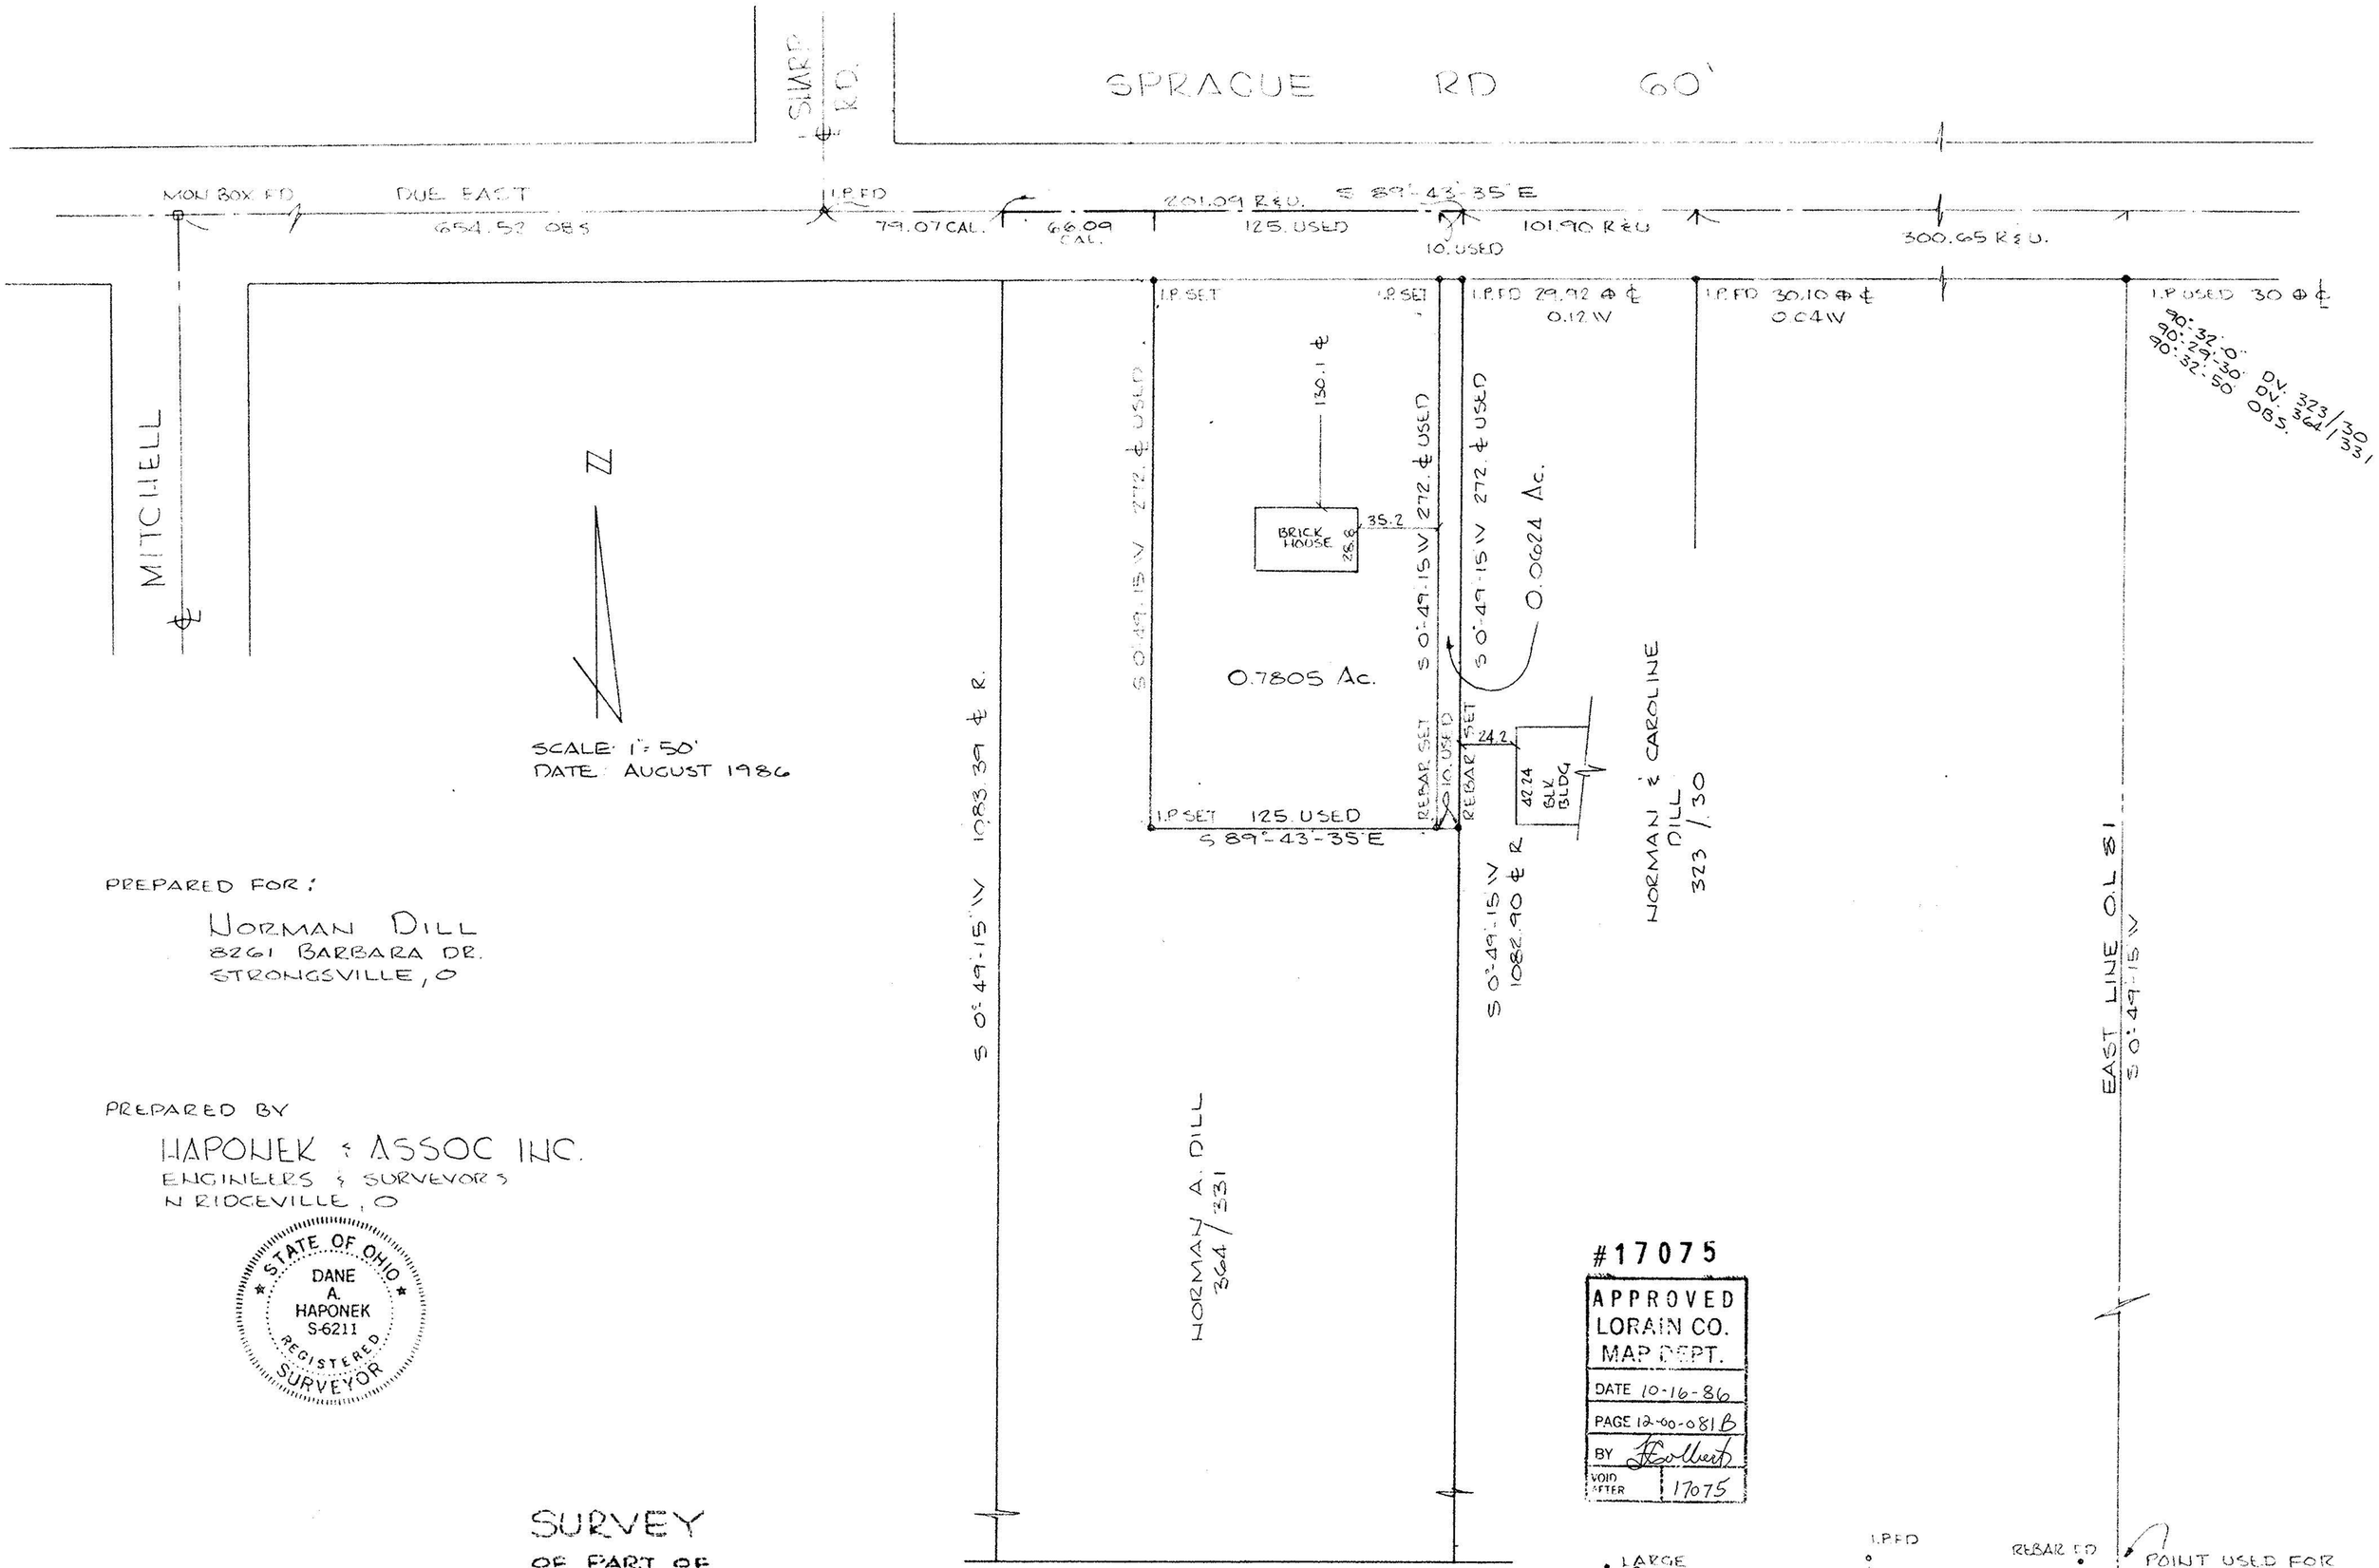

PREPARED FOR:

NORMAN DILL
8261 BARBARA DR.
STRONGSVILLE, O

PREPARED BY

HAPONEK & ASSOC INC.
ENGINEERS & SURVEYORS
N RIDGEVILLE, O

STATE OF OHIO
DANE A. HAPONEK
S-6211
REGISTERED SURVEYOR

#17075

APPROVED
LORAIN CO.
MAP DEPT.
DATE 10-16-86
PAGE 12-00-081B
BY [signature]
VOID AFTER 17075

SURVEY
OF PART OF
ORIGINAL COLUMBIA TWP.
LOT No 81
COUNTY OF LORAIN STATE OF OHIO

73-175