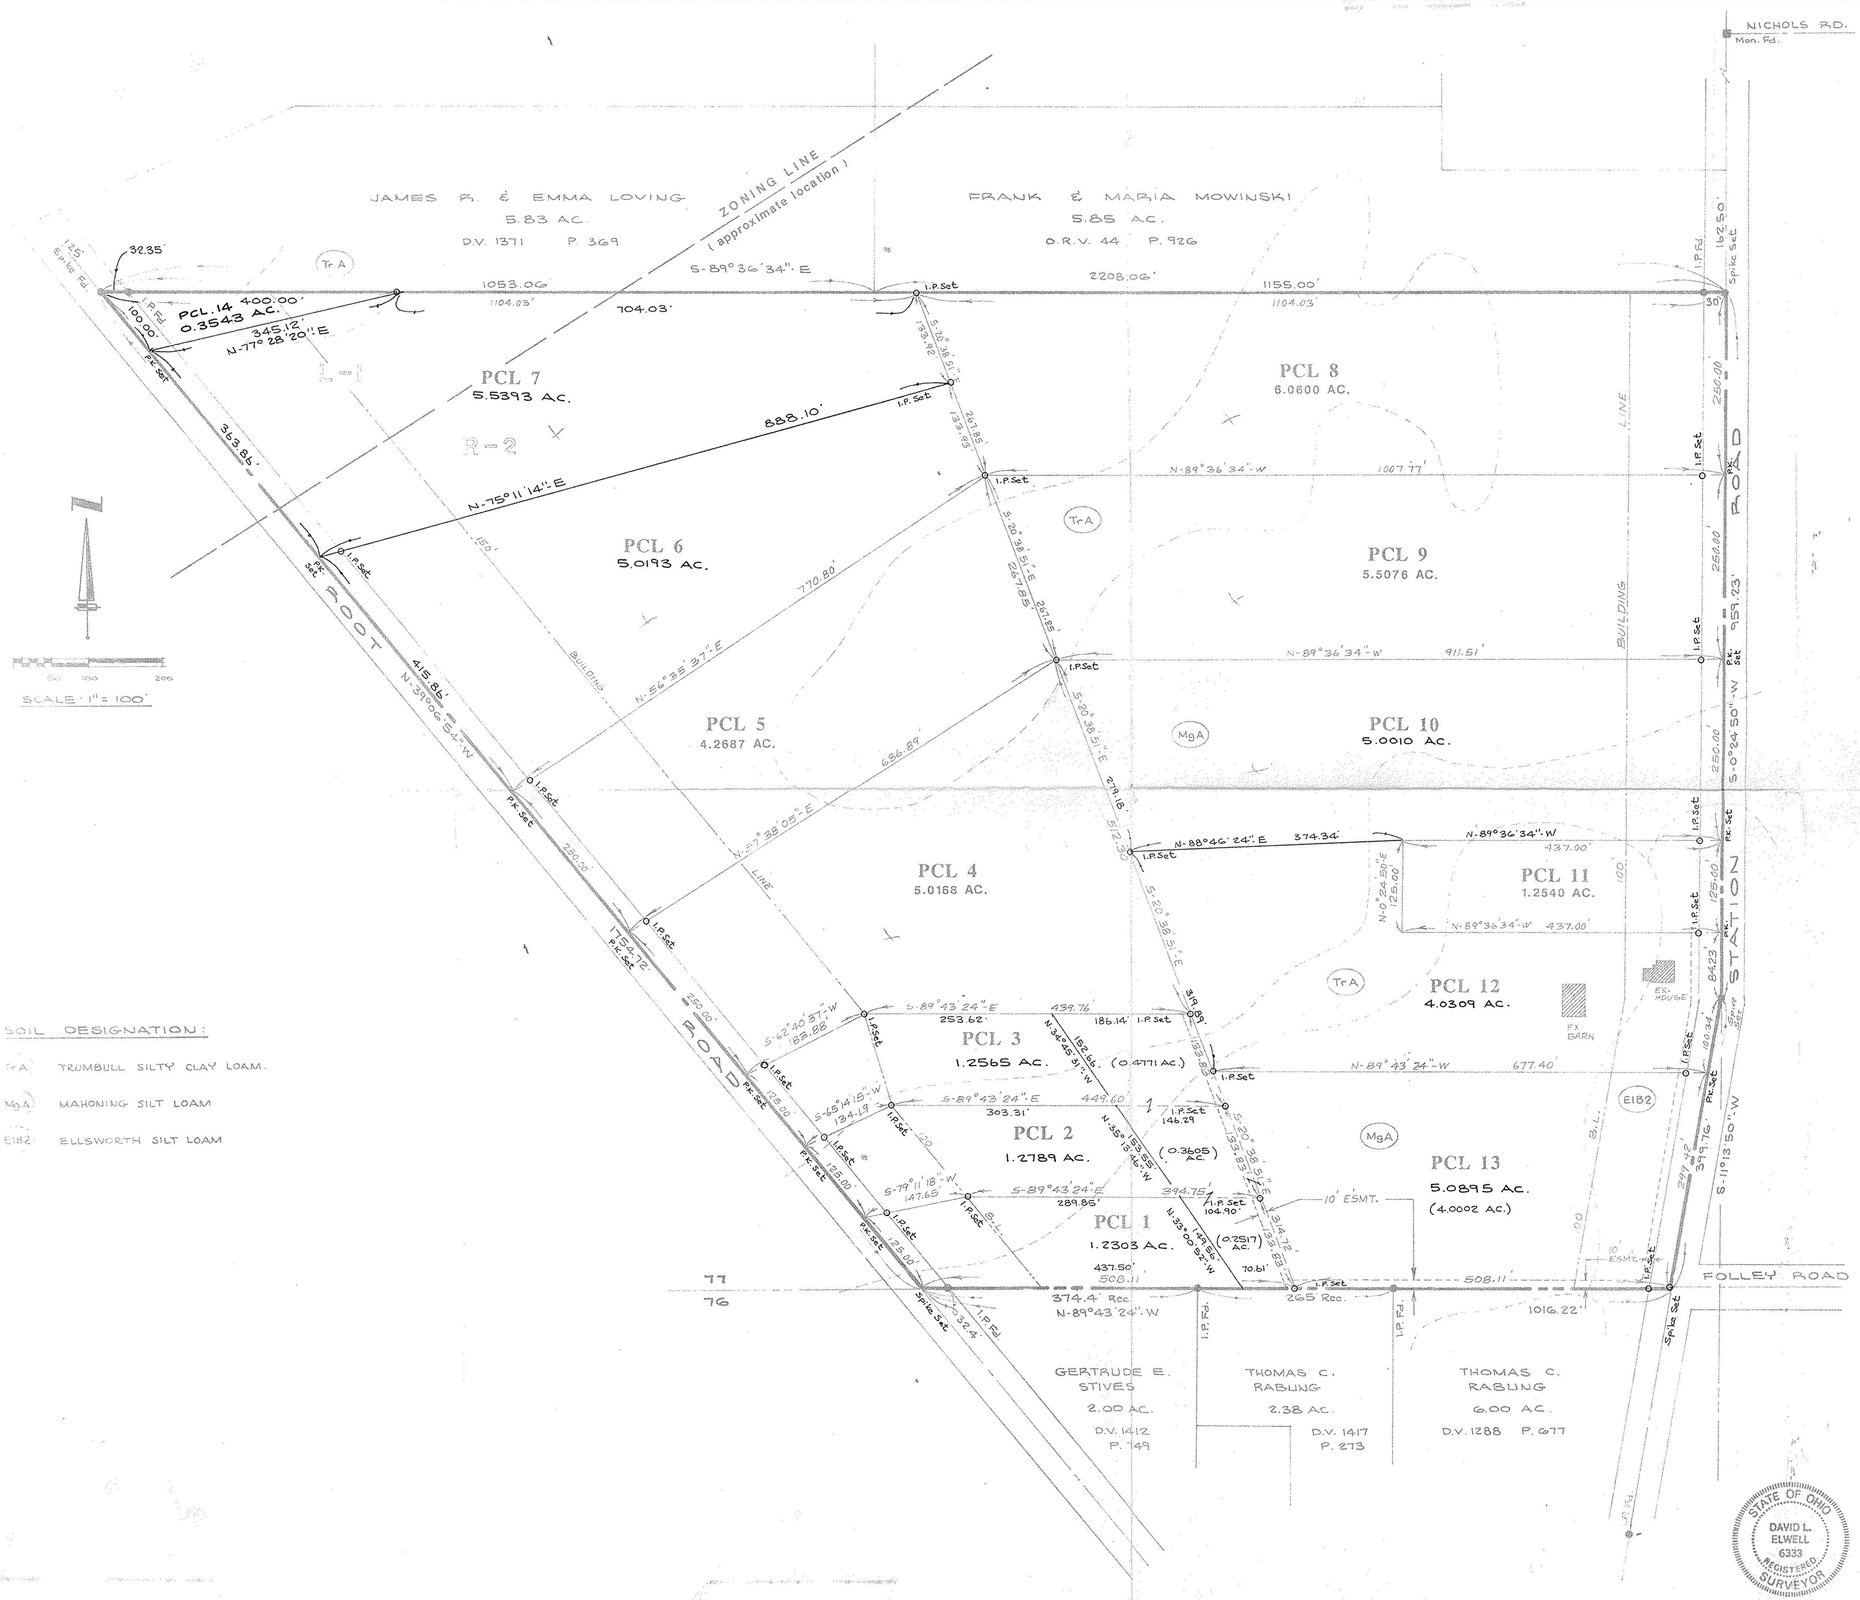

TOTAL PARCEL ACREAGE = 50.9072 Calc.
(50.21± Rec.)

SOIL DESIGNATION:

TrA TRUMBULL SILTY CLAY LOAM.

MgA MAHONING SILT LOAM

EI82 ELLSWORTH SILT LOAM

SURVEY & PARCEL MAP

PART OF COLUMBIA TOWNSHIP LOT 77
TOWNSHIP OF COLUMBIA COUNTY OF LORAIN
STATE OF OHIO

PREPARED BY
KS ASSOCIATES INC.
ENGINEERS SURVEYORS

JUNE 28, 1988 SURVEY DATA
JULY 11, 1988 PCLS. 1-13
REV. 7-21-88 PCLS. 6, 7, & 14
REV. 7-25-88
REV. 8-9-88 I.P.'S Set
REV. 1-19-89 - PCLS 1,2,3,13

STATE OF OHIO
DAVID L. ELWELL
6333
REGISTERED SURVEYOR

David L. Elwell
DAVID L. ELWELL - REG. SURV. Nº 6333

ENGINEERS • SURVEYORS
KS ASSOCIATES INC.
88-179

#18520 VO

APPROVED
LORAIN CO.
MAP DEPT.
DATE 7-10-89
PAGE 12-A
BY J. McLain
VOID AFTER 18520