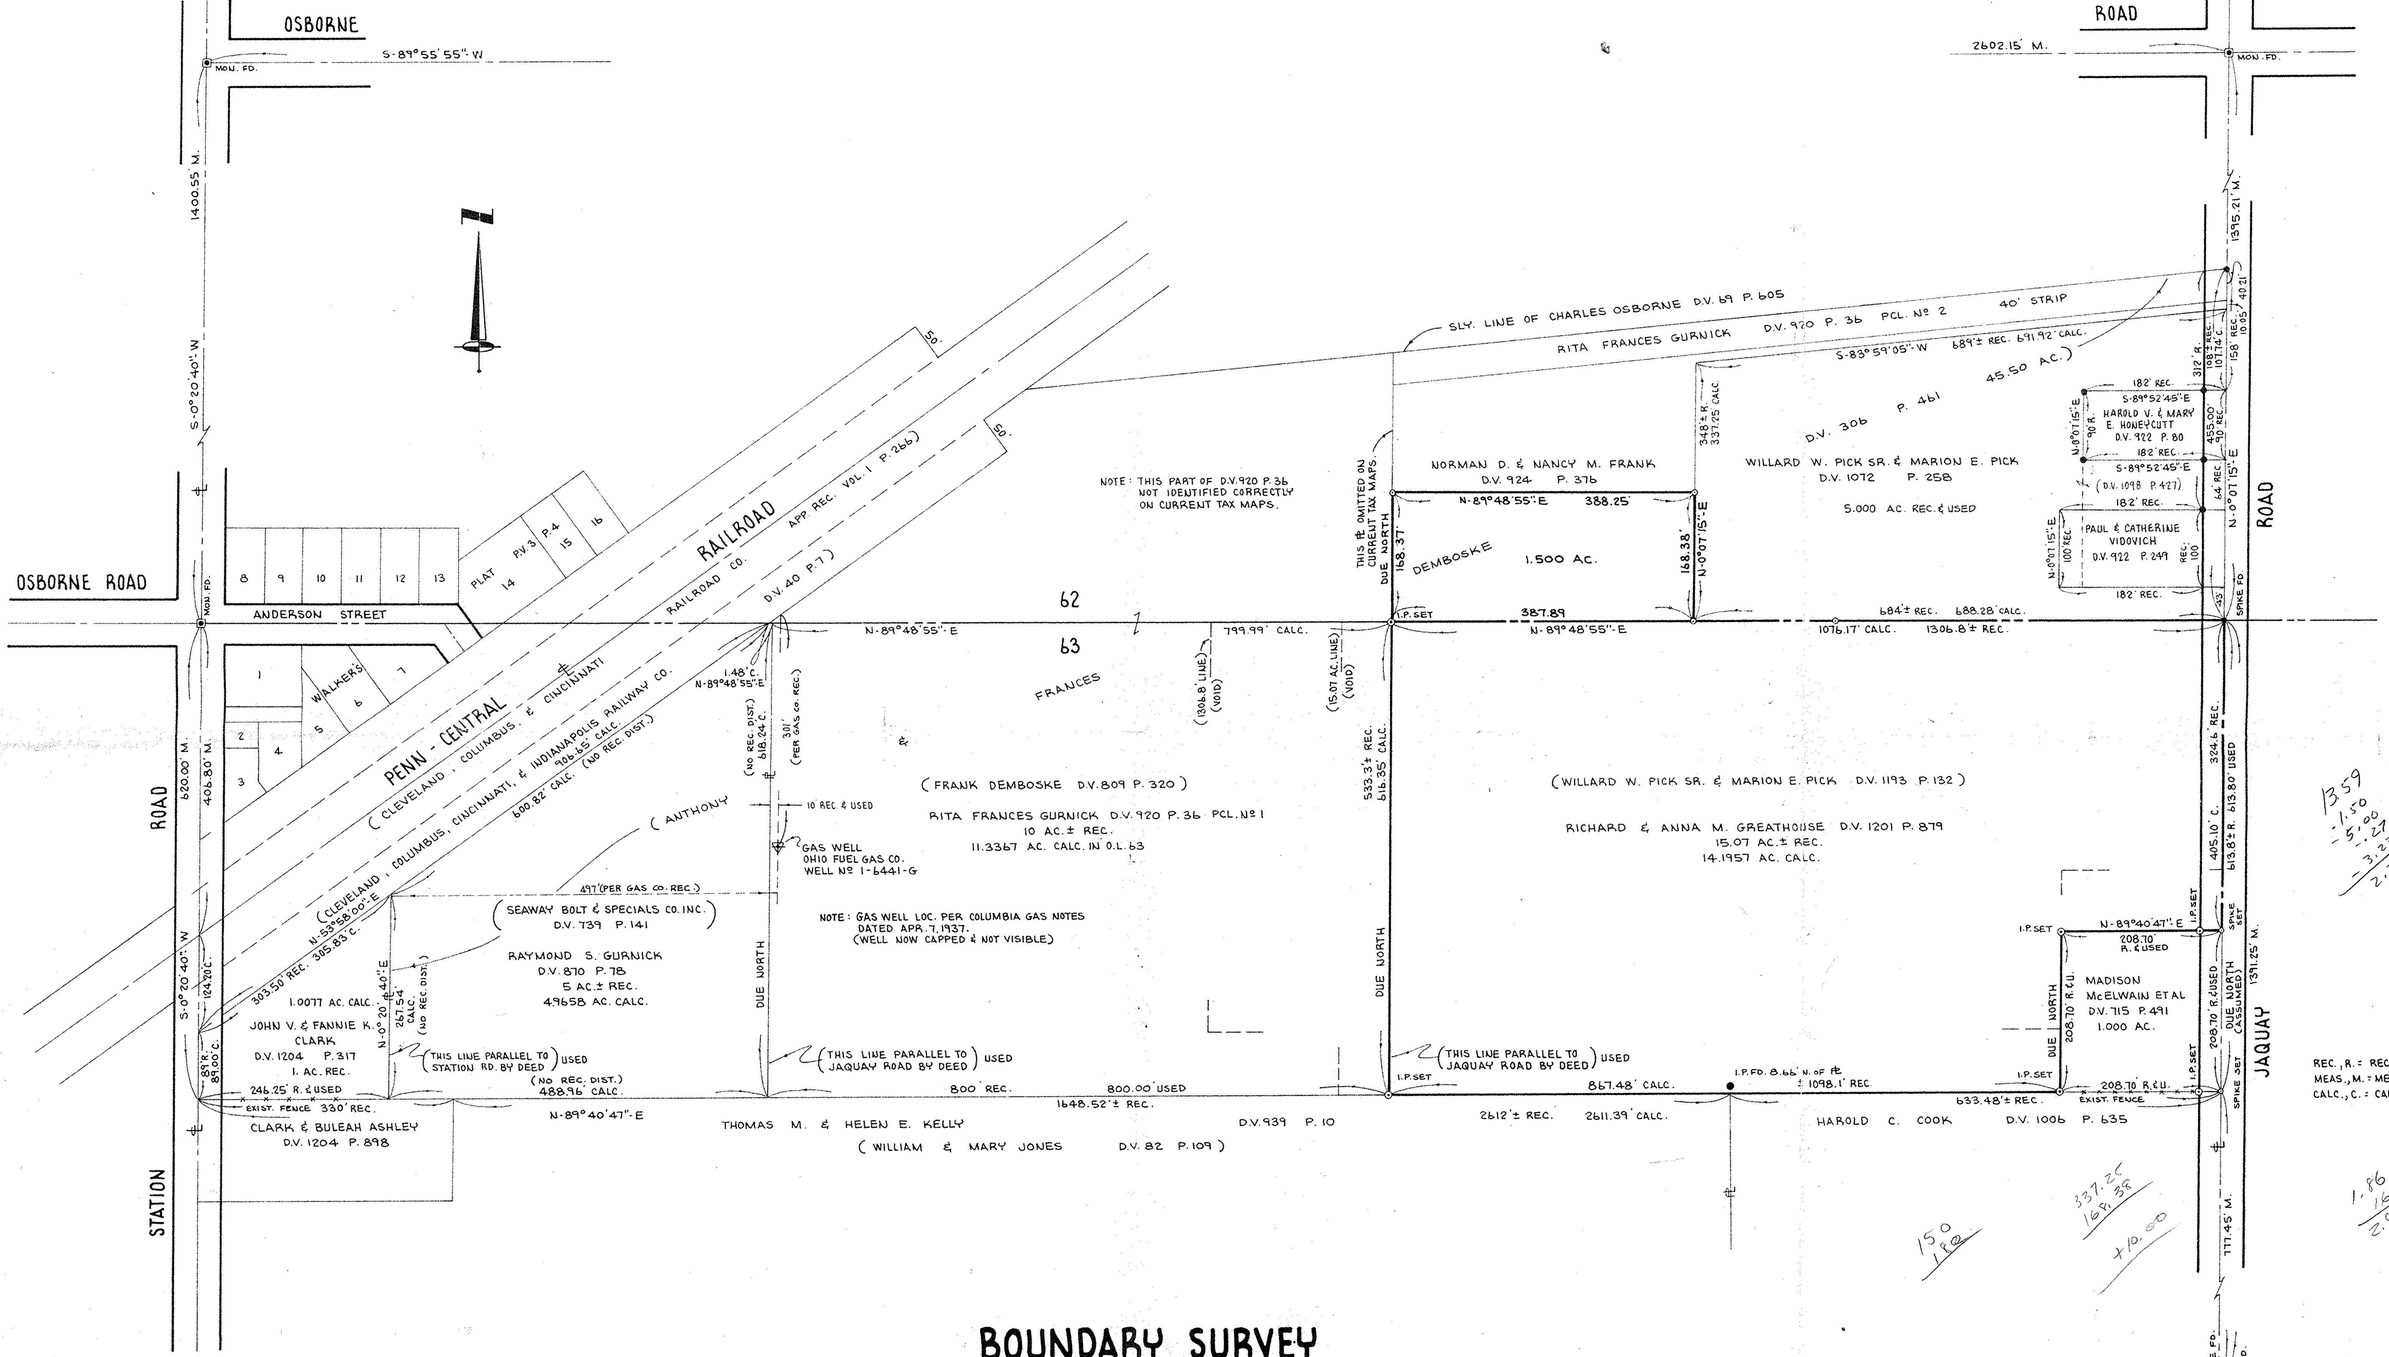

REC., R. = RECORD DATA
MEAS., M. = MEASURED DATA
CALC., C. = CALCULATED DATA.

BOUNDARY SURVEY

OF PART OF

COLUMBIA TOWNSHIP ORIGINAL LOT Nº 63

TOWNSHIP OF COLUMBIA — COUNTY OF LORAIN — STATE OF OHIO

SCALE: 1" = 100'

AUG. 1980
REVISED 3-19-84

PREPARED BY
KLEINOEDER - SCHMIDT & ASSOC.
CONSULTING ENGINEERS & SURVEYORS

#15513
APPROVED
LORAIN CO.
MAP DEPT.
DATE 4. 18. 84
PAGE 12.00.062.
BY T. McNair
VOID AFTER

JOB. NO.
80-101