


190.00 REC. 5025.
N-80° 15' 00" - E
230.00 REC. 5025.

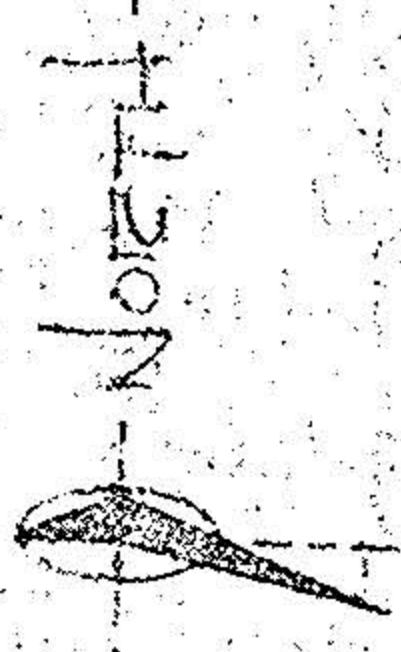

MAY, 1974

SCALE: 1" = 40'

ROAD 60
740041

BOUNDARY & LOCATION
SURVEY
OF
0.0282 ACRES
PART OF
ORIGINAL LOT 61
COLUMBIA TOWNSHIP
COUNTY OF LOZAIN STATE OF OHIO

PREPARED FOR:
ELZA E. & LAURA NEAL
SEAWAY TITLE CO. OF
ELYRIA OHIO

PREPARED BY:
FOOZ & ASSOCIATES
REGISTERED SURVEYORS
N. RIDGEVILLE, OHIO