
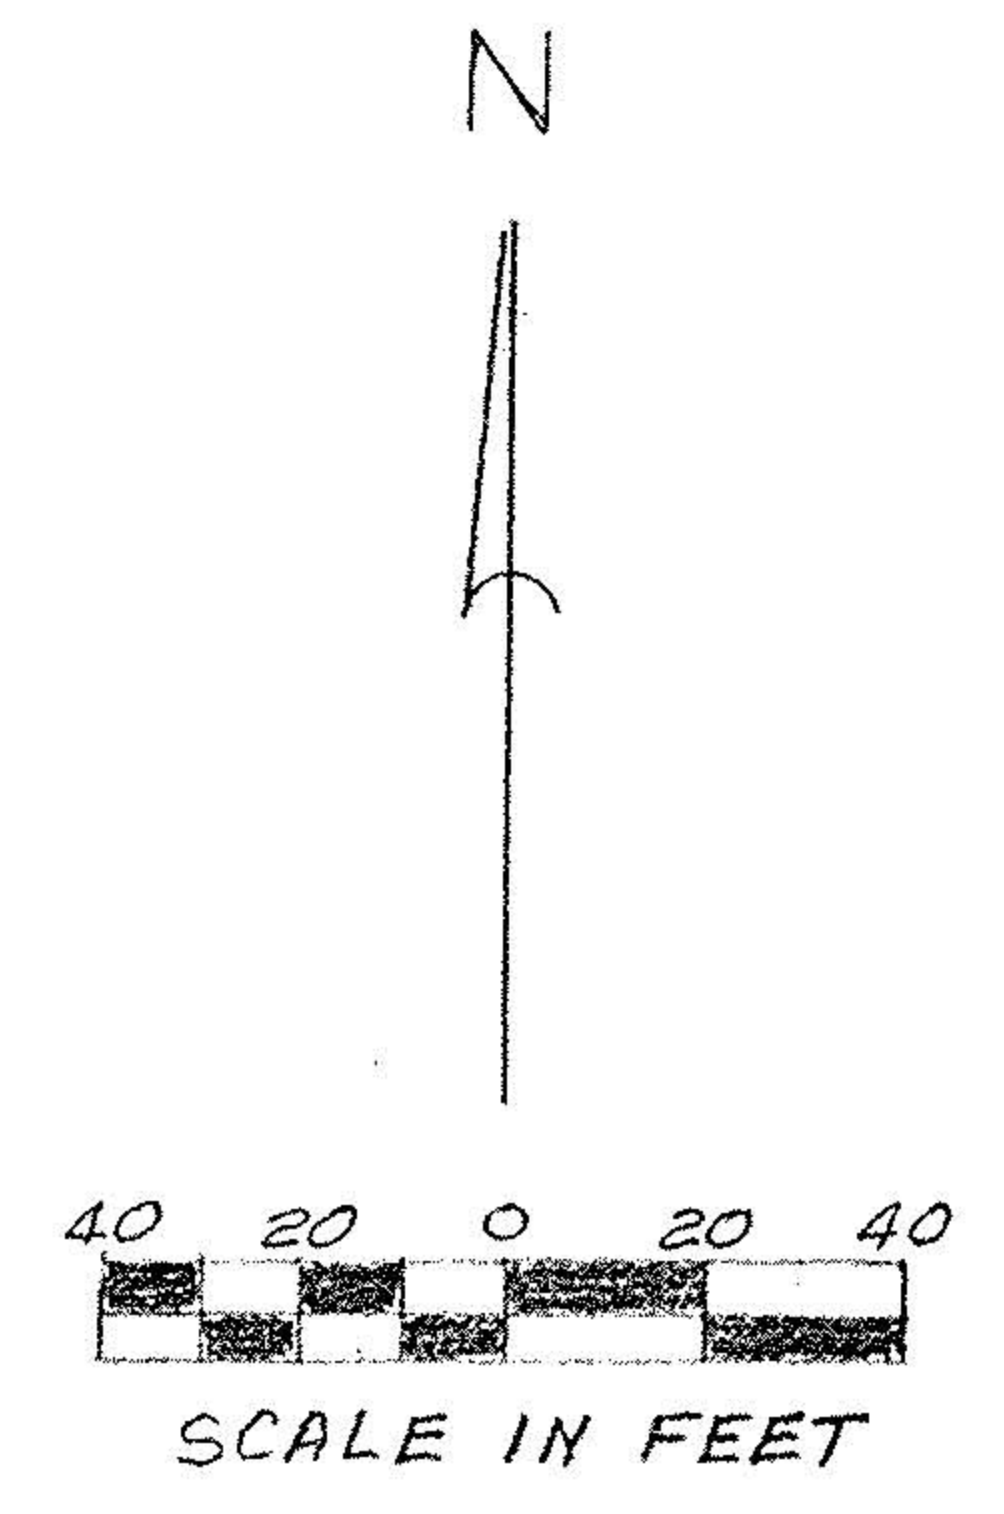


LOT SPLIT FOR BRUCE C. LUBINSKI  
 Part of Lot No. 18 of Original Ridgeville Township  
 in the City of Northridgeville, County of Lorain and  
 State of Ohio

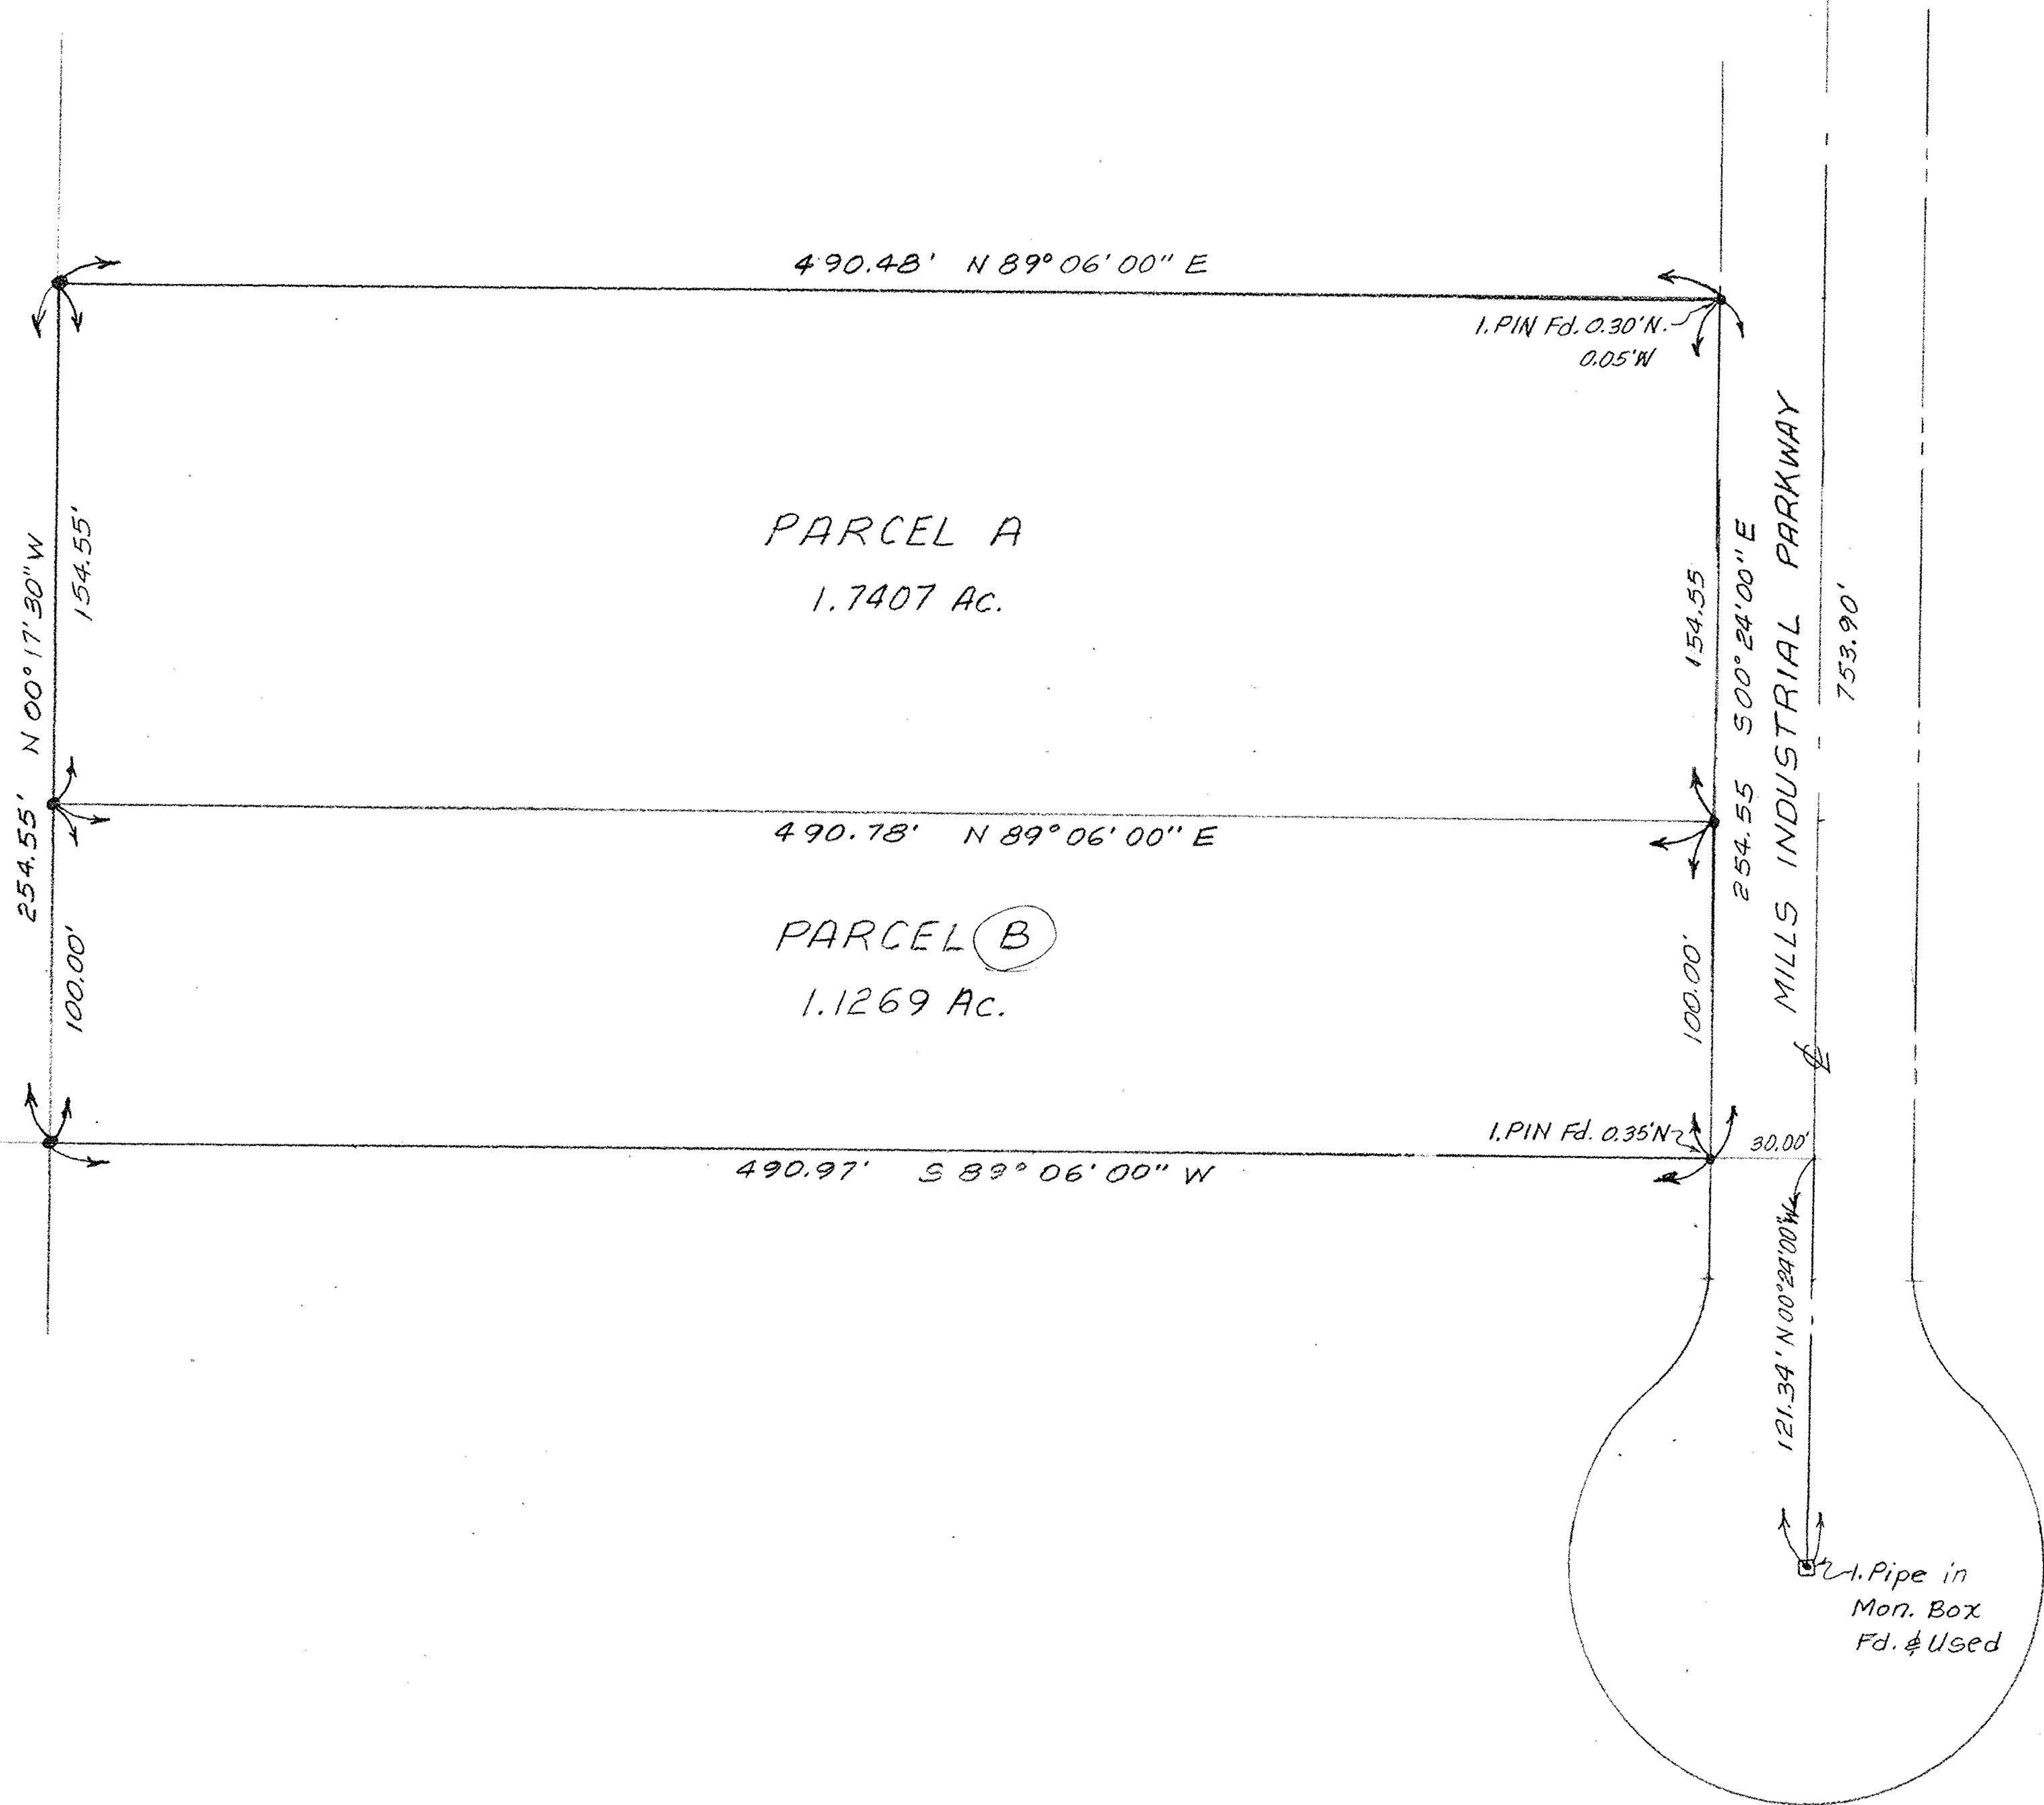

DATE: 2-2-1993

IRON PINS WERE SET OR FOUND AT ALL POINTS INDICATED BY A "•". DIMENSIONS ARE EXPRESSED IN FEET AND DECIMAL PARTS THEREOF, ALL OF WHICH I CERTIFY TO BE CORRECT.

*Raymond W. Hass*  
 5-5152

