

Robert Flanagan


1967 to E. Mills Rd.

Martin Robert Flanagan
Attorney at Law

James S. Bloazok.

PHONE: (216) 323-6272

674 OBERLIN ROAD
ELYRIA, OHIO 44035

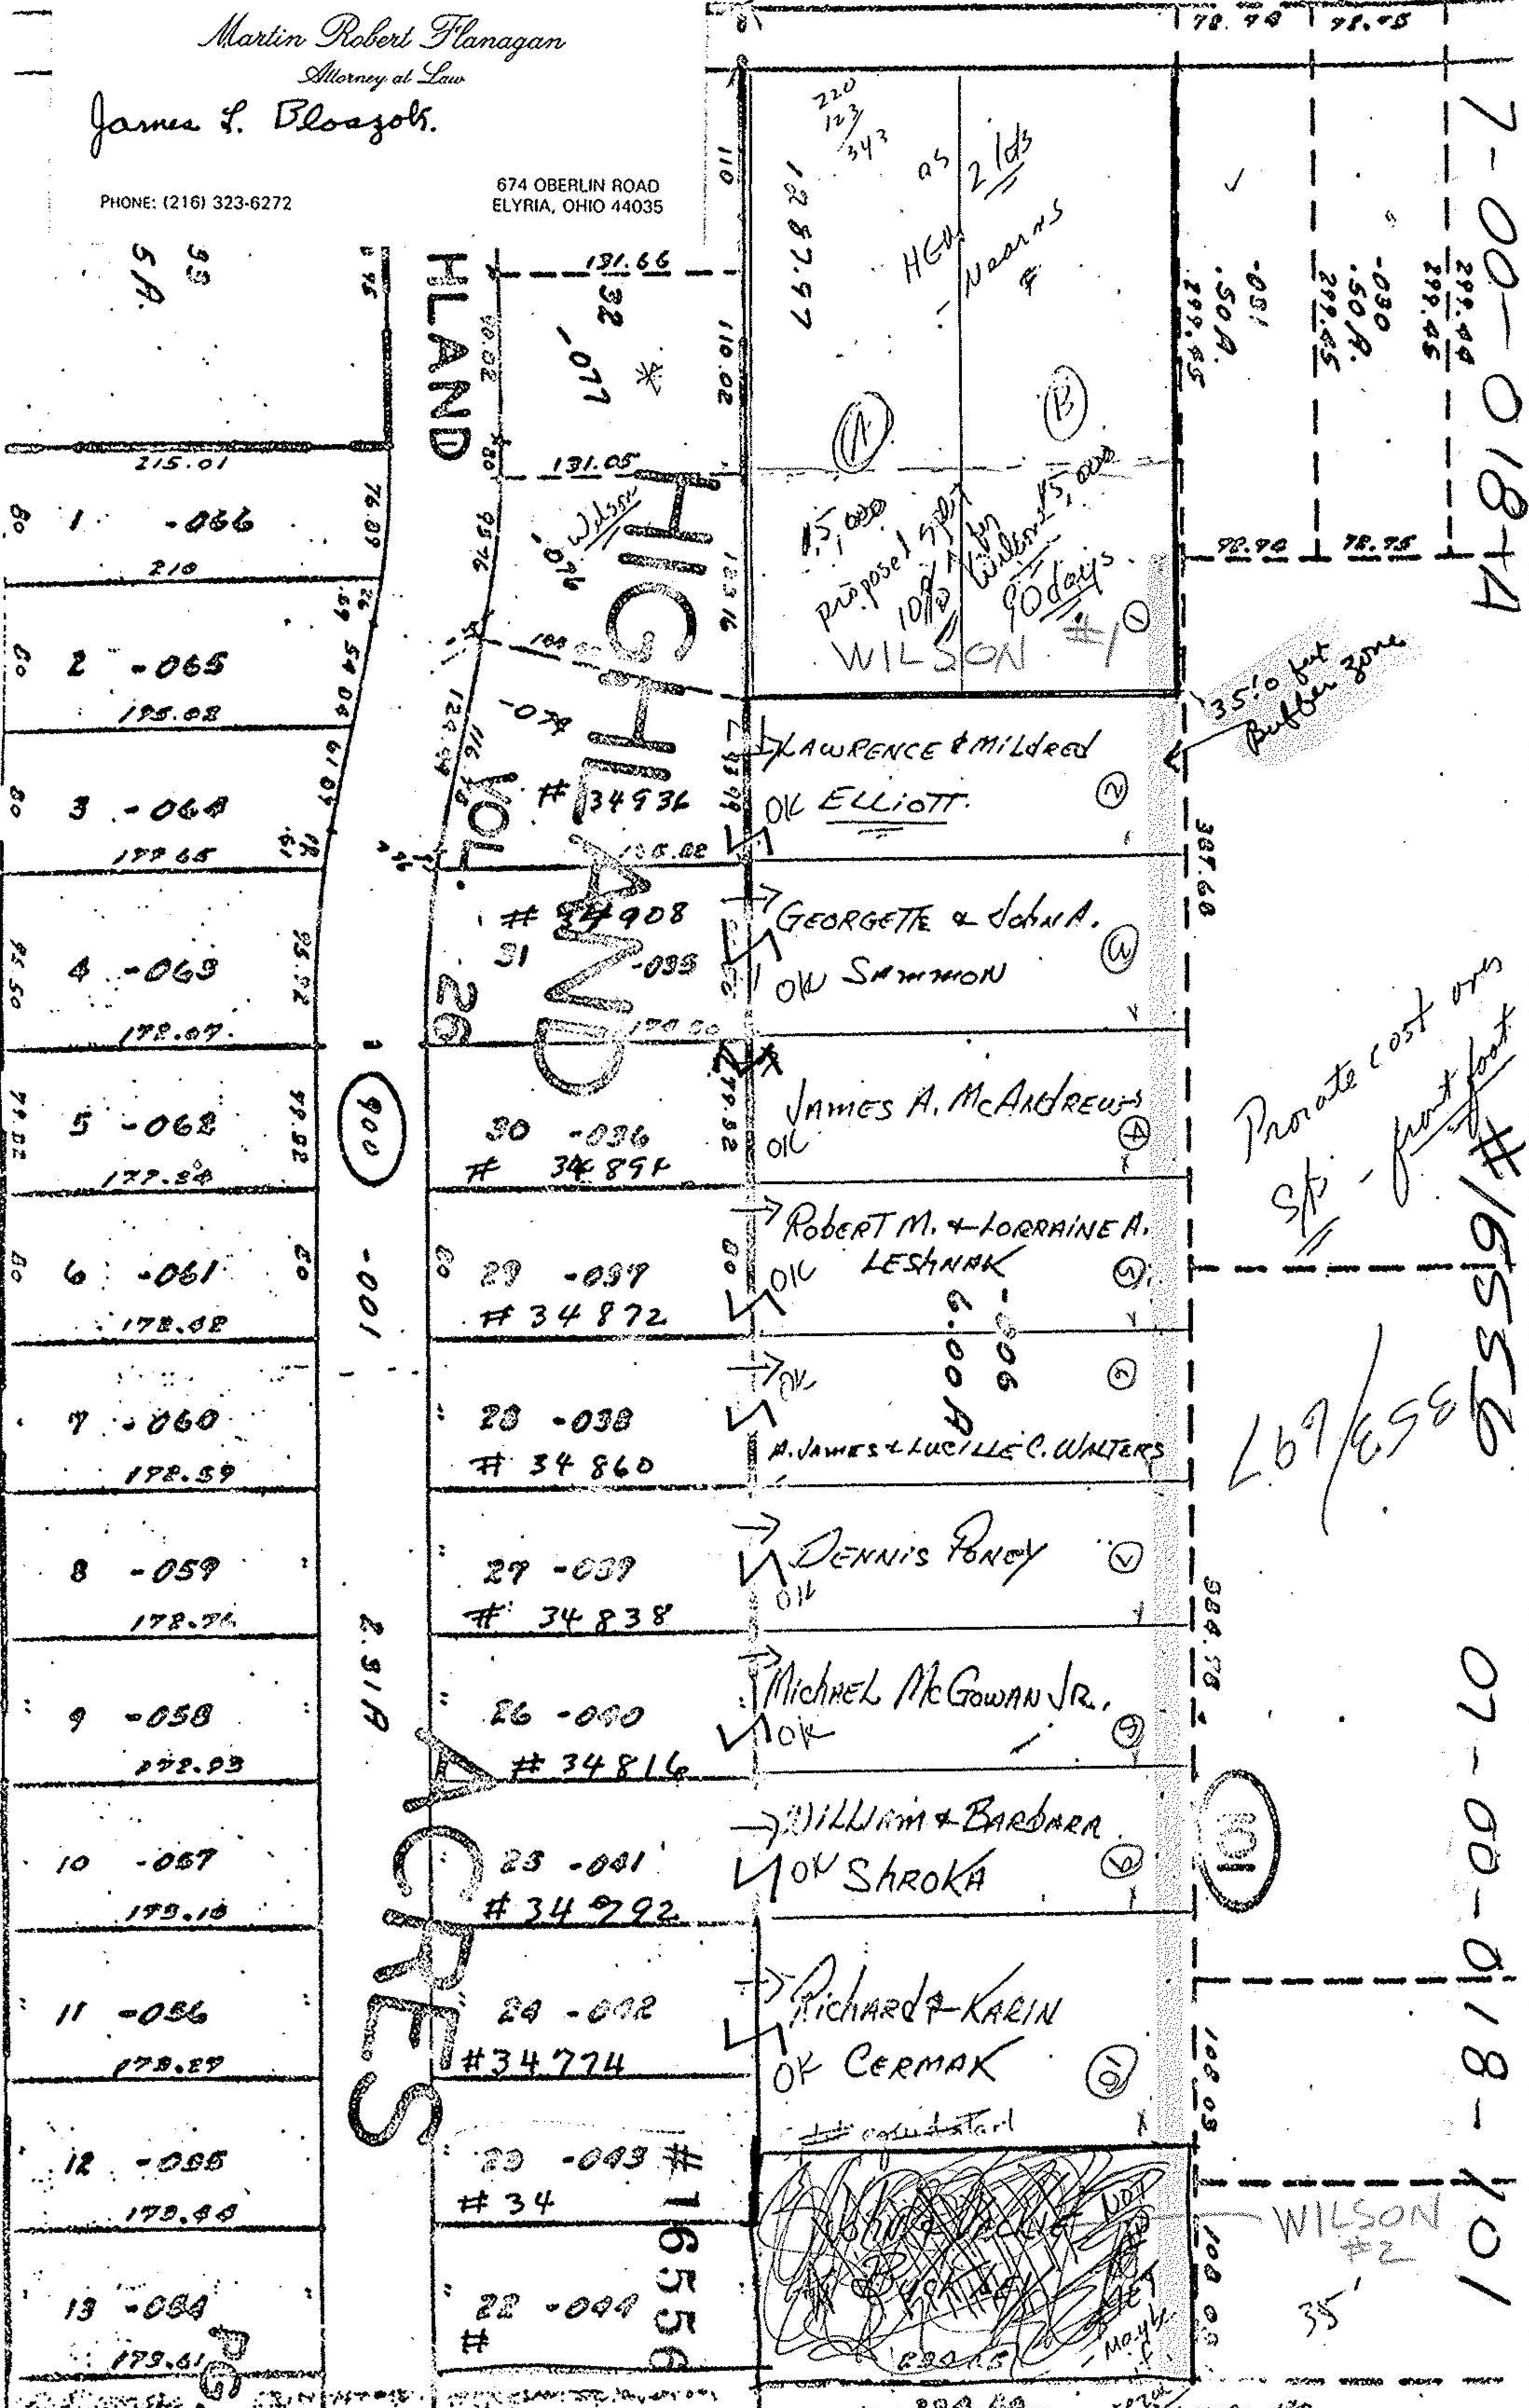

7-00-018-1A

#16556

07-00-018-101

78.78 78.45

78.90 78.75

387.60

584.78

108.03

100.00

35-foot Buffer Zone

Pro-rate cost on
St. front
69/658

101

WILSON #2

35'

James G. ...

Buffer Zone