


7590

NCT 03

C. & O. HEADLEY

15.67 AC.

TAKE

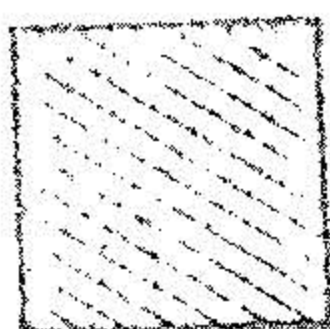

= 14.81 ac.

15.67
14.81
86 AC


NBR
10

03-00-077-115-0



APPROVED BY THE LORAIN CITY PLANNING
COMMISSION..... NO PLAT REQUIRED
SECRETARY LORAIN CITY PLANNING COMMISSION

77 CITY OF LORAIN 1"=200'

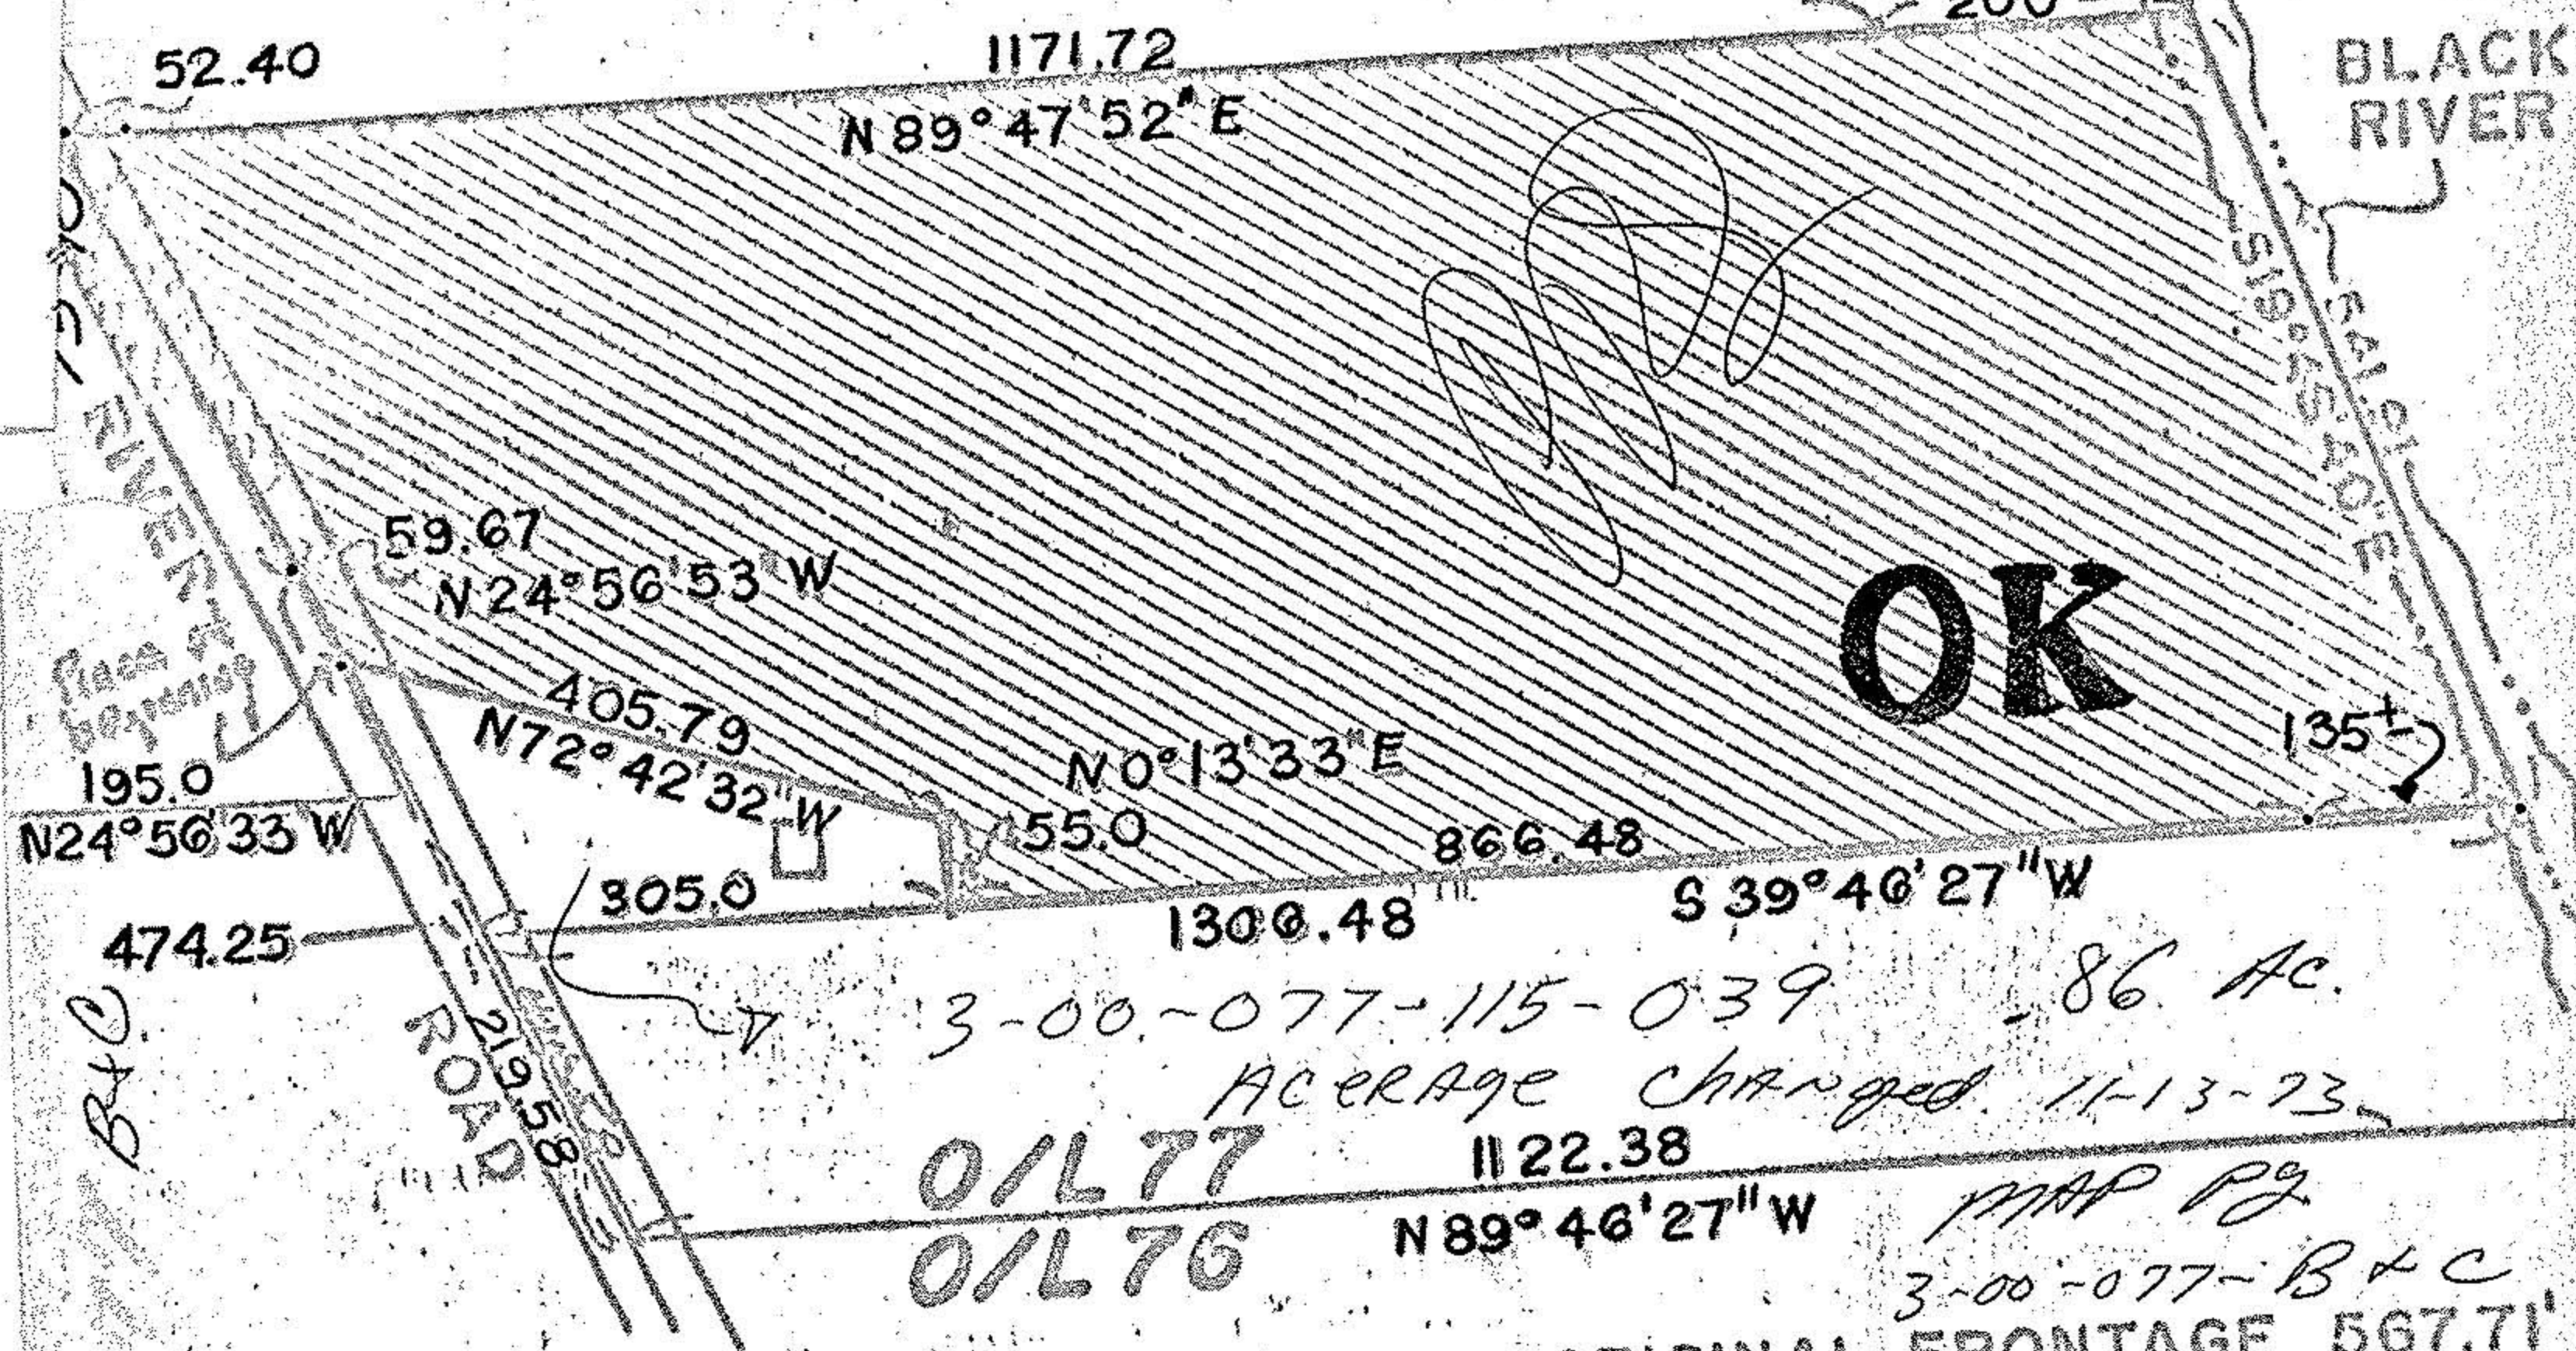

OK

3-00-077-115-039 86 AC.
ACERAGE CHANGED 11-13-73
O/L 77 1122.38
O/L 76 N 89° 46' 27" W

ORIGINAL LOT 77
SHEFFIELD TWP.
LORAIN COUNTY, O.
PERM. PARCEL 03-00-077-115-016

DELIMAN

ORIGINAL FRONTAGE 567.71'
L.C.M.P.D. 372.71'
HEADLEY 195.00'

MAP Pg
3-00-077-B & C

NBR
10

SURVEYED 10-25-72 By Hunt & Skelton