
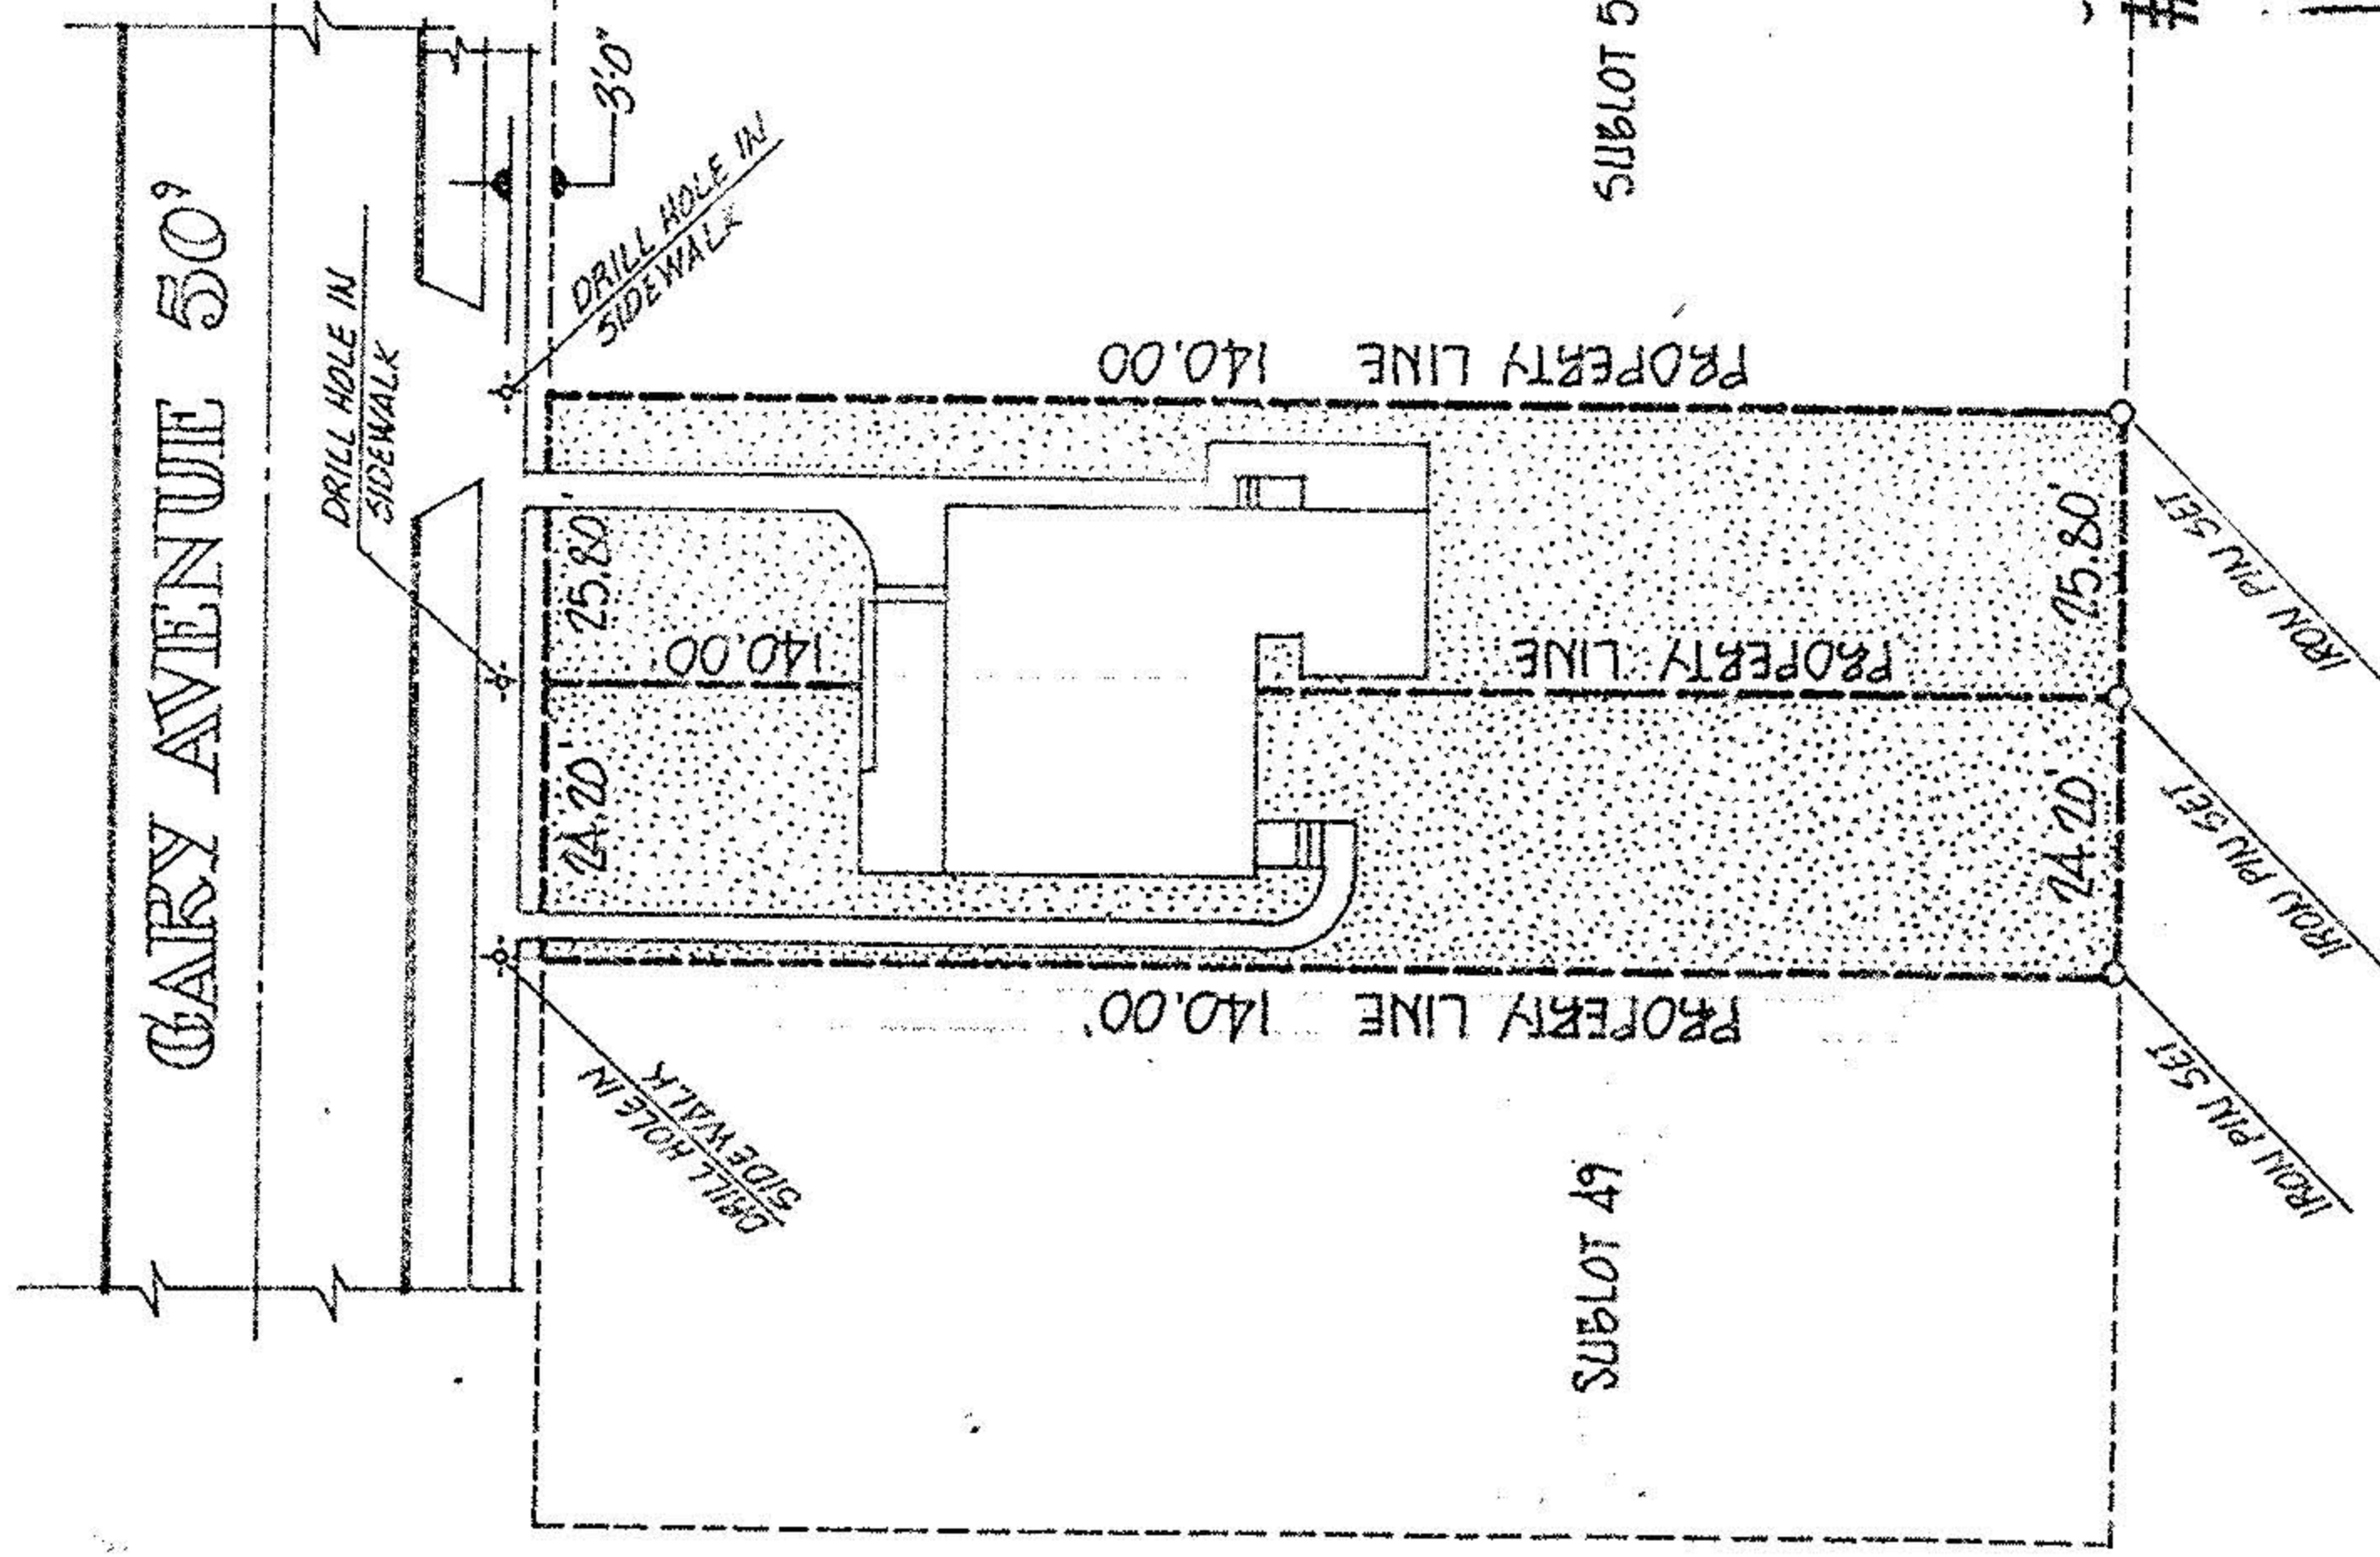


3-00-079-101-

1

3-00-079-A

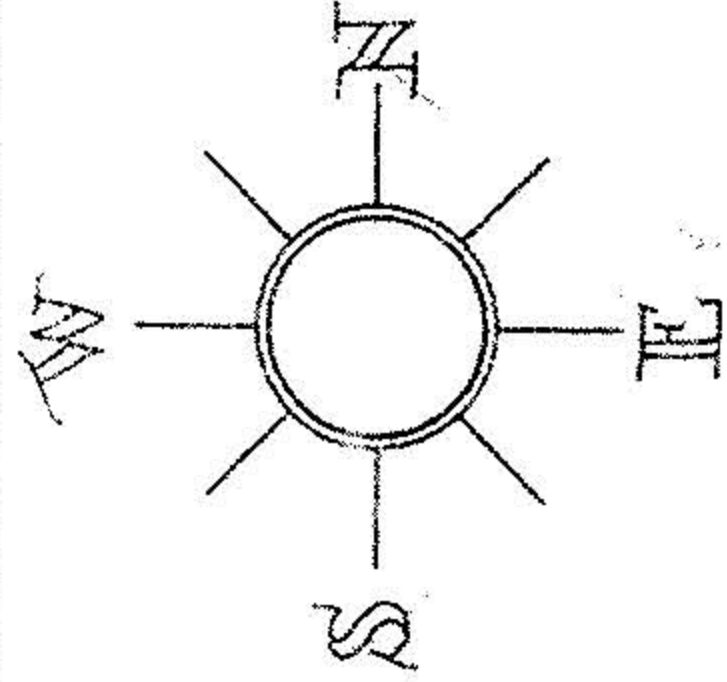

#14929

APPROVED.
LORAIN CO.
MAP DEPT.

DATE 6-20-83
PAGE 3-00-079-A
BY T.M. McNeil
VOID AFTER

ACREAGE

DATE 06-15-83

SCALE 1" = 30 FT.

DRAWN MGH



Michael G. Hura and Associates
3409 LIBERTY AVENUE VERMILION, OHIO

PERIMETER SURVEY

PART OF O.L. 79 TR. SECTION OF
SHEFFIELD Township LORAIN County, Ohio
SUBLOT 50 of **HOMWOOD ADDITION**
VOL. 14 PAGE 22 & 23 OF PLATS

PERMANENT PARCEL NO.
03-00-079-101-004