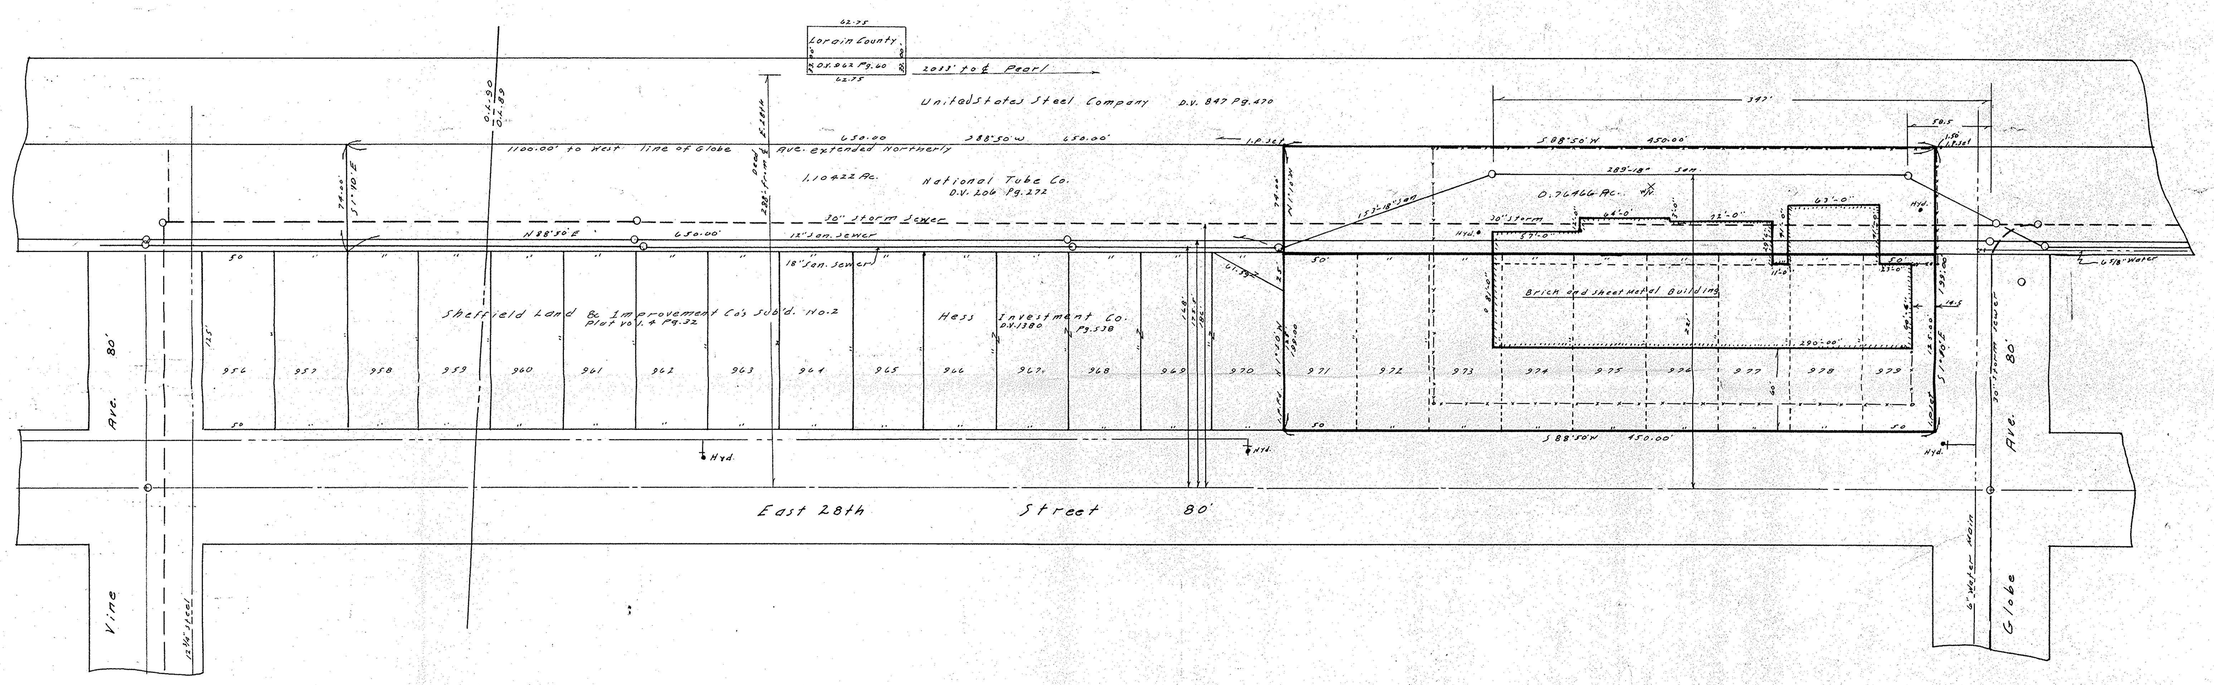

03-00-089-101
102

#17687

APPROVED
LORAIN CO.
MAP DEPT.
DATE 9-18-87
PAGE 3-00-096 A
BY C. Francis
VOID AFTER 17687

SURVEY
of
Part of Original Lot No. 89 and sub-lots 971 thru 979 of Sheffield Land and Improvement Company's Subdivision No. 2 recorded in Vol. 4 Pg. 32 Lorain County Record of Plats. In the City of Lorain, Lorain County Ohio. By William B. Barton Reg. Land Surveyor No. 4438 Scale 1" = 50'
March 14, 1987
Rev. March 28, 1987
Rev. August 27, 1987

N.

I hereby certify that the above is a true and correct survey by me
March 14, 1987 William B. Barton L.S. 4438
188 Parkwood Ave. Avon Lake Ohio 44012
(216) 933-6662

STATE OF OHIO
WILLIAM B. BARTON
4438
REGISTERED
SURVEYOR