


WILLIAM B. BARTON  
 Reg. Land Surveyor No. 4438  
 188 PARKWOOD AVENUE  
 AVON LAKE, OHIO 44012  
 TELEPHONE (216) 933-6662

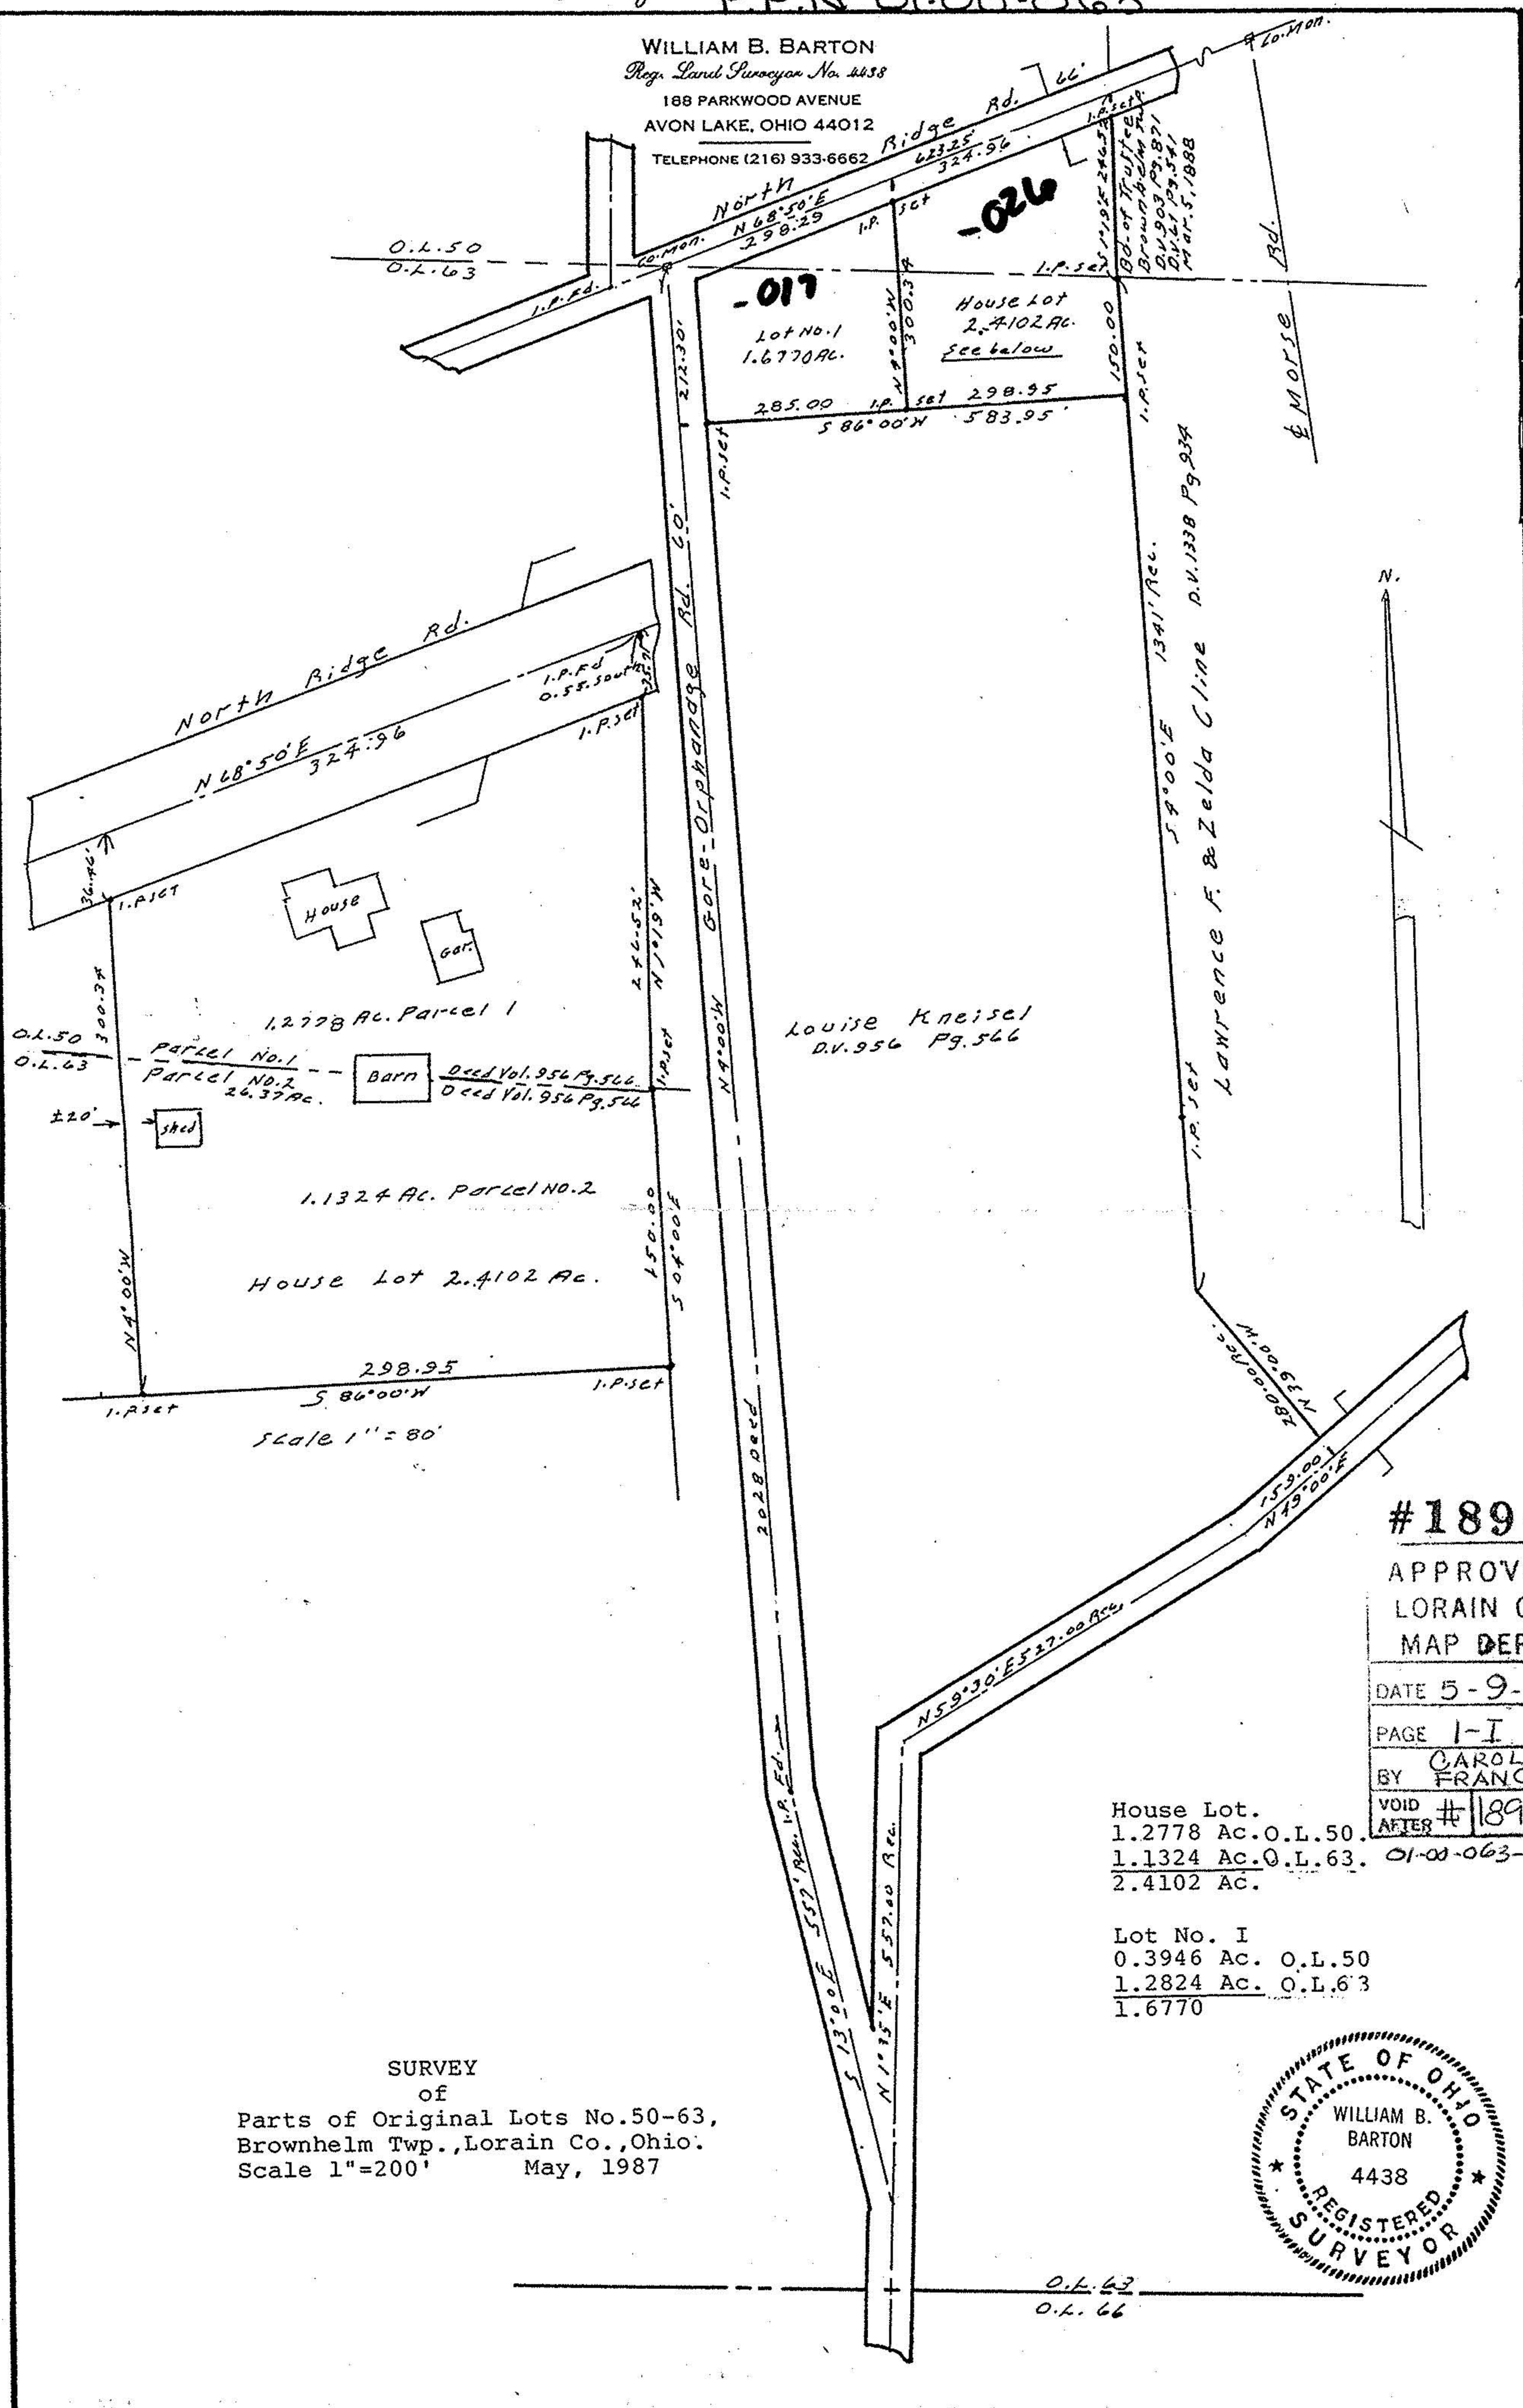

Louise Kneisel  
 D.V. 956 Pg. 566

1.2778 Ac. Parcel 1  
 Parcel No. 1  
 Parcel No. 2  
 Barn  
 Deed Vol. 956 Pg. 566  
 Deed Vol. 956 Pg. 566

1.1324 Ac. Parcel No. 2  
 House Lot 2.4102 Ac.

298.95  
 S 86° 00' W  
 Scale 1" = 80'

#18944  
 APPROVED  
 LORAIN CO.  
 MAP DEPT.  
 DATE 5-9-90  
 PAGE 1-I  
 BY CAROLYN FRANCIS  
 VOID AFTER #18944

House Lot.  
 1.2778 Ac. O.L. 50.  
 1.1324 Ac. O.L. 63.  
 2.4102 Ac.  
 Lot No. I  
 0.3946 Ac. O.L. 50  
 1.2824 Ac. O.L. 63  
 1.6770

SURVEY  
 of  
 Parts of Original Lots No. 50-63,  
 Brownhelm Twp., Lorain Co., Ohio.  
 Scale 1" = 200' May, 1987



O.L. 63  
 O.L. 66