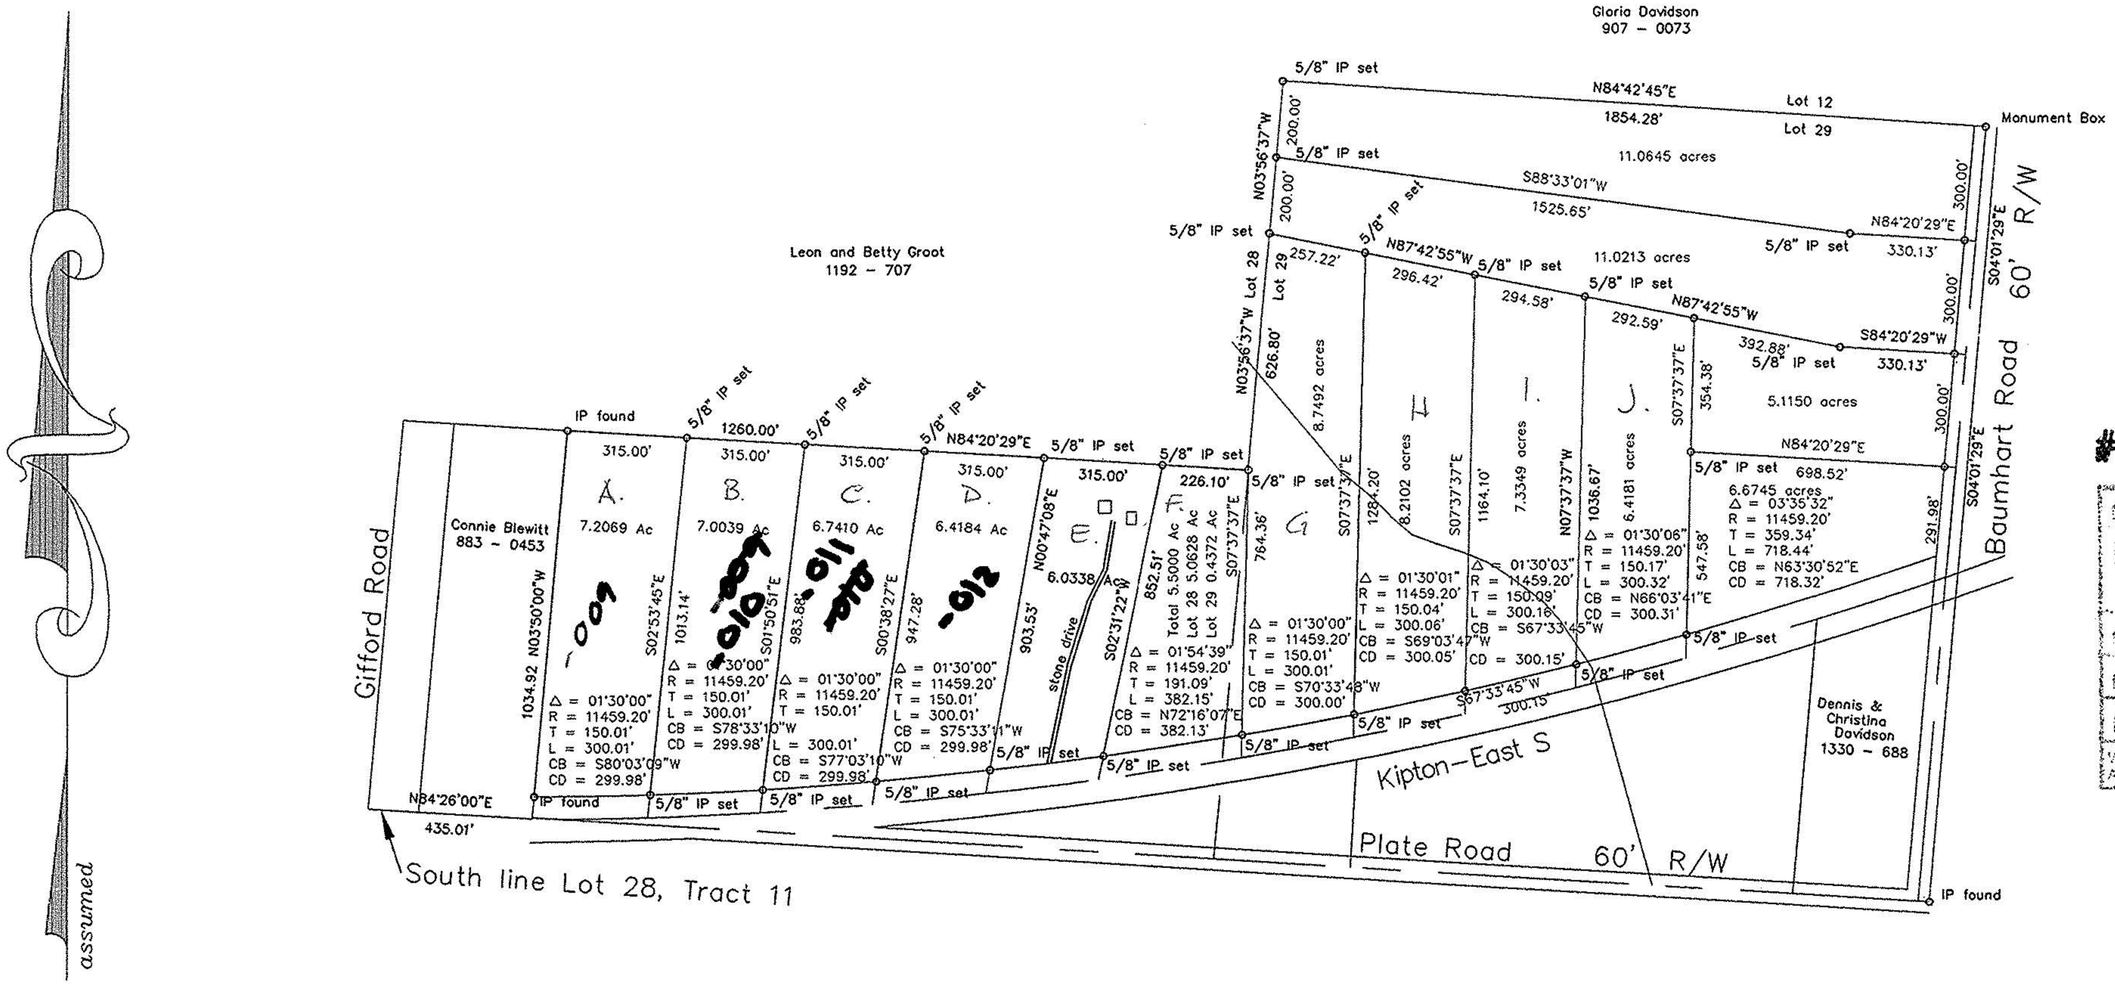

#21958

APPROVED
LORAIN CO.
MAP DEPT.
DATE 11-15-96
PAGE 13-D
BY T.McMain
VOID AFTER 21958

GRAPHIC SCALE

400 0 200 400 800 1600

(IN FEET)
1 inch = 400 ft.

STATE OF OHIO
Carl M. Feick
S-7035
REGISTERED PROFESSIONAL SURVEYOR

Carl Feick
Carl M. Feick P.S. 7035

FEICK SURVEYORS

224 East Water Street, Sandusky, Ohio 44870, 419-625-3241

DRAWN BY: CMF DATE: 10/12/95

JOB NO.: S4737 SHEET 1 OF 1

Plat of Survey

Chuck Davidson

49300 Rt. 20 West
Tract 11,Lots 28 & 29
Camden Twp., Lorain Co. Ohio