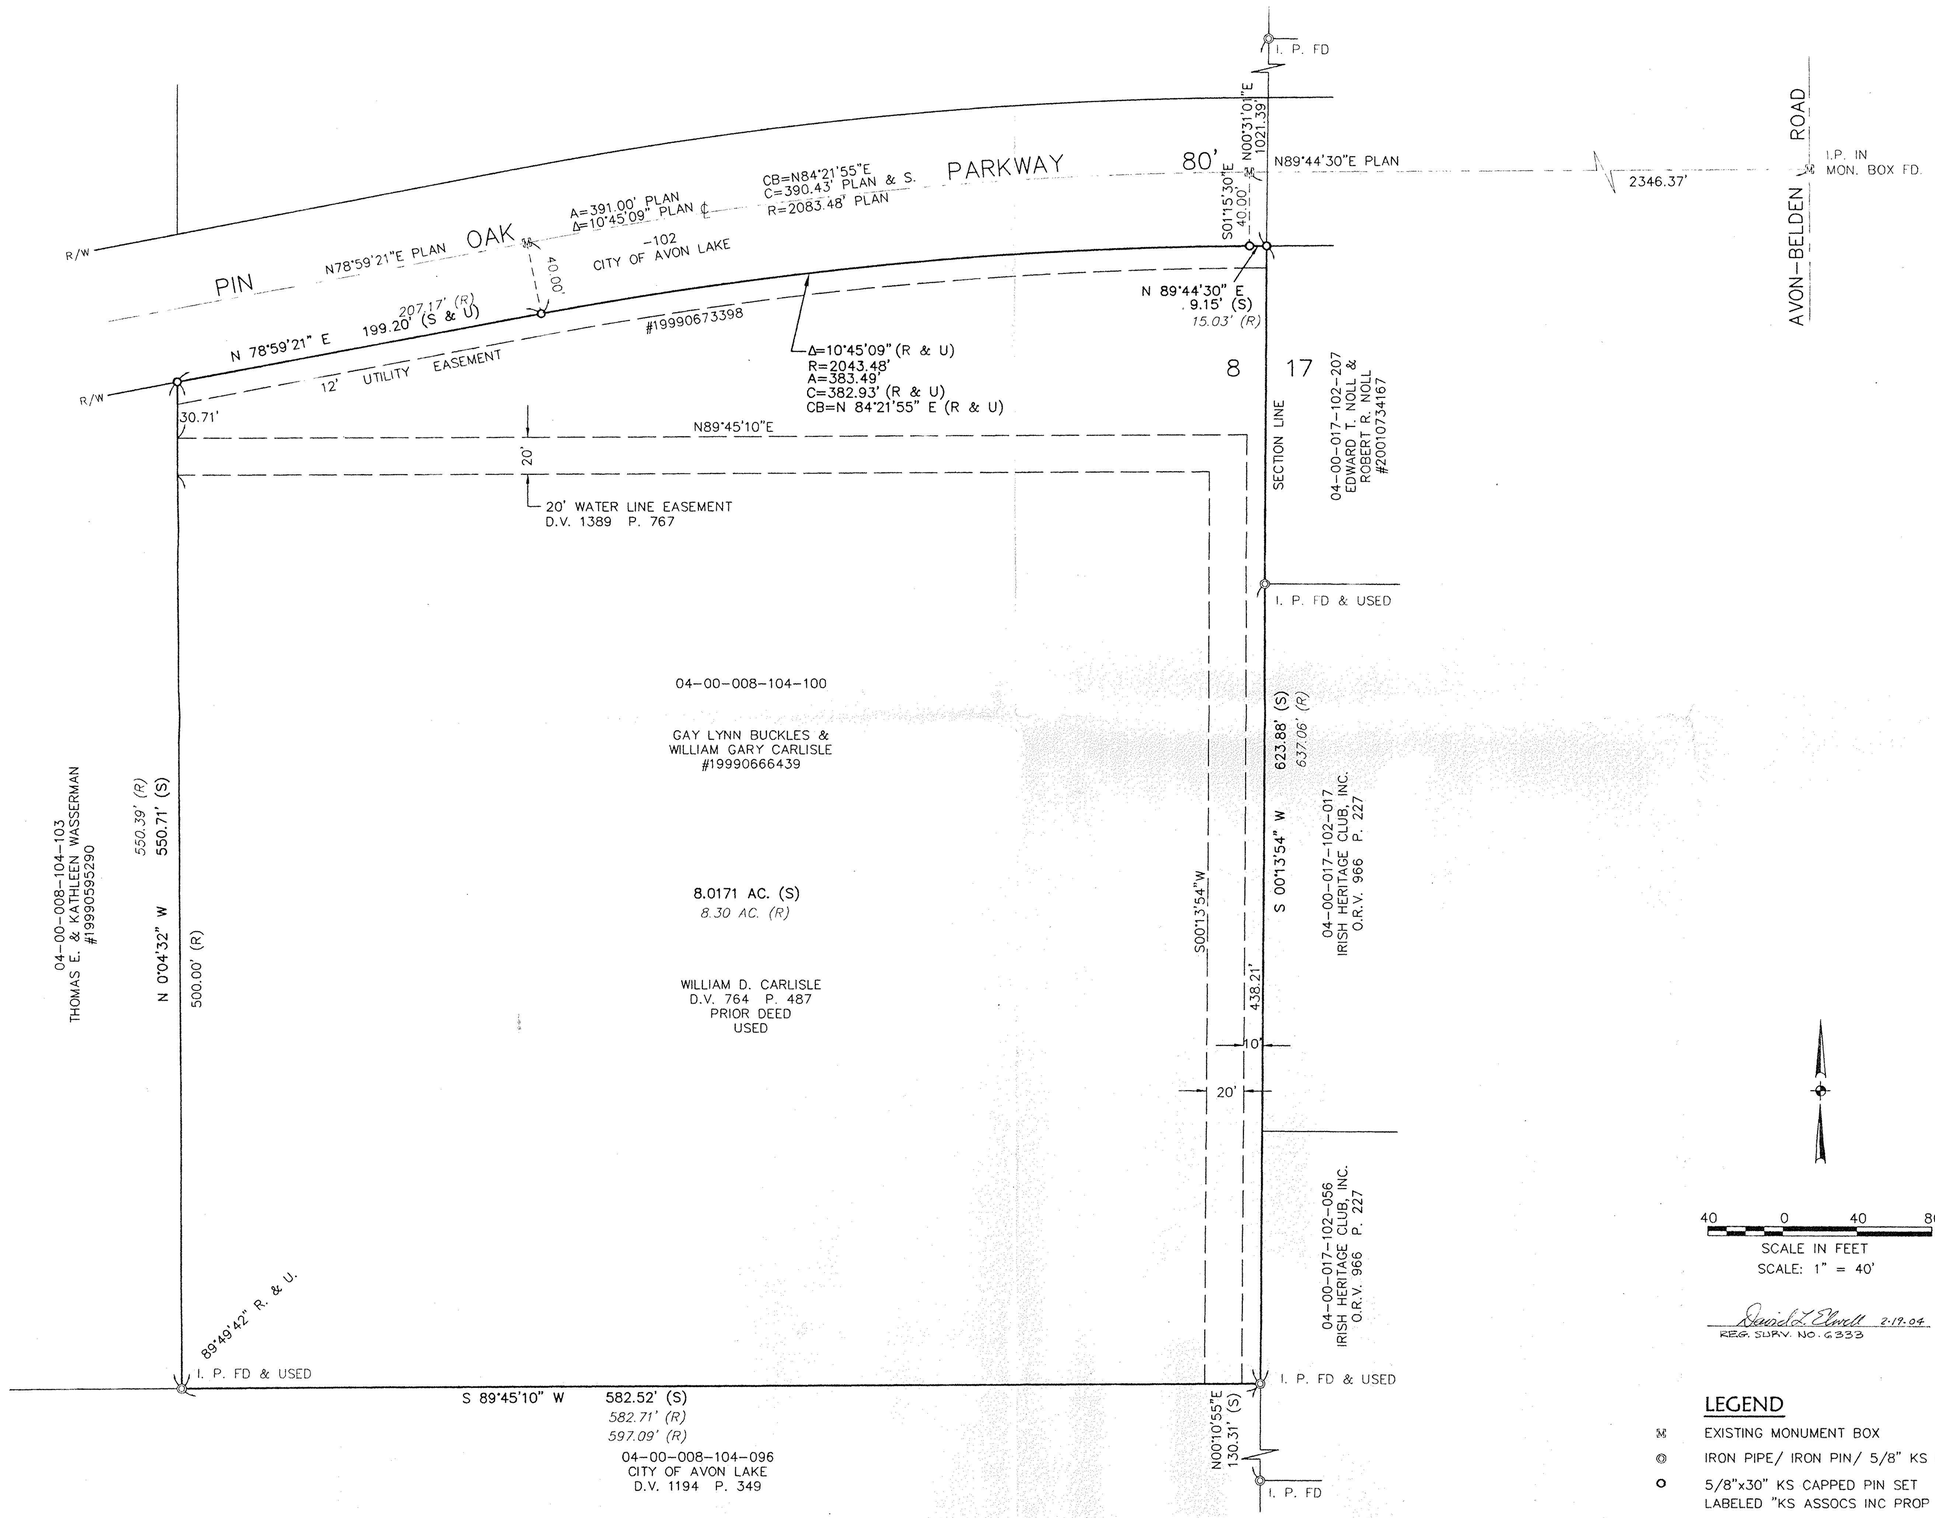

40 0 40 80

SCALE IN FEET

SCALE: 1" = 40'

APPROVED
LORAIN CO.
MAP DEPT
DATE 6/24/04
PAGE 04-00-008-A
BY D. Holland
#04-01021-A

David L. Elwell 2-19-04
REG. SURV. NO. 6333

STATE OF OHIO
DAVID L. ELWELL
6333
REGISTERED SURVEYOR

LEGEND

- EXISTING MONUMENT BOX
- IRON PIPE/ IRON PIN/ 5/8" KS CAPPED PIN FOUND
- 5/8"x30" KS CAPPED PIN SET LABELED "KS ASSOCS INC PROP MARKER"

REVISIONS			
	DATE	DESCRIPTION	BY

DATE: 02-18-04
DRAWN BY: DAM
CHKD BY:
DWG. NAME: O-BOUNDARY01
PATH: R:\04033\LDOT\CONTROL
F.B.

KS ASSOCIATES
KS Associates, Inc.
840 Bons Rd. Suite 100
Elyria, Ohio 44035
Phone (440) 365-4730
Fax (440) 365-4790
mailroom@ksassoc.com
www.ksassoc.com

SURVEY MAP

OF PART OF
AVON TOWNSHIP ORIGINAL SECTION NO. 8
CITY OF AVON LAKE COUNTY OF LORAIN STATE OF OHIO

SHEET 1 OF 1

JOB NO. 04033

R:\04CCO\04033\LDOT\control\dwg\O-BOUNDARY01.dwg 06/02/2004 09:50:29 AM EDT