01-00-004-C

#18365

07-00-004-106

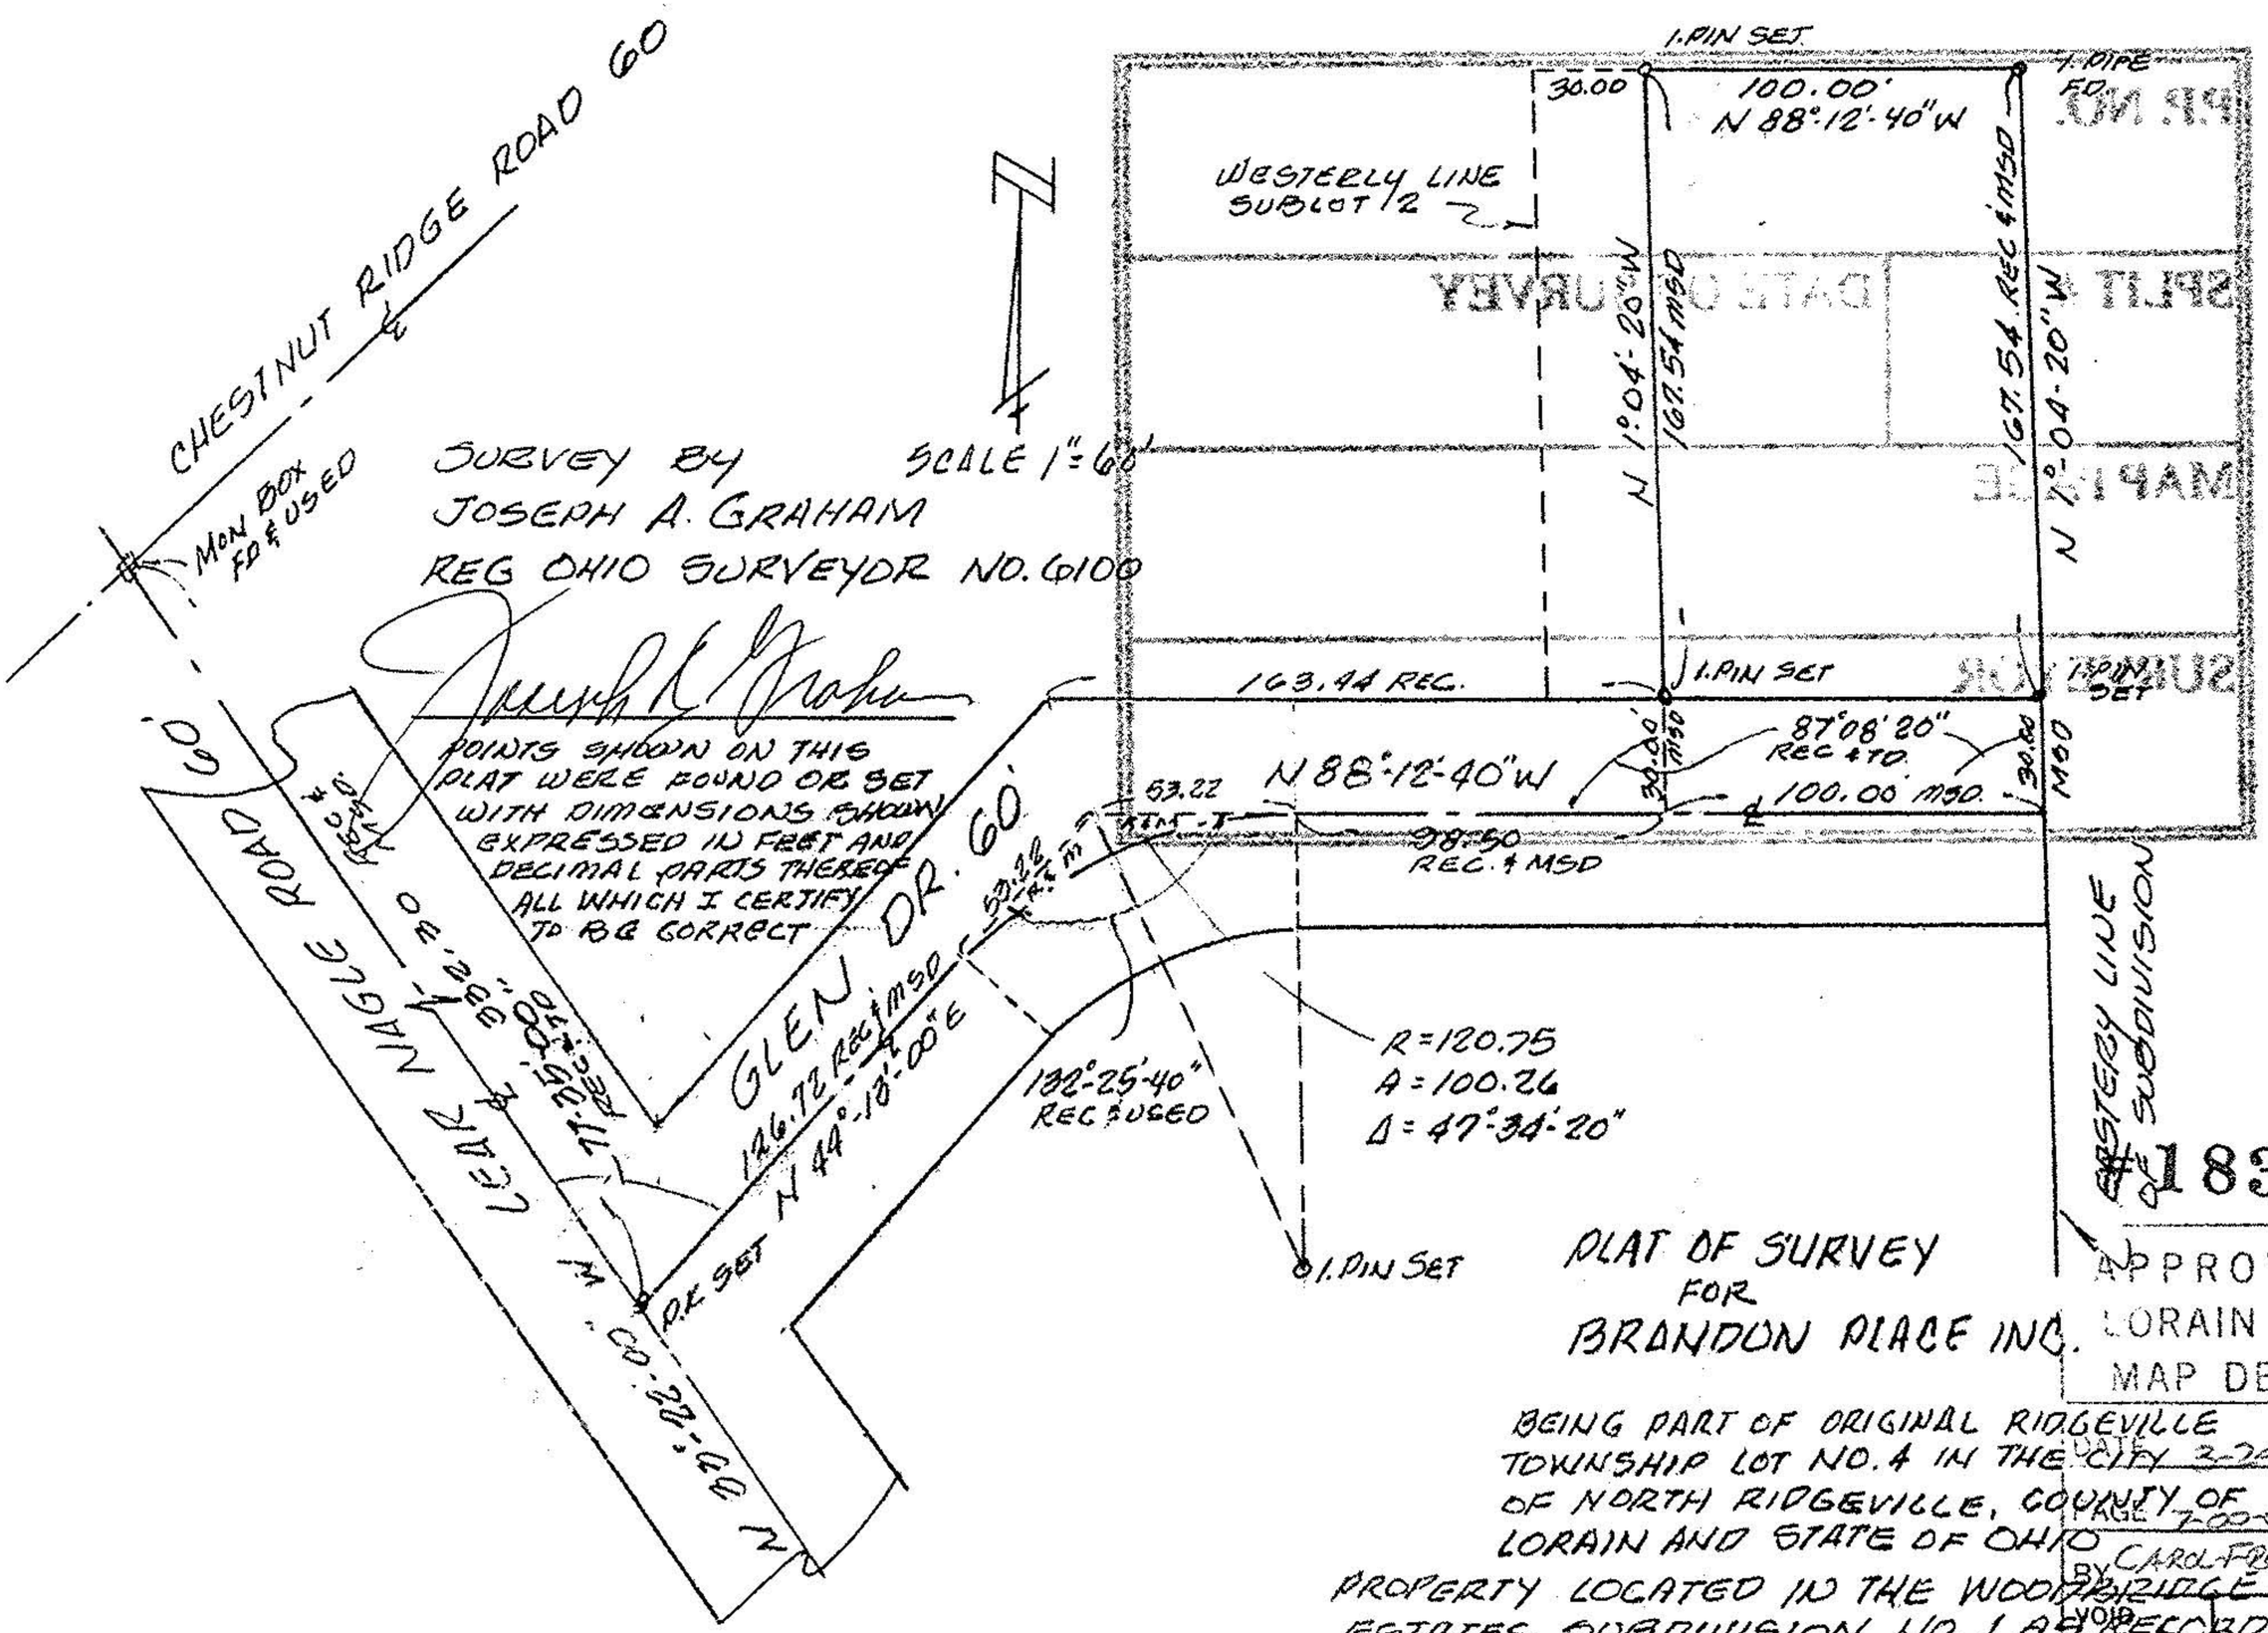

#18365

PLAT OF SURVEY
FOR
BRANDON PLACE INC.

BEING PART OF ORIGINAL RIDGEVILLE TOWNSHIP LOT NO. 4 IN THE CITY OF NORTH RIDGEVILLE, COUNTY OF LORAIN AND STATE OF OHIO

PROPERTY LOCATED IN THE WOODBRIDGE ESTATES SUBDIVISION NO. 1 AS RECORDED IN VOL 21 PG. 6 OF L.C.R.

APPROVED
LORAIN CO.
MAP DEPT.
DATE 3-24-89
PAGE 7-00-004-C
BY CAROL FRANCIS
VOID
ACTION #18365