


FEDERATED ENGINEERS DESIGNERS 34100 center ridge road north ridgeville, ohio 44039 (216)327-6211 or 777-9616

Builder _____ Block No. _____
 Subdivision _____ Address MILLS INDUSTRIAL PARKWAY
 City NORTH RIDGEVILLE Scale 1" = 200' 47.3
 Sublot No. _____ Date 2/5/81
 P.P.No. _____ Drawn By JM

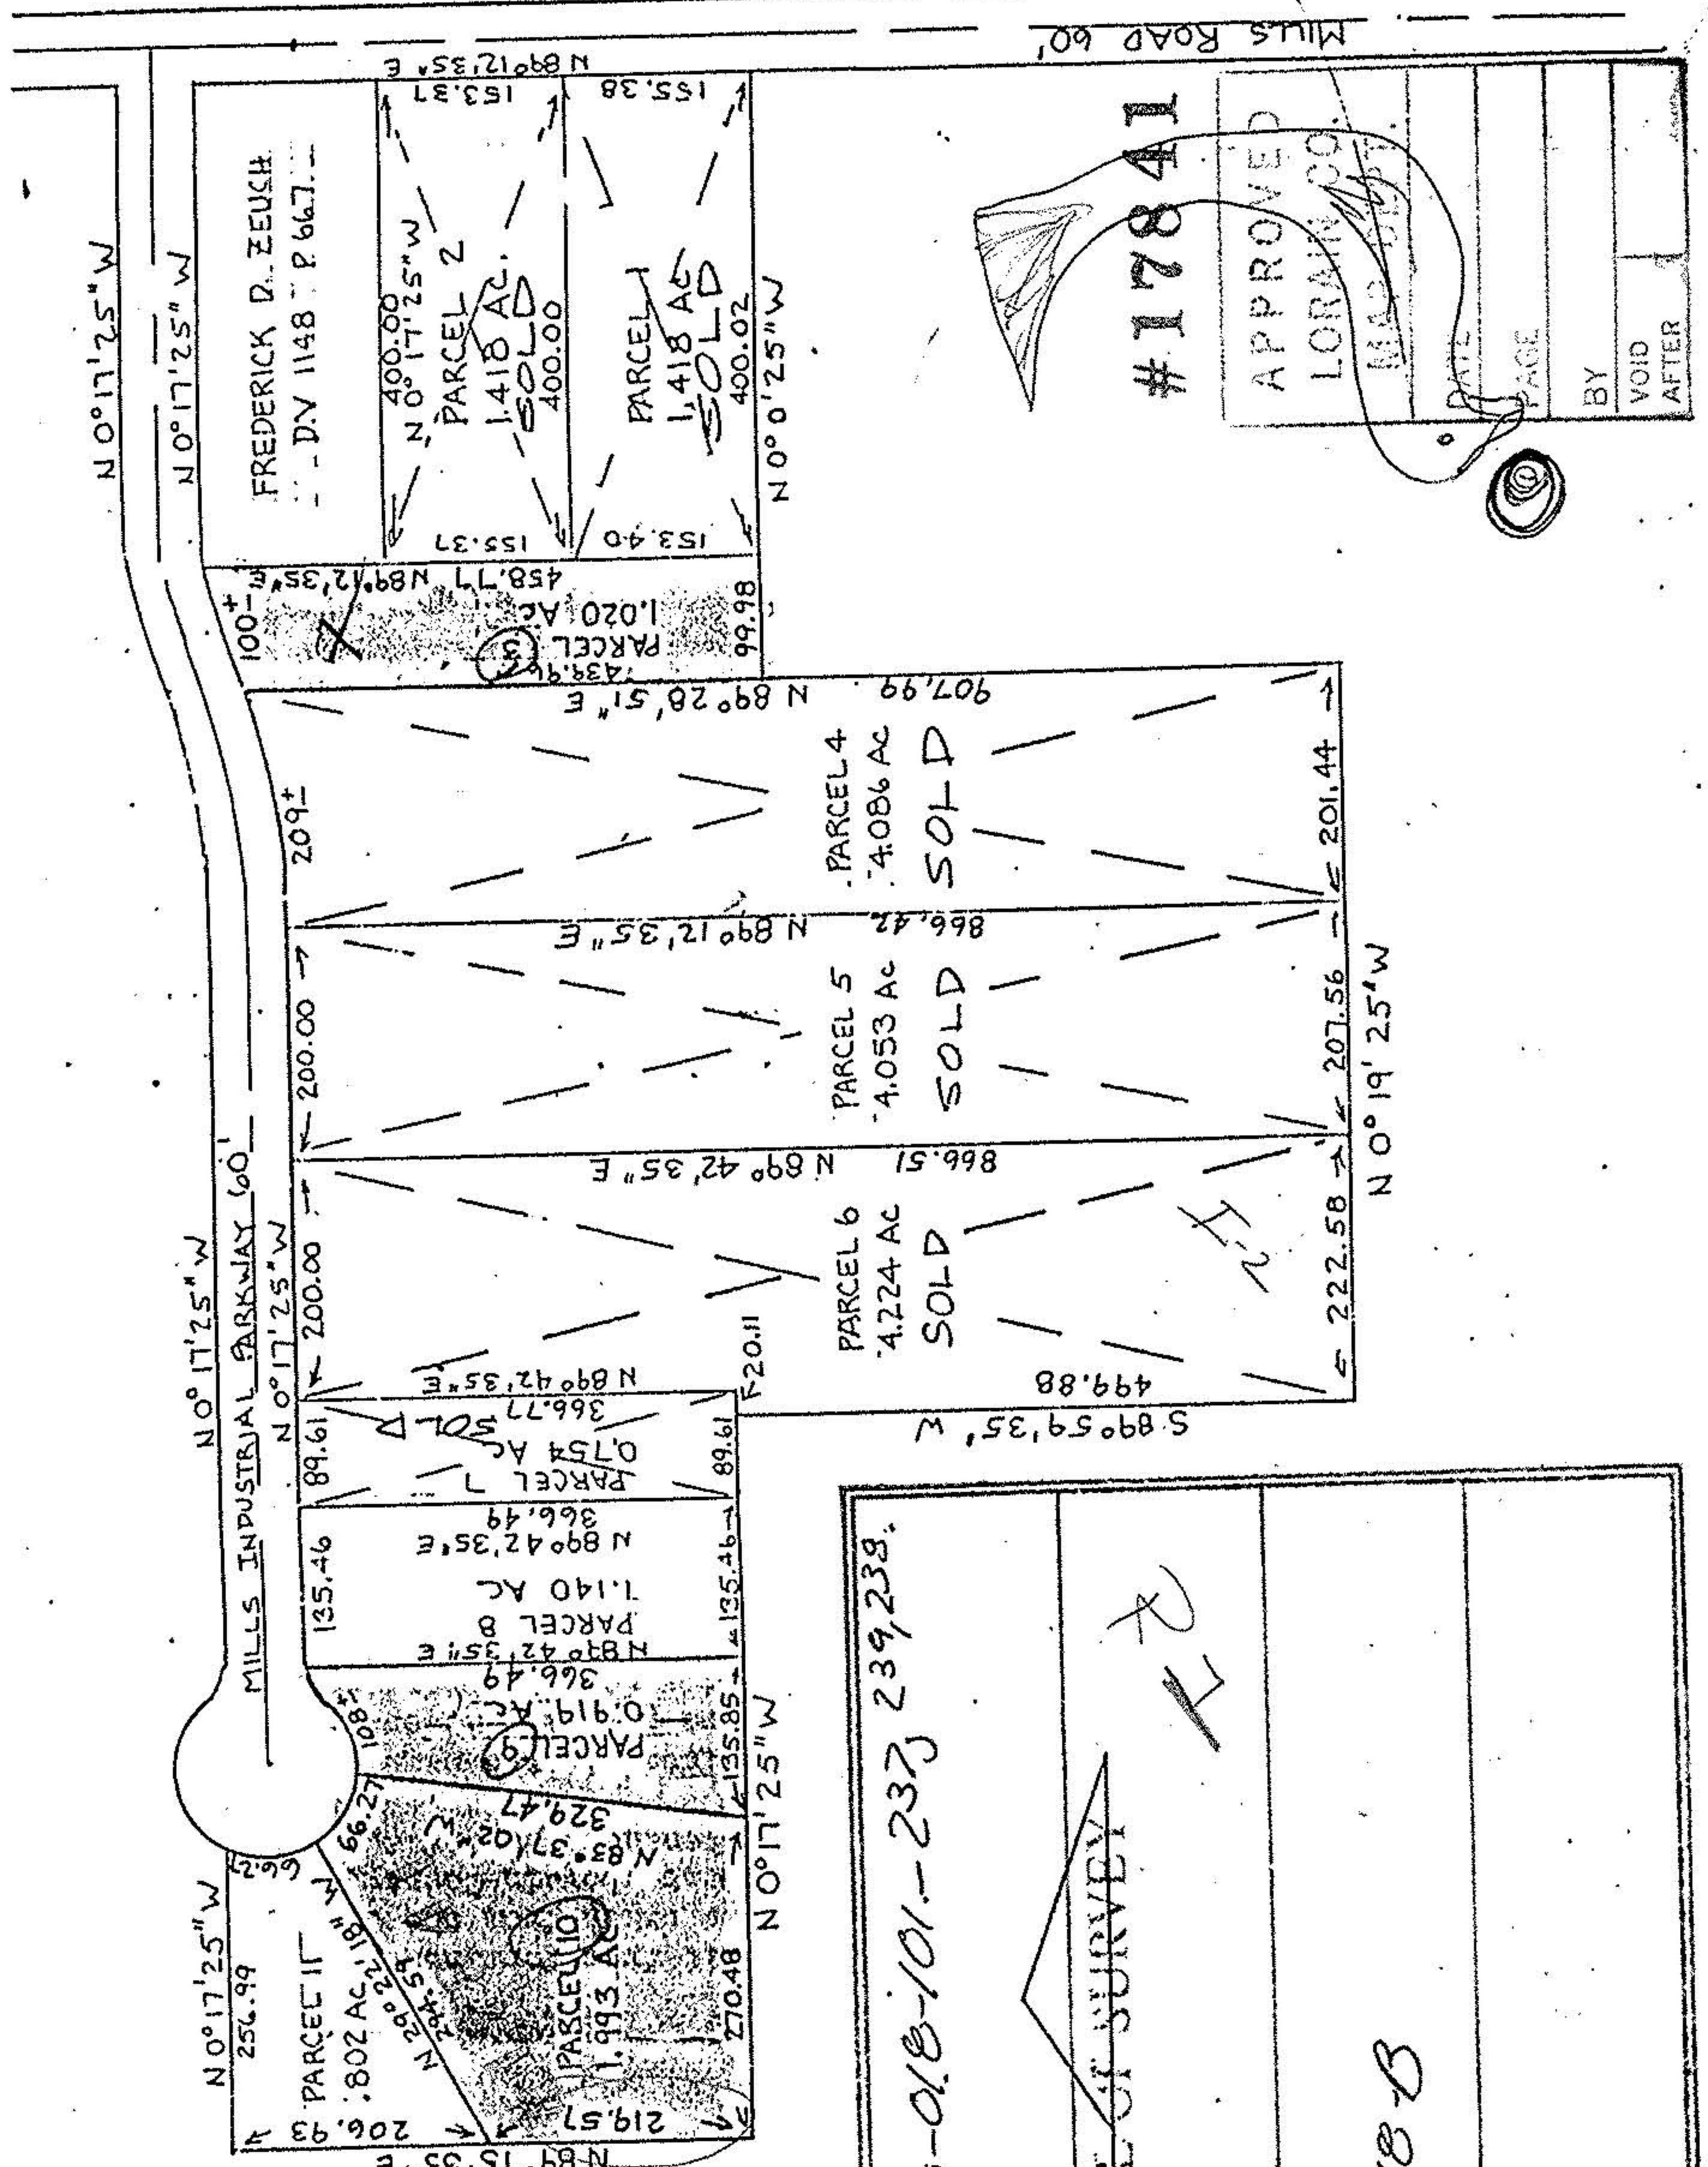

RECEIVED
 JUN 15 1987
 1ST NATIONAL BANK
 CORPORATE HQ-CLEVELAND

Distances Missing

P.P. NO. 07-00-018-101-237 239,238
 SPLIT #. 17841
 MAP PAGE 7-00-018-B
 SURVEYOR _____

07-00-018