


# HAPONEK & ASSOCIATES, INC.

Engineers & Surveyors  
34100 Center Ridge Road  
NORTH RIDGEVILLE, OHIO 44039  
(216) 327-4776 Lorain 288-4400


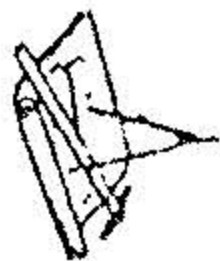


VACANT LAND



DATE: JAN 1988  
SCALE: 1"=100'

TWINSBURG-ELYRIA RD S.R. 82 60'

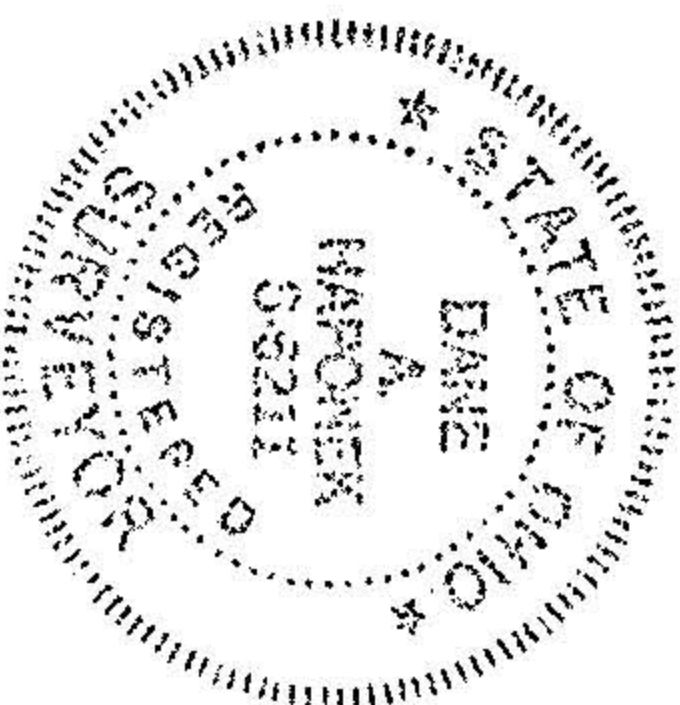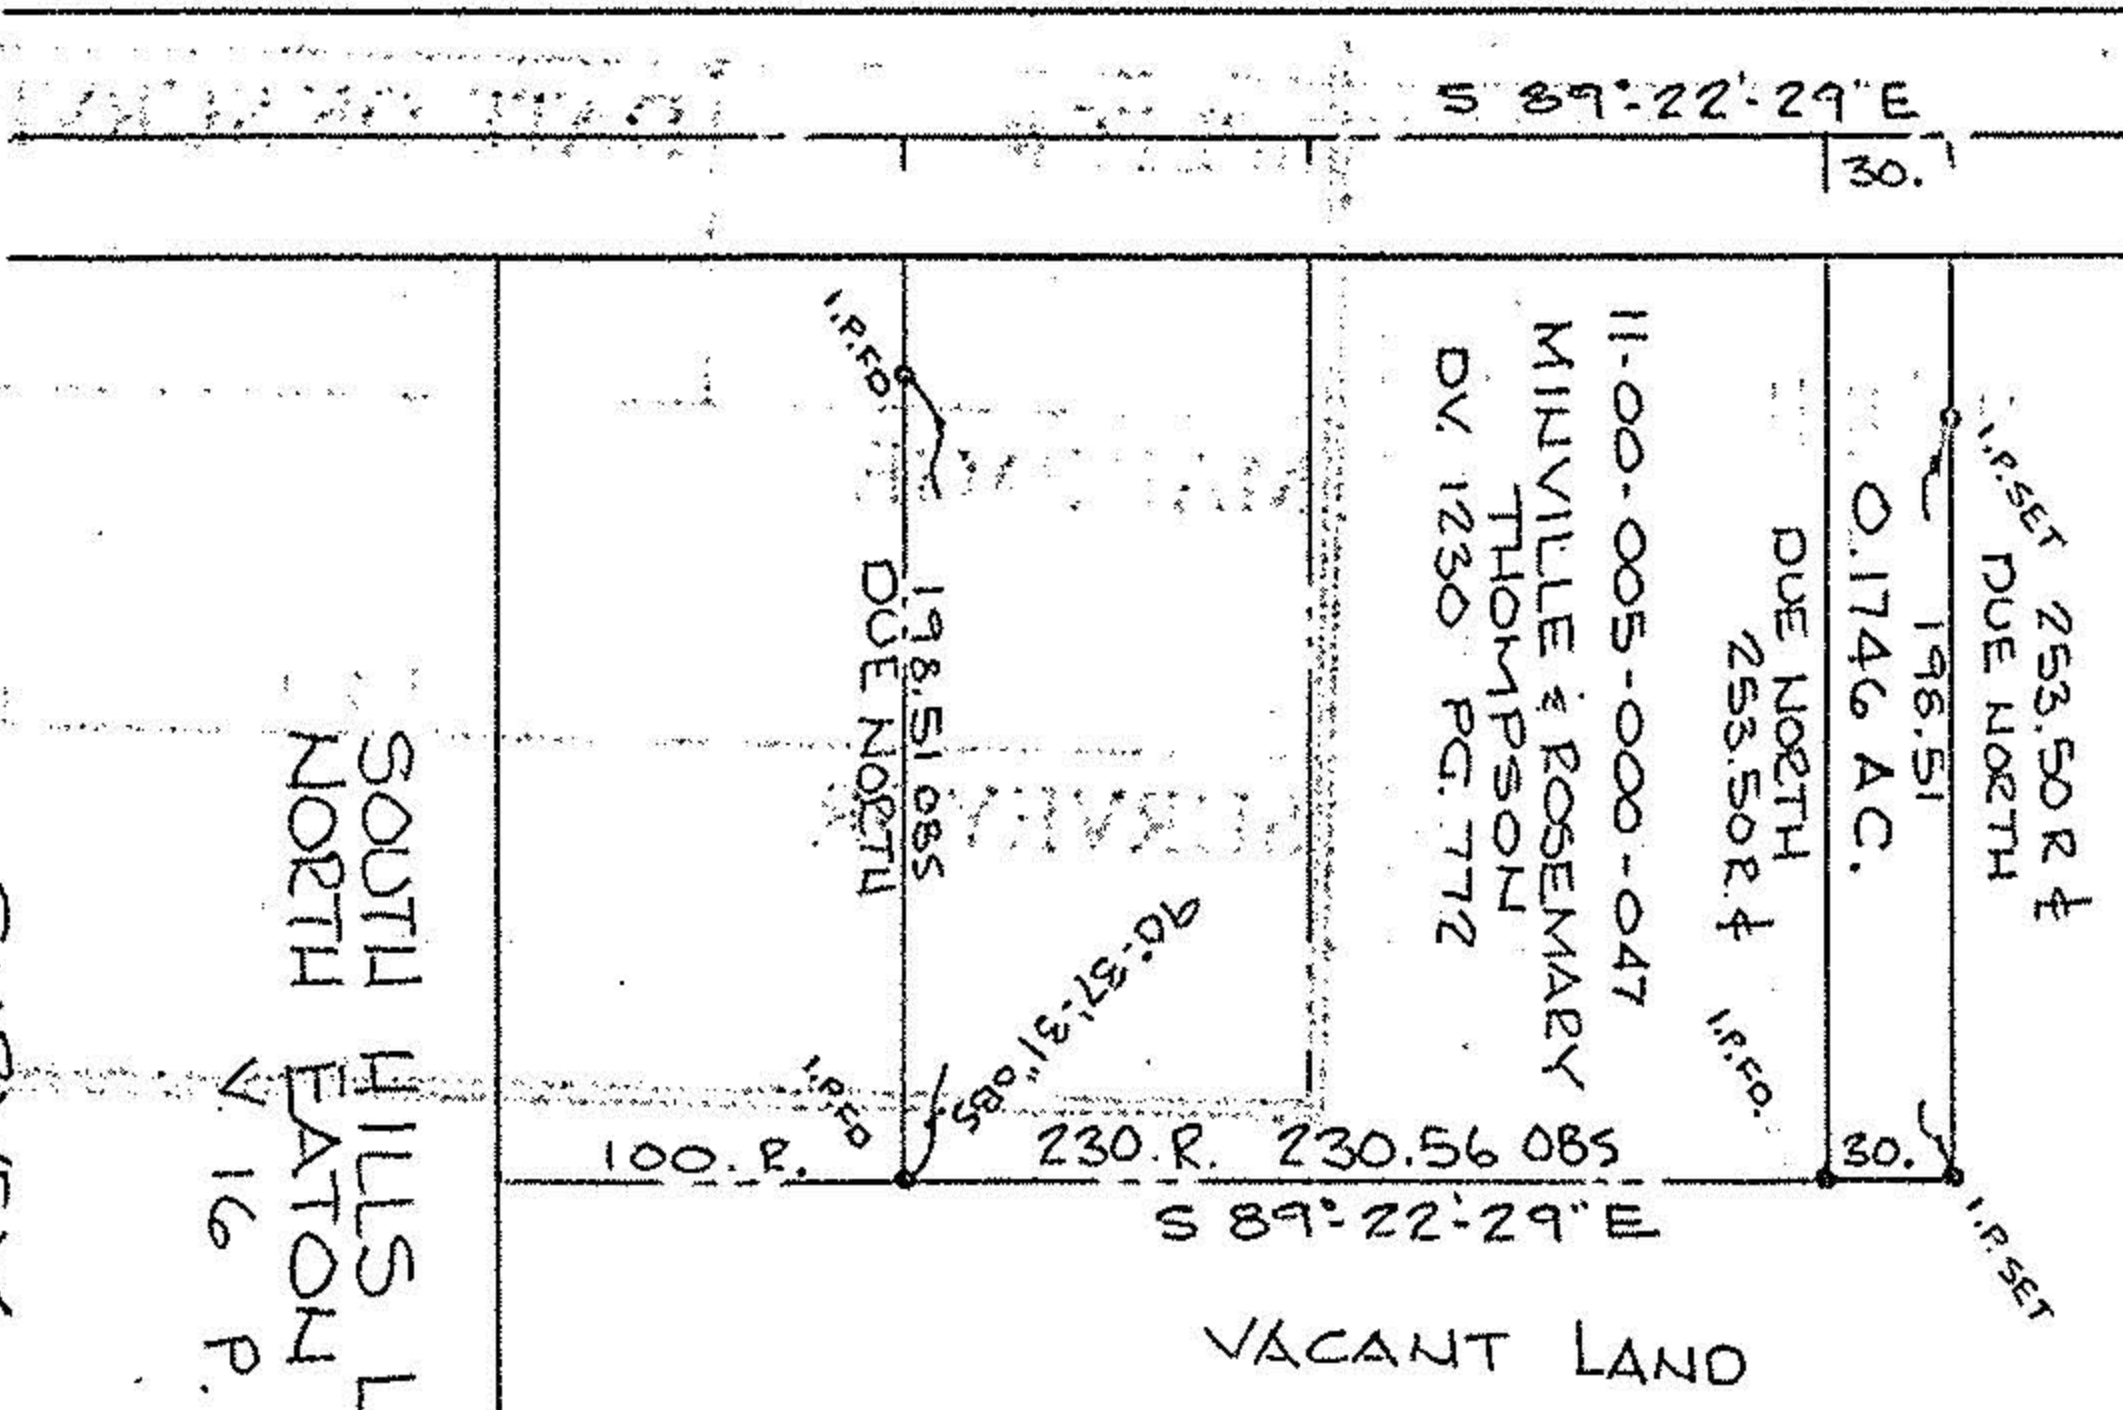

## #18206

APPROVED
LORAIN CO.
MAP DEPT.
DATE 11-10-88
PAGE 11-H
BY T-McLain
VOID AFTER 18206

SURVEY  
OF PART OF  
ORIGINAL LOT NO. 5 EATON TWP.  
TWP. OF EATON COUNTY OF LORAIN  
STATE OF OHIO

SOUTH HILLS LAND CO'S  
NORTH EATON FARMS SUBJ  
V 16 P. 20

PREPARED FOR:

CARPENTER FARMS, INC. (ALLEN CARPENTER)  
1794 BROKAW RD.  
COLUMBIA STATION, O 44028