LAUNDON • SIMON • CAHL & ASSOC., INC.
CONSULTING ENGINEERS & SURVEYORS
110[illegible] MIDDLE AVE., ELYRIA, O. 44035

SURVEY FOR:

CECELIA VEGA

Orig. Lot 3	City of	Date JAN. '92 Scale 1"=100'
Orig. Sec	Village of	Dwn. by R.G.S. Chkd. by R.C.
Tract	County of LORAIN	Job No. 92-2141 F.B.
Township of EATON	State of OHIO	Printed JAN 15 1992

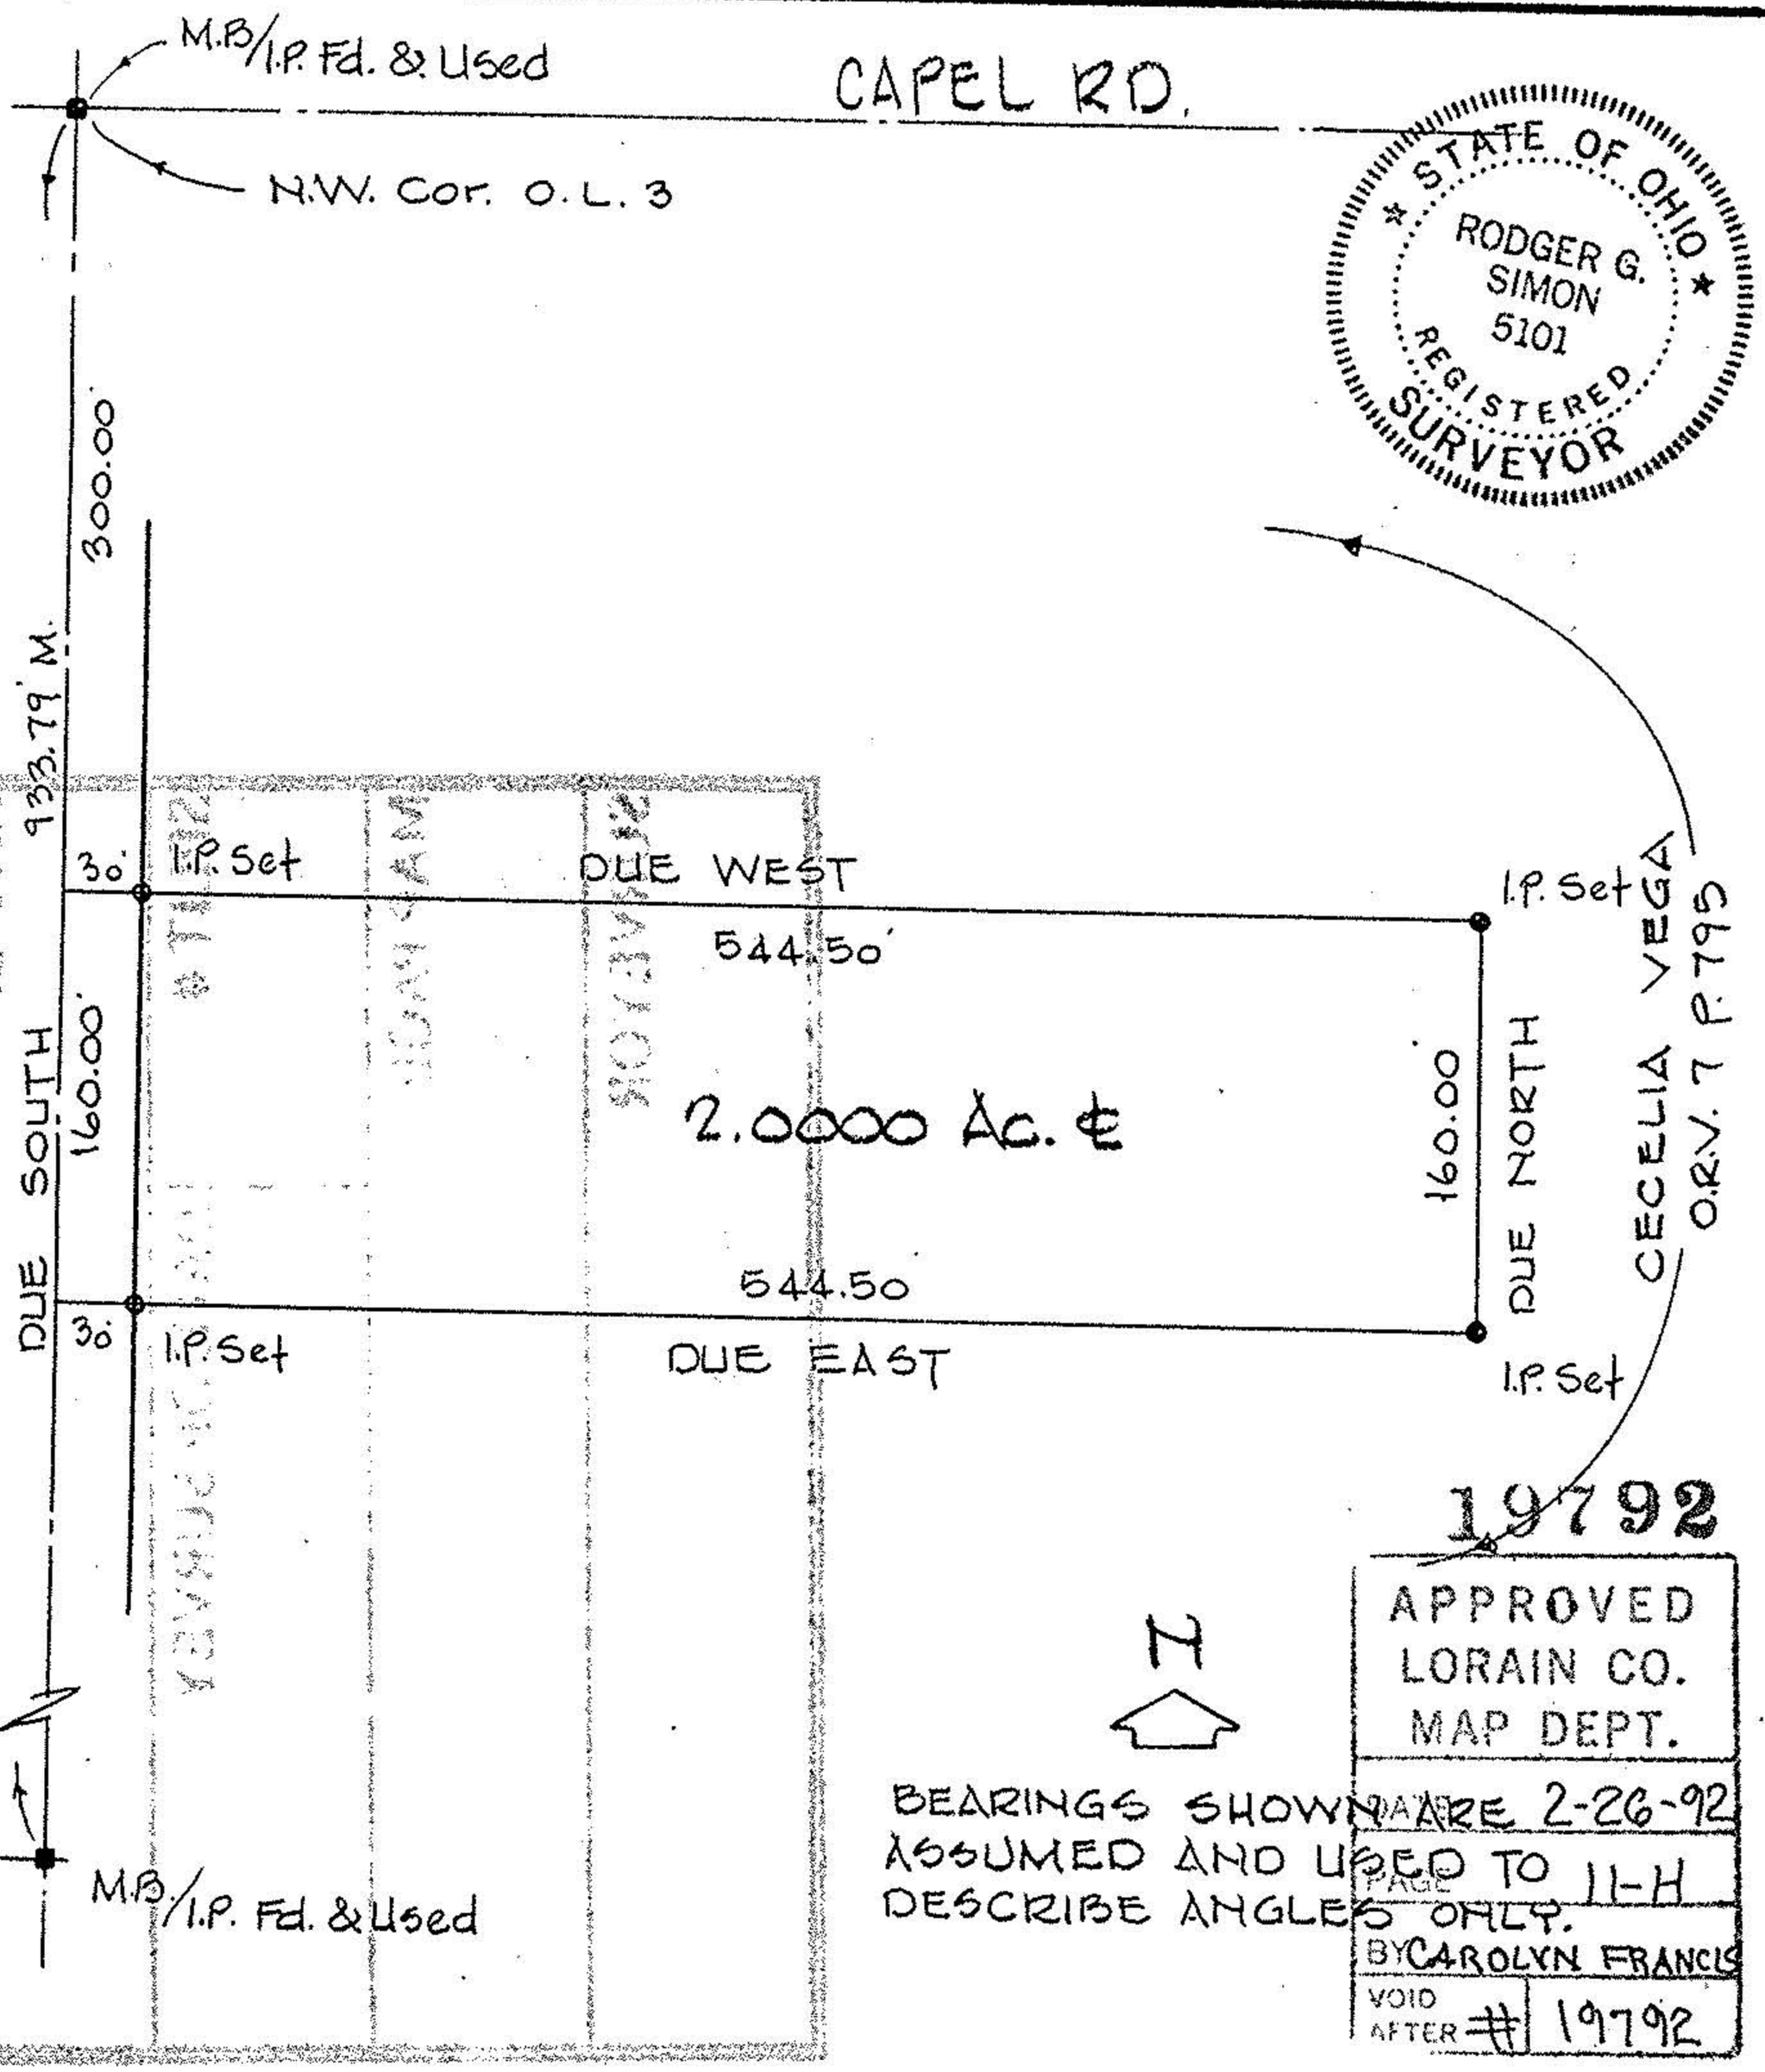

19792

APPROVED
LORAIN CO.
MAP DEPT.
DATE 2-26-92
PAGE 11-H
BY CAROLYN FRANCIS
VOID AFTER # 19792

19792

11-00-008 - 00