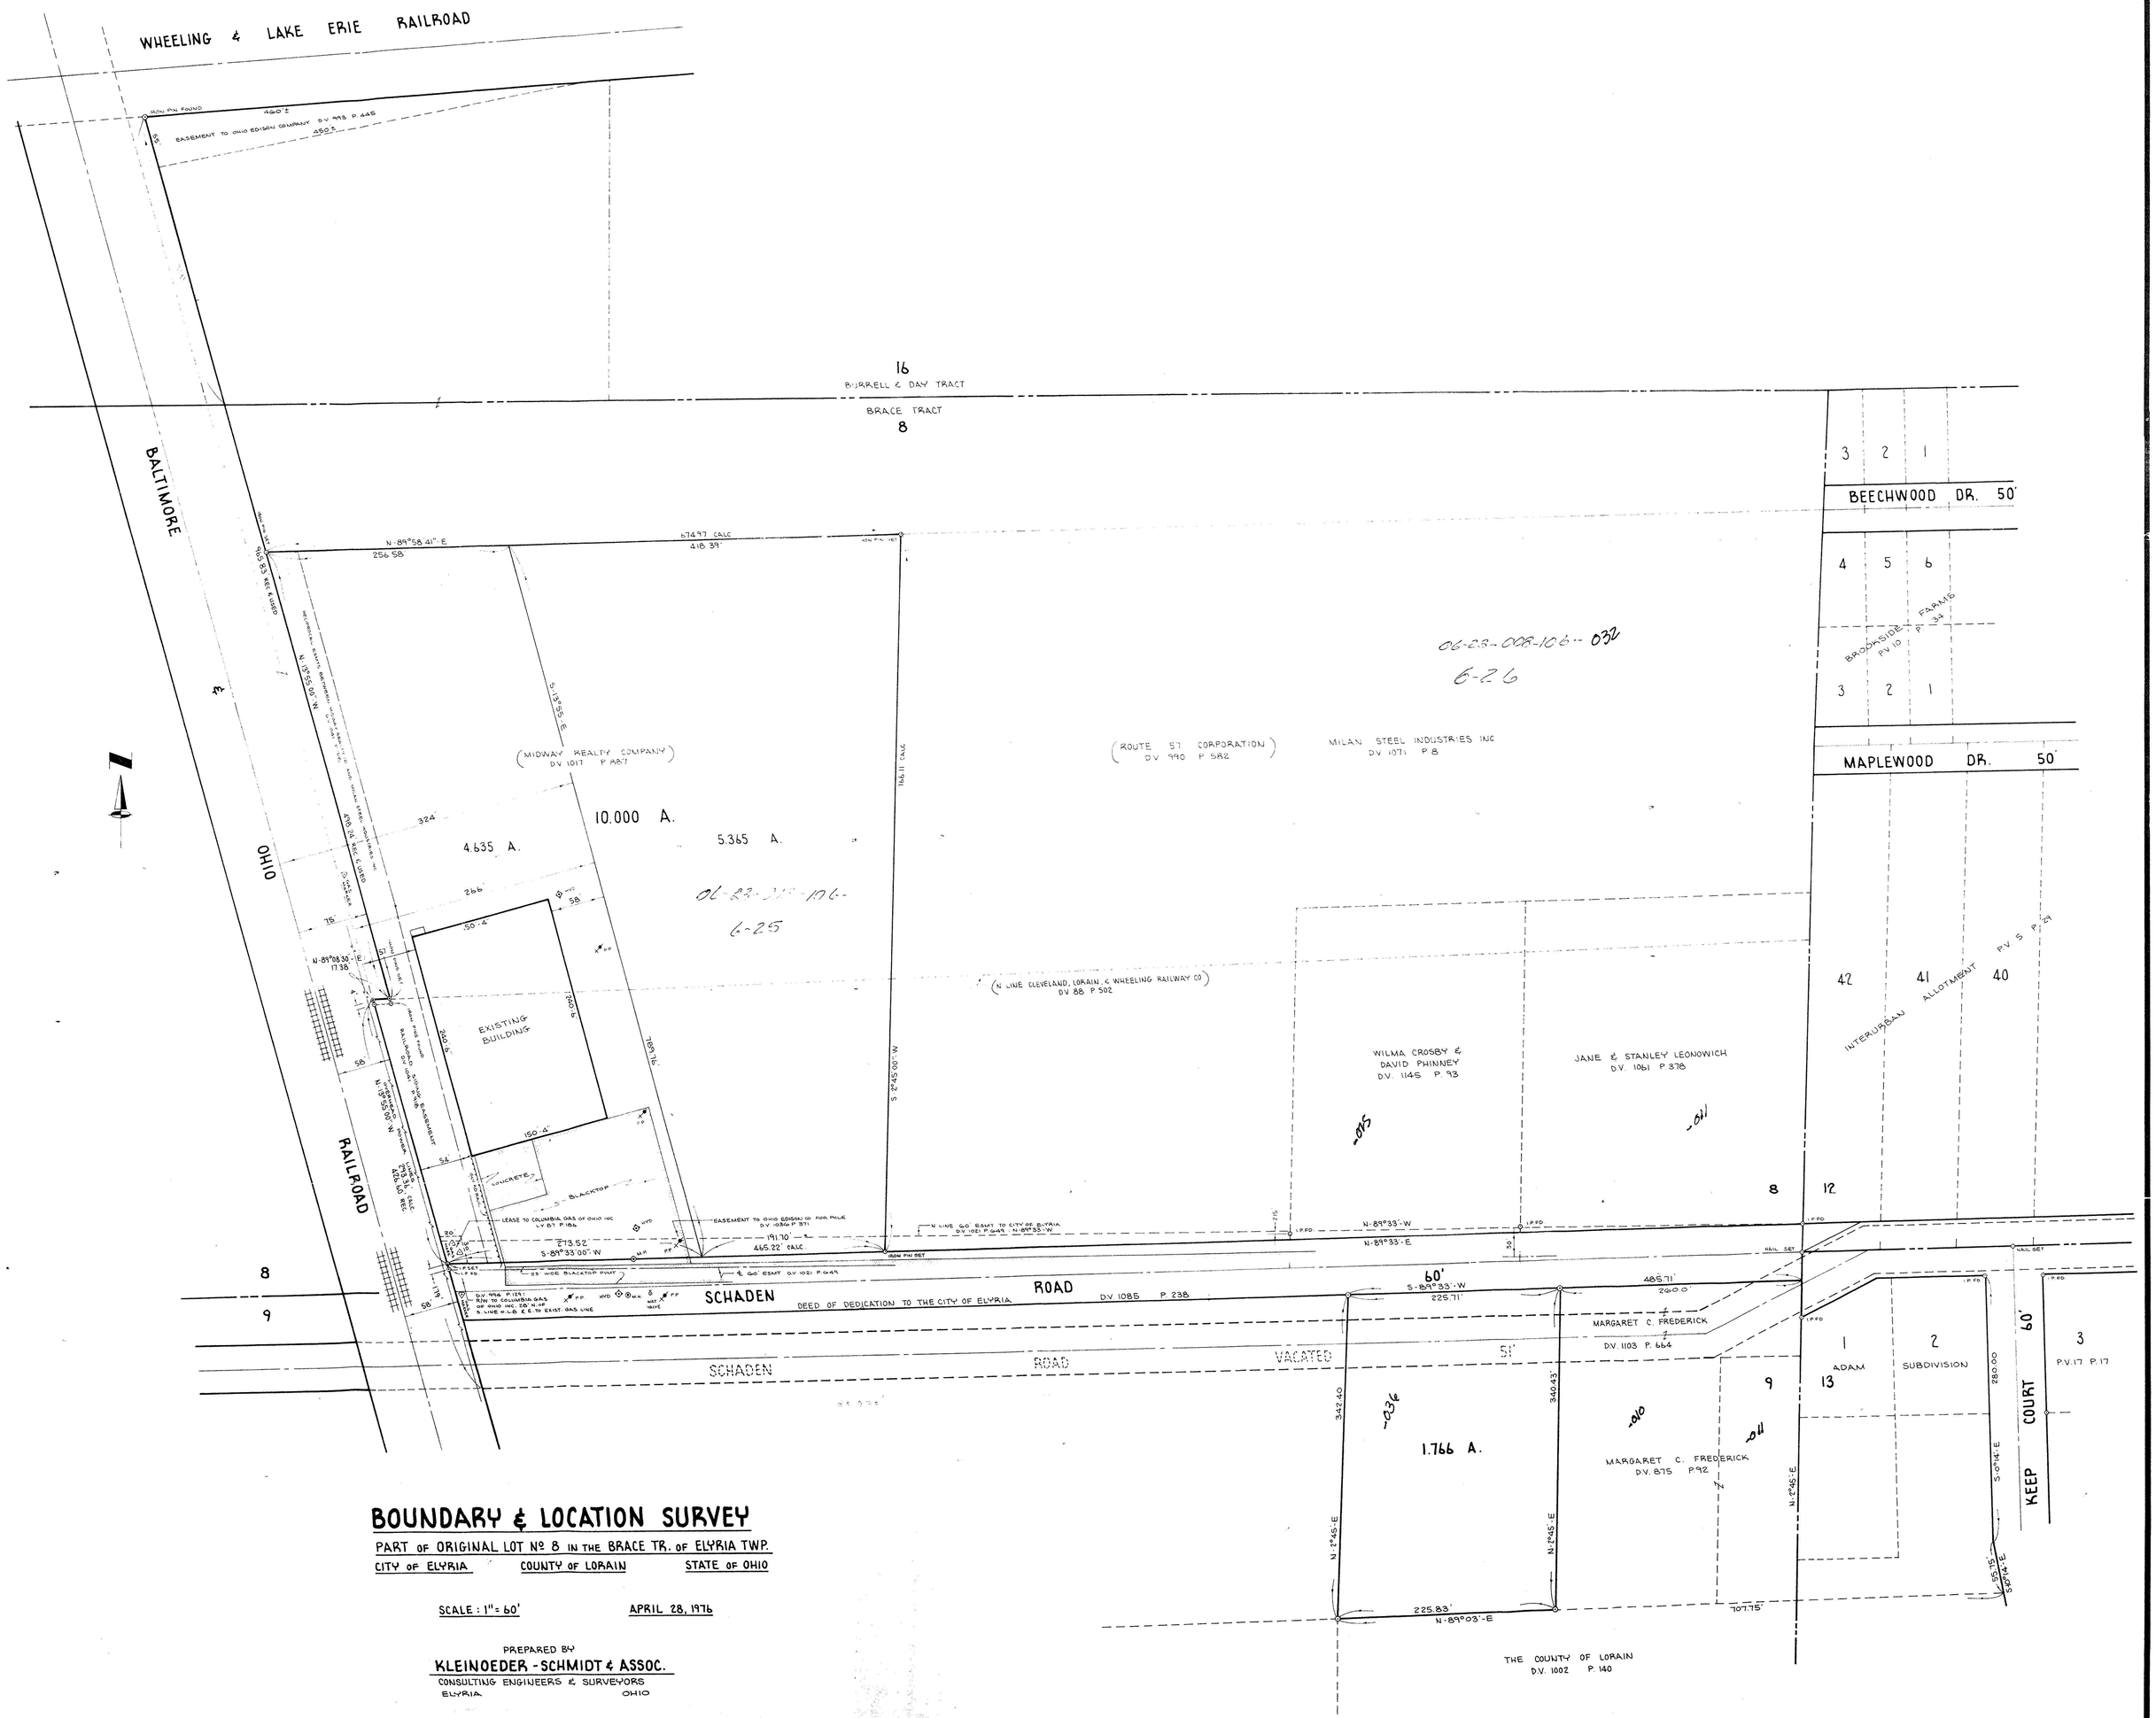

BOUNDARY & LOCATION SURVEY

PART OF ORIGINAL LOT Nº 8 IN THE BRACE TR. OF ELYRIA TWP.

CITY OF ELYRIA COUNTY OF LORAIN STATE OF OHIO

SCALE: 1" = 60' APRIL 28, 1976

PREPARED BY

KLEINOEDER - SCHMIDT & ASSOC.

CONSULTING ENGINEERS & SURVEYORS

ELYRIA OHIO