-209

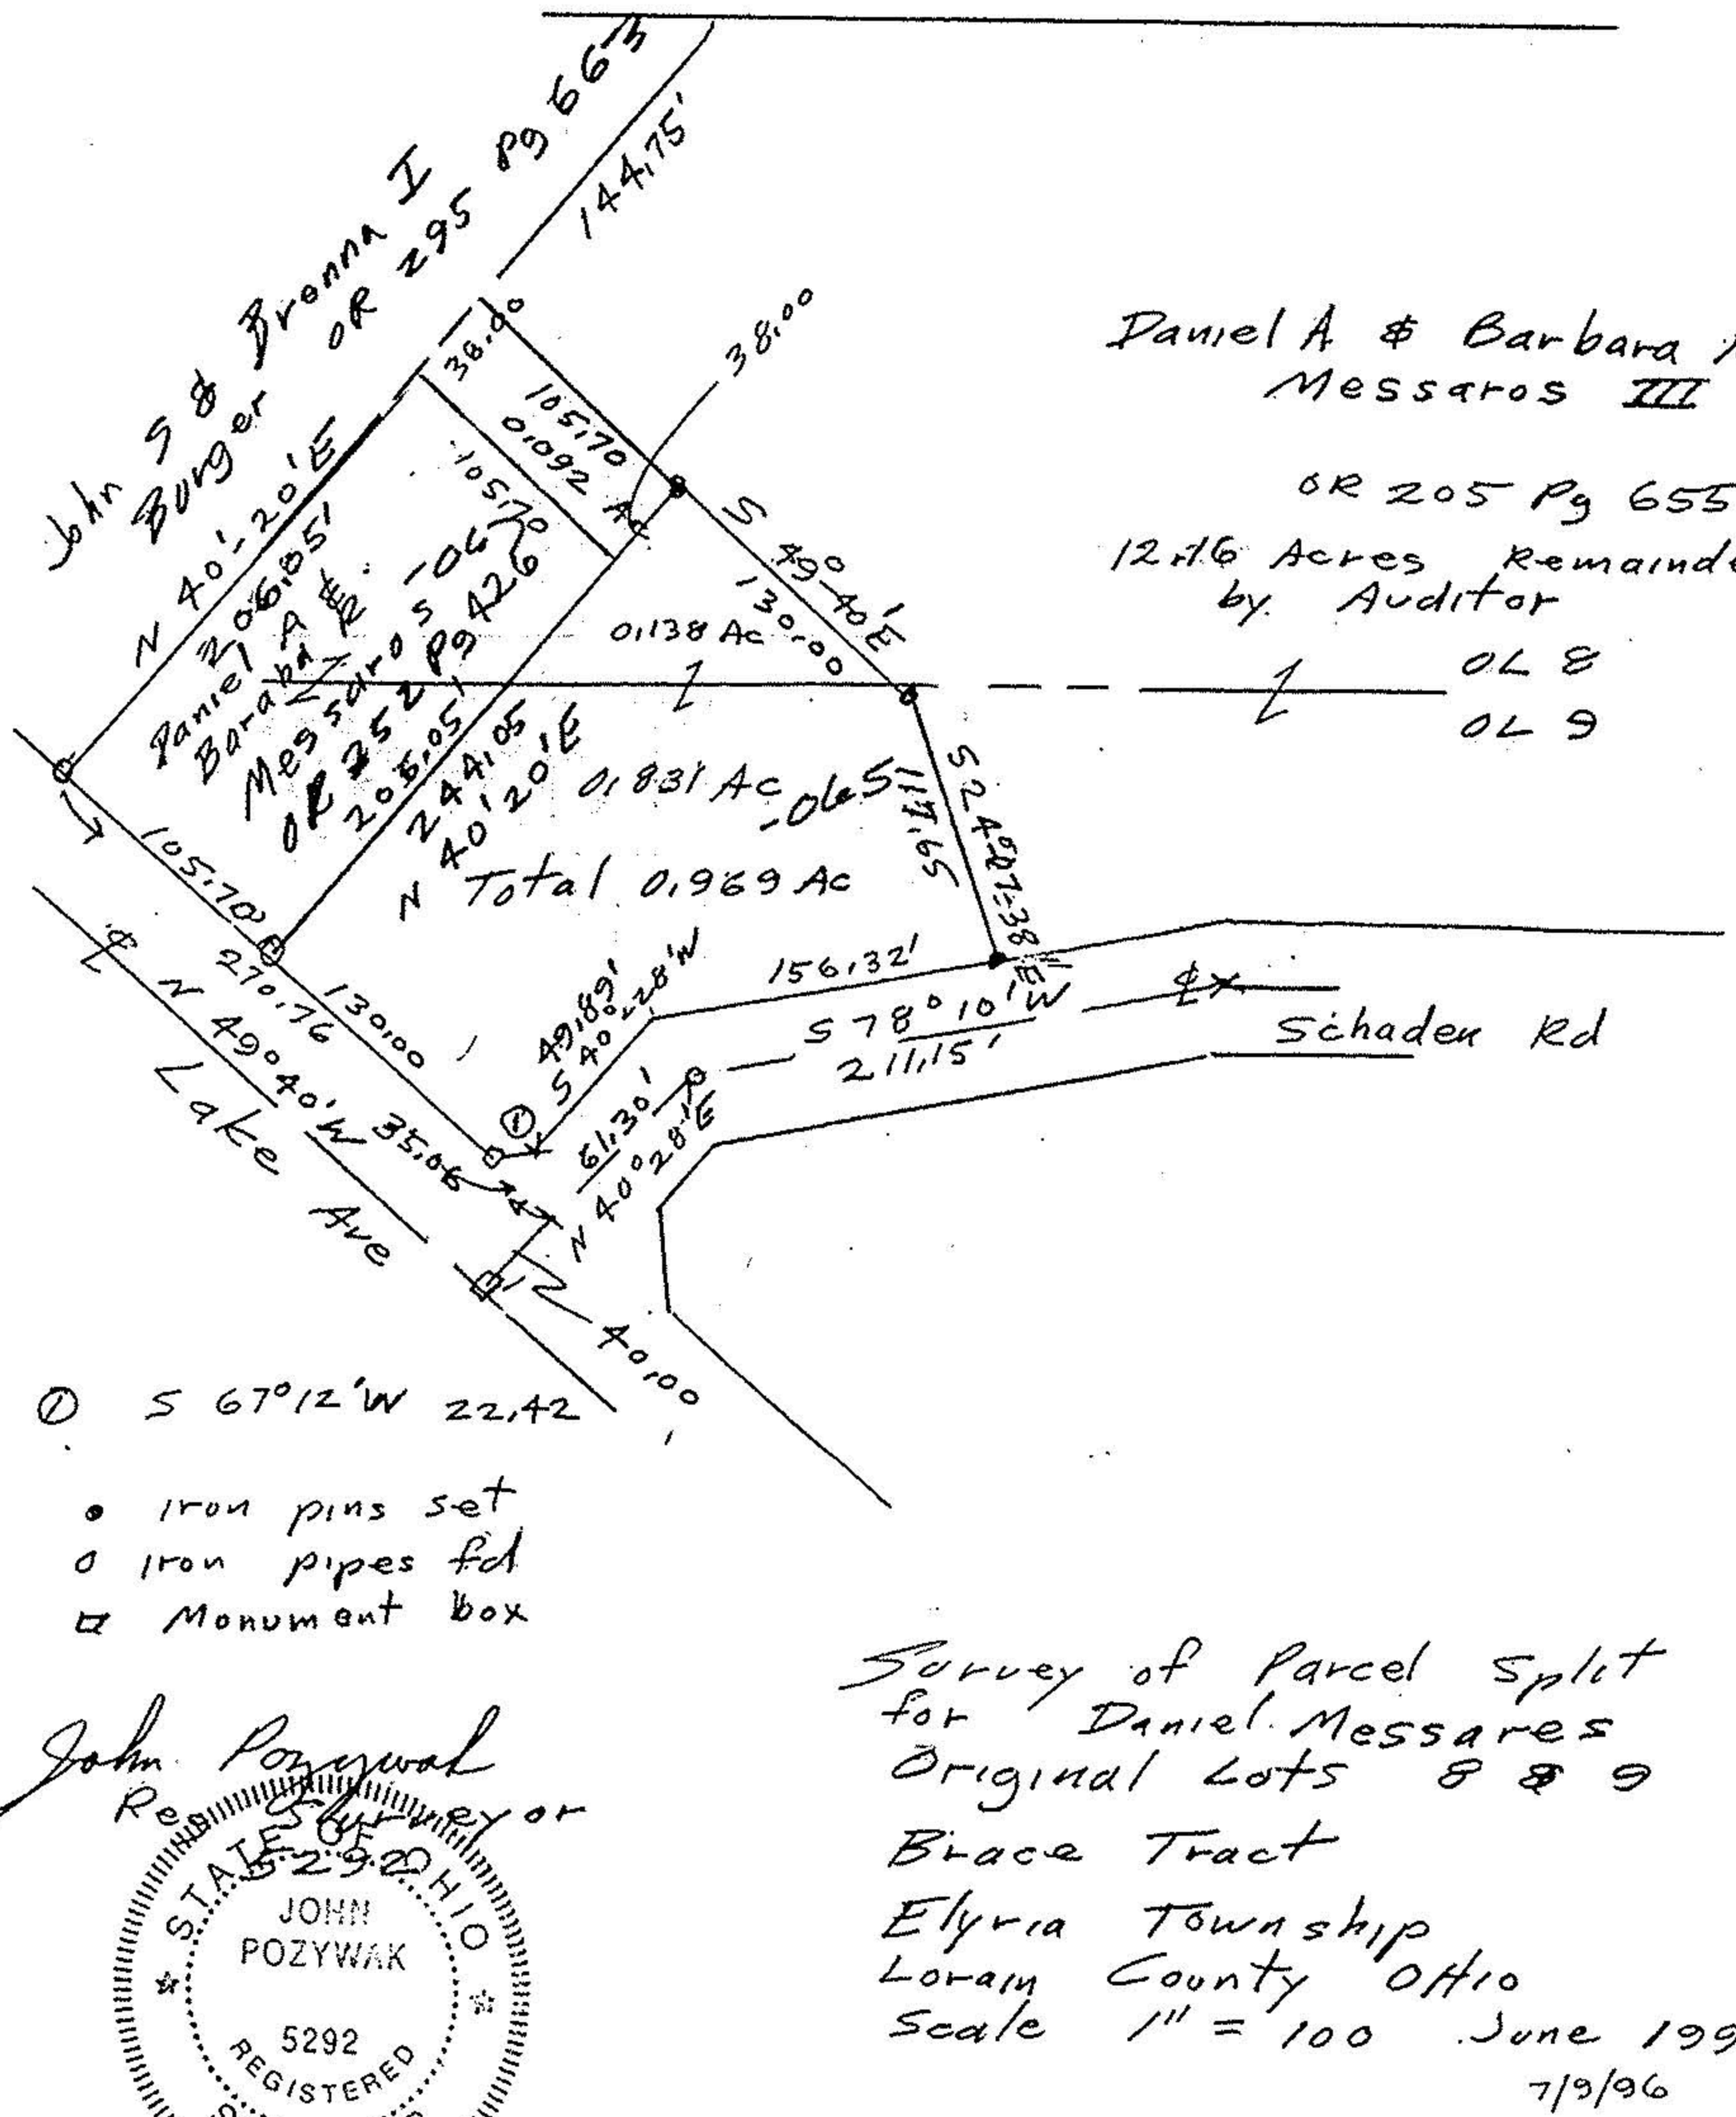

① S 67°12'W 22.42

- • Iron pins set
- o Iron pipes fd
- □ Monument box

John Pozywak
Registered Surveyor

STATE OF OHIO
JOHN POZYWAK
5292
REGISTERED SURVEYOR
5-29-20

Survey of Parcel Split
for Daniel Messares
Original Lots 8 & 9
Black Tract
Elyria Township
Lorain County Ohio
Scale 1" = 100 June 1996
7/9/96